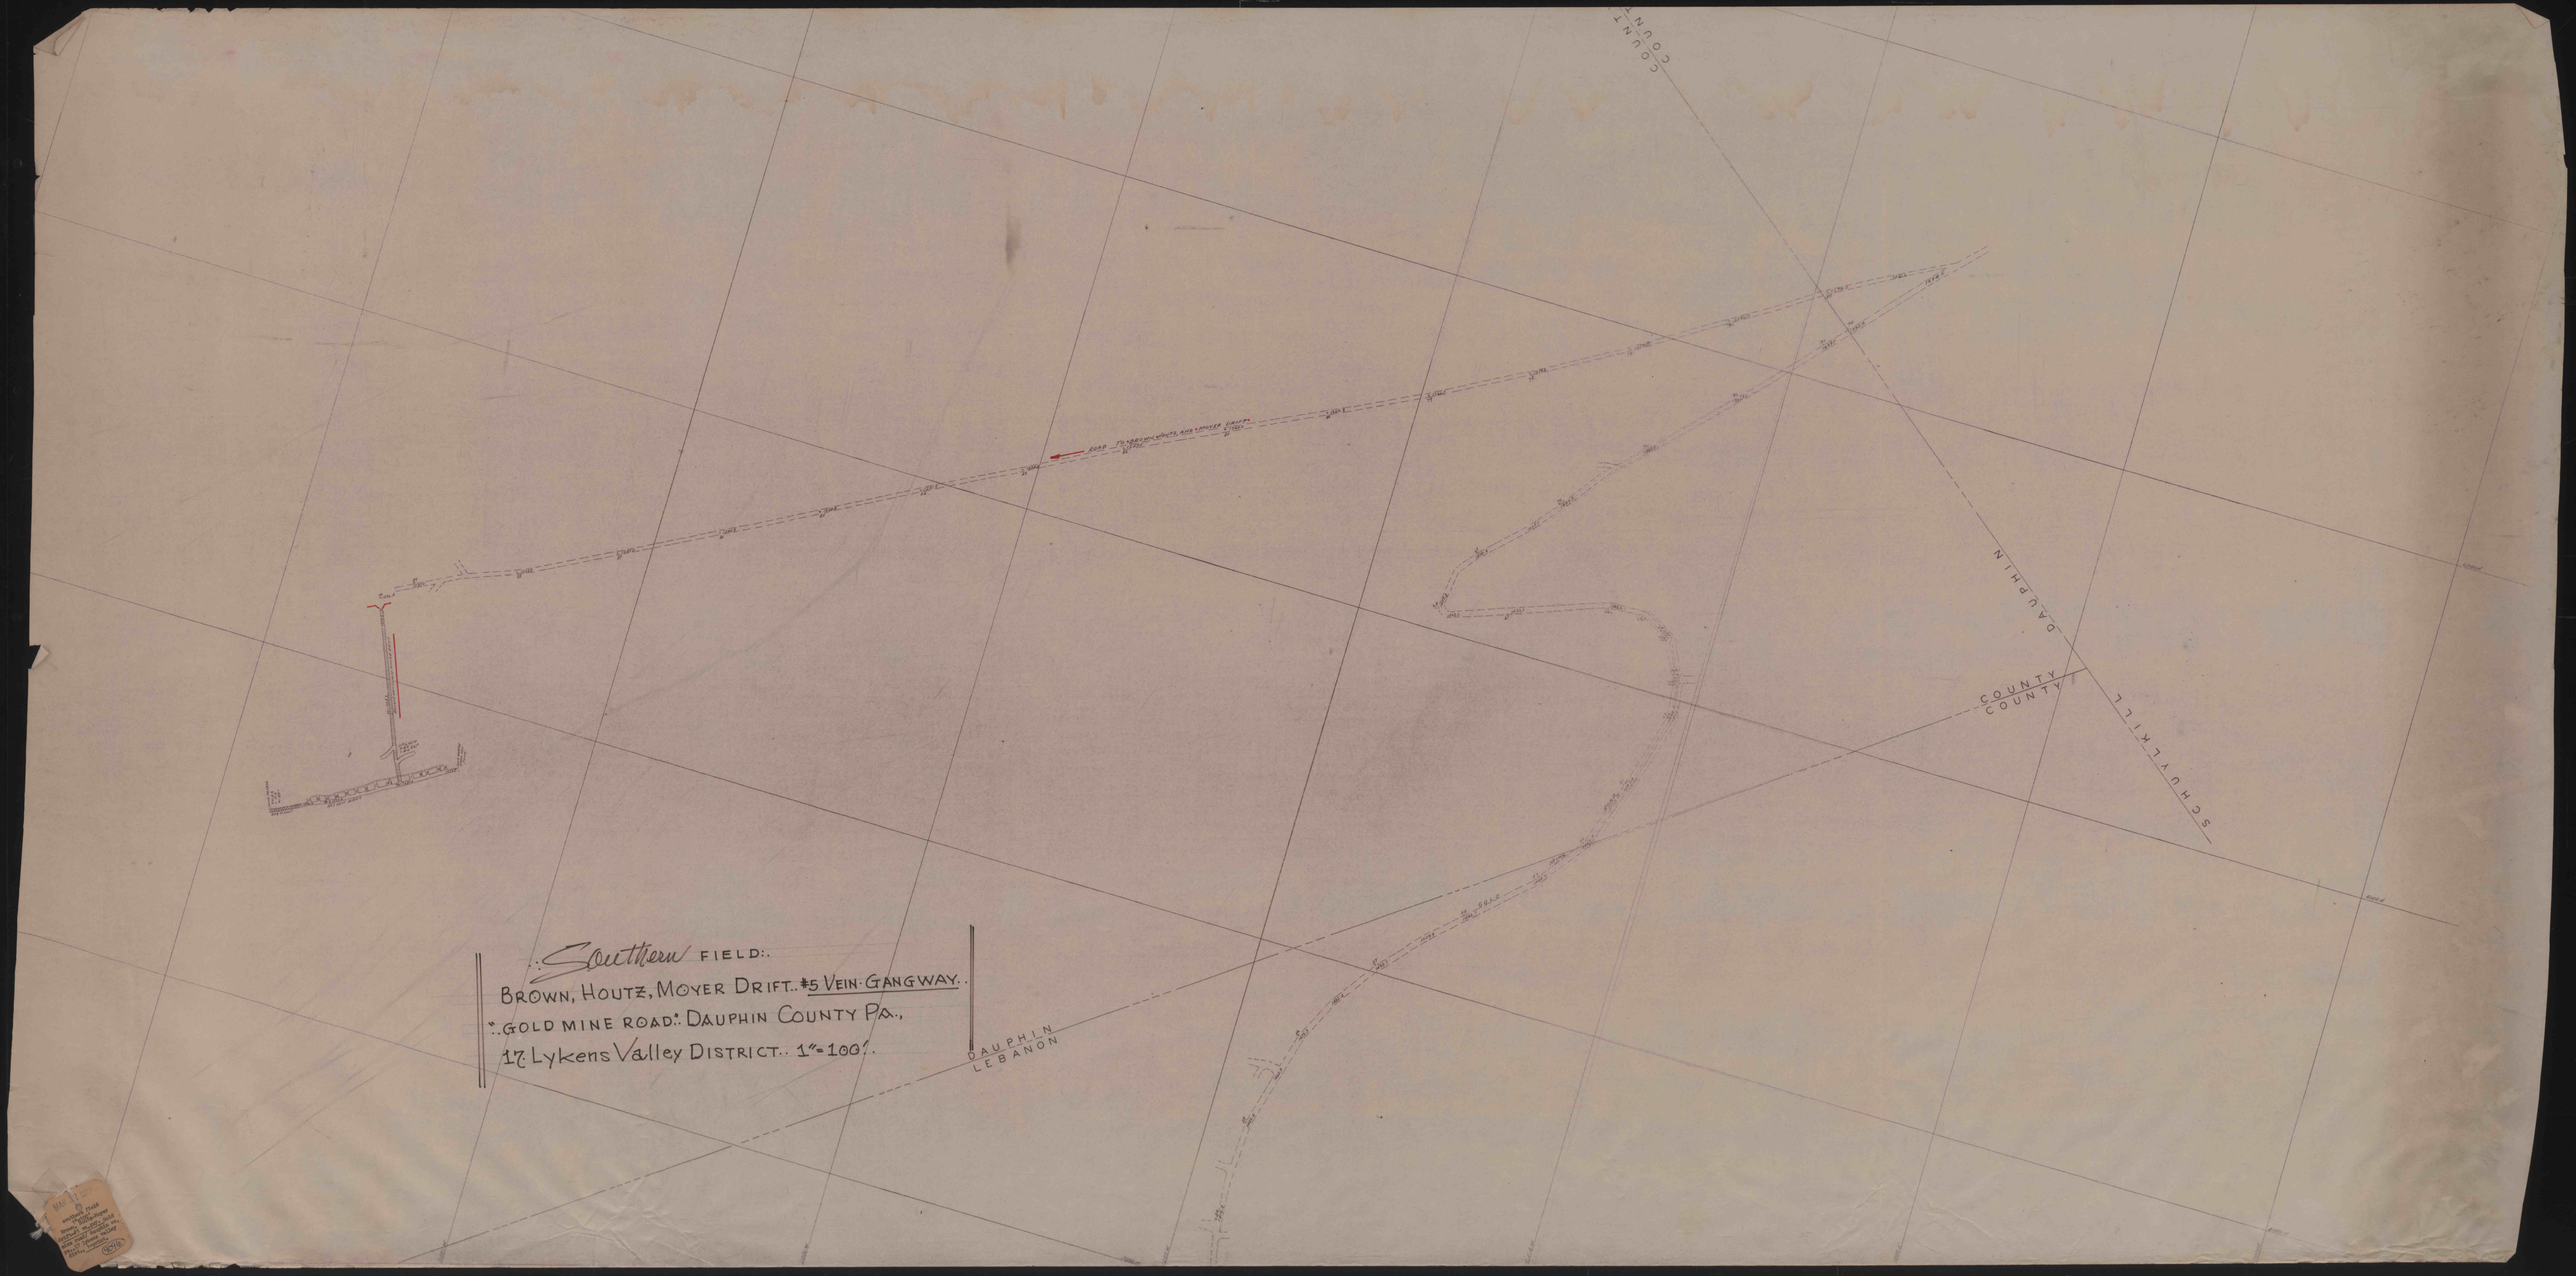
Southern FIELD:
BROWN, HOUTZ, MOYER DRIFT. #5 VEIN GANGWAY.
GOLD MINE ROAD: DAUPHIN COUNTY PA.,
17 Lykens Valley DISTRICT. 1"=100'.
DAUPHIN
LEBANON
COUNTY
COUNTY
DAUPHIN
SCHUYLKILL