


4892
1941
Northern field
Loomis Coll.
Green Alden Co.
Lorens County
Wetmore game trap

BUTTONWOOD COLLIERY
No 4 VEIN
No 6
LOOMIS COLLIERY
No 5 VEIN

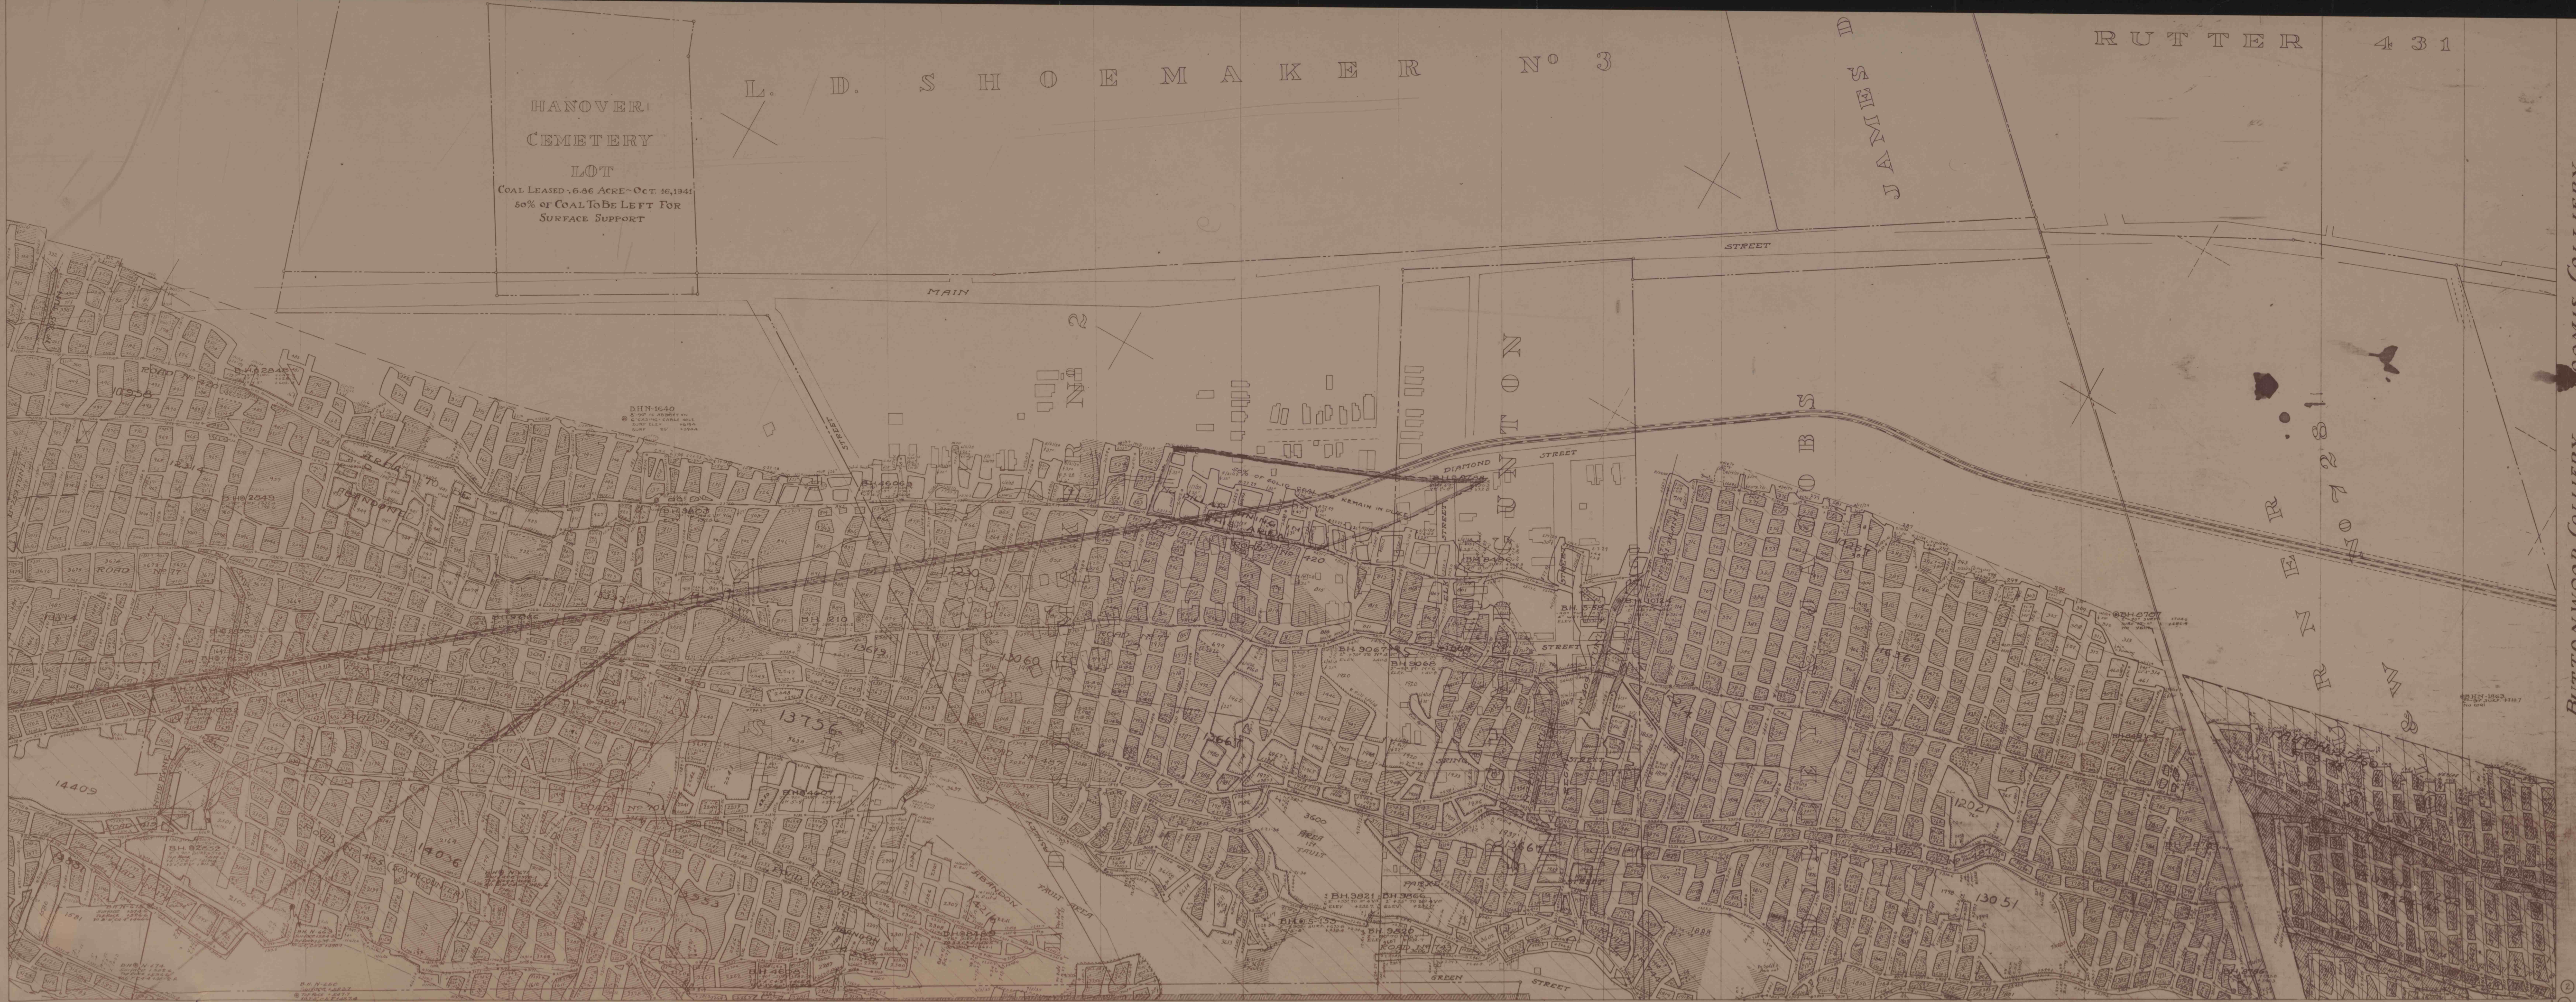

BUTTONWOOD COLLIERY
No 4 VEIN
No 6
LOOMIS COLLIERY
No 5 VEIN