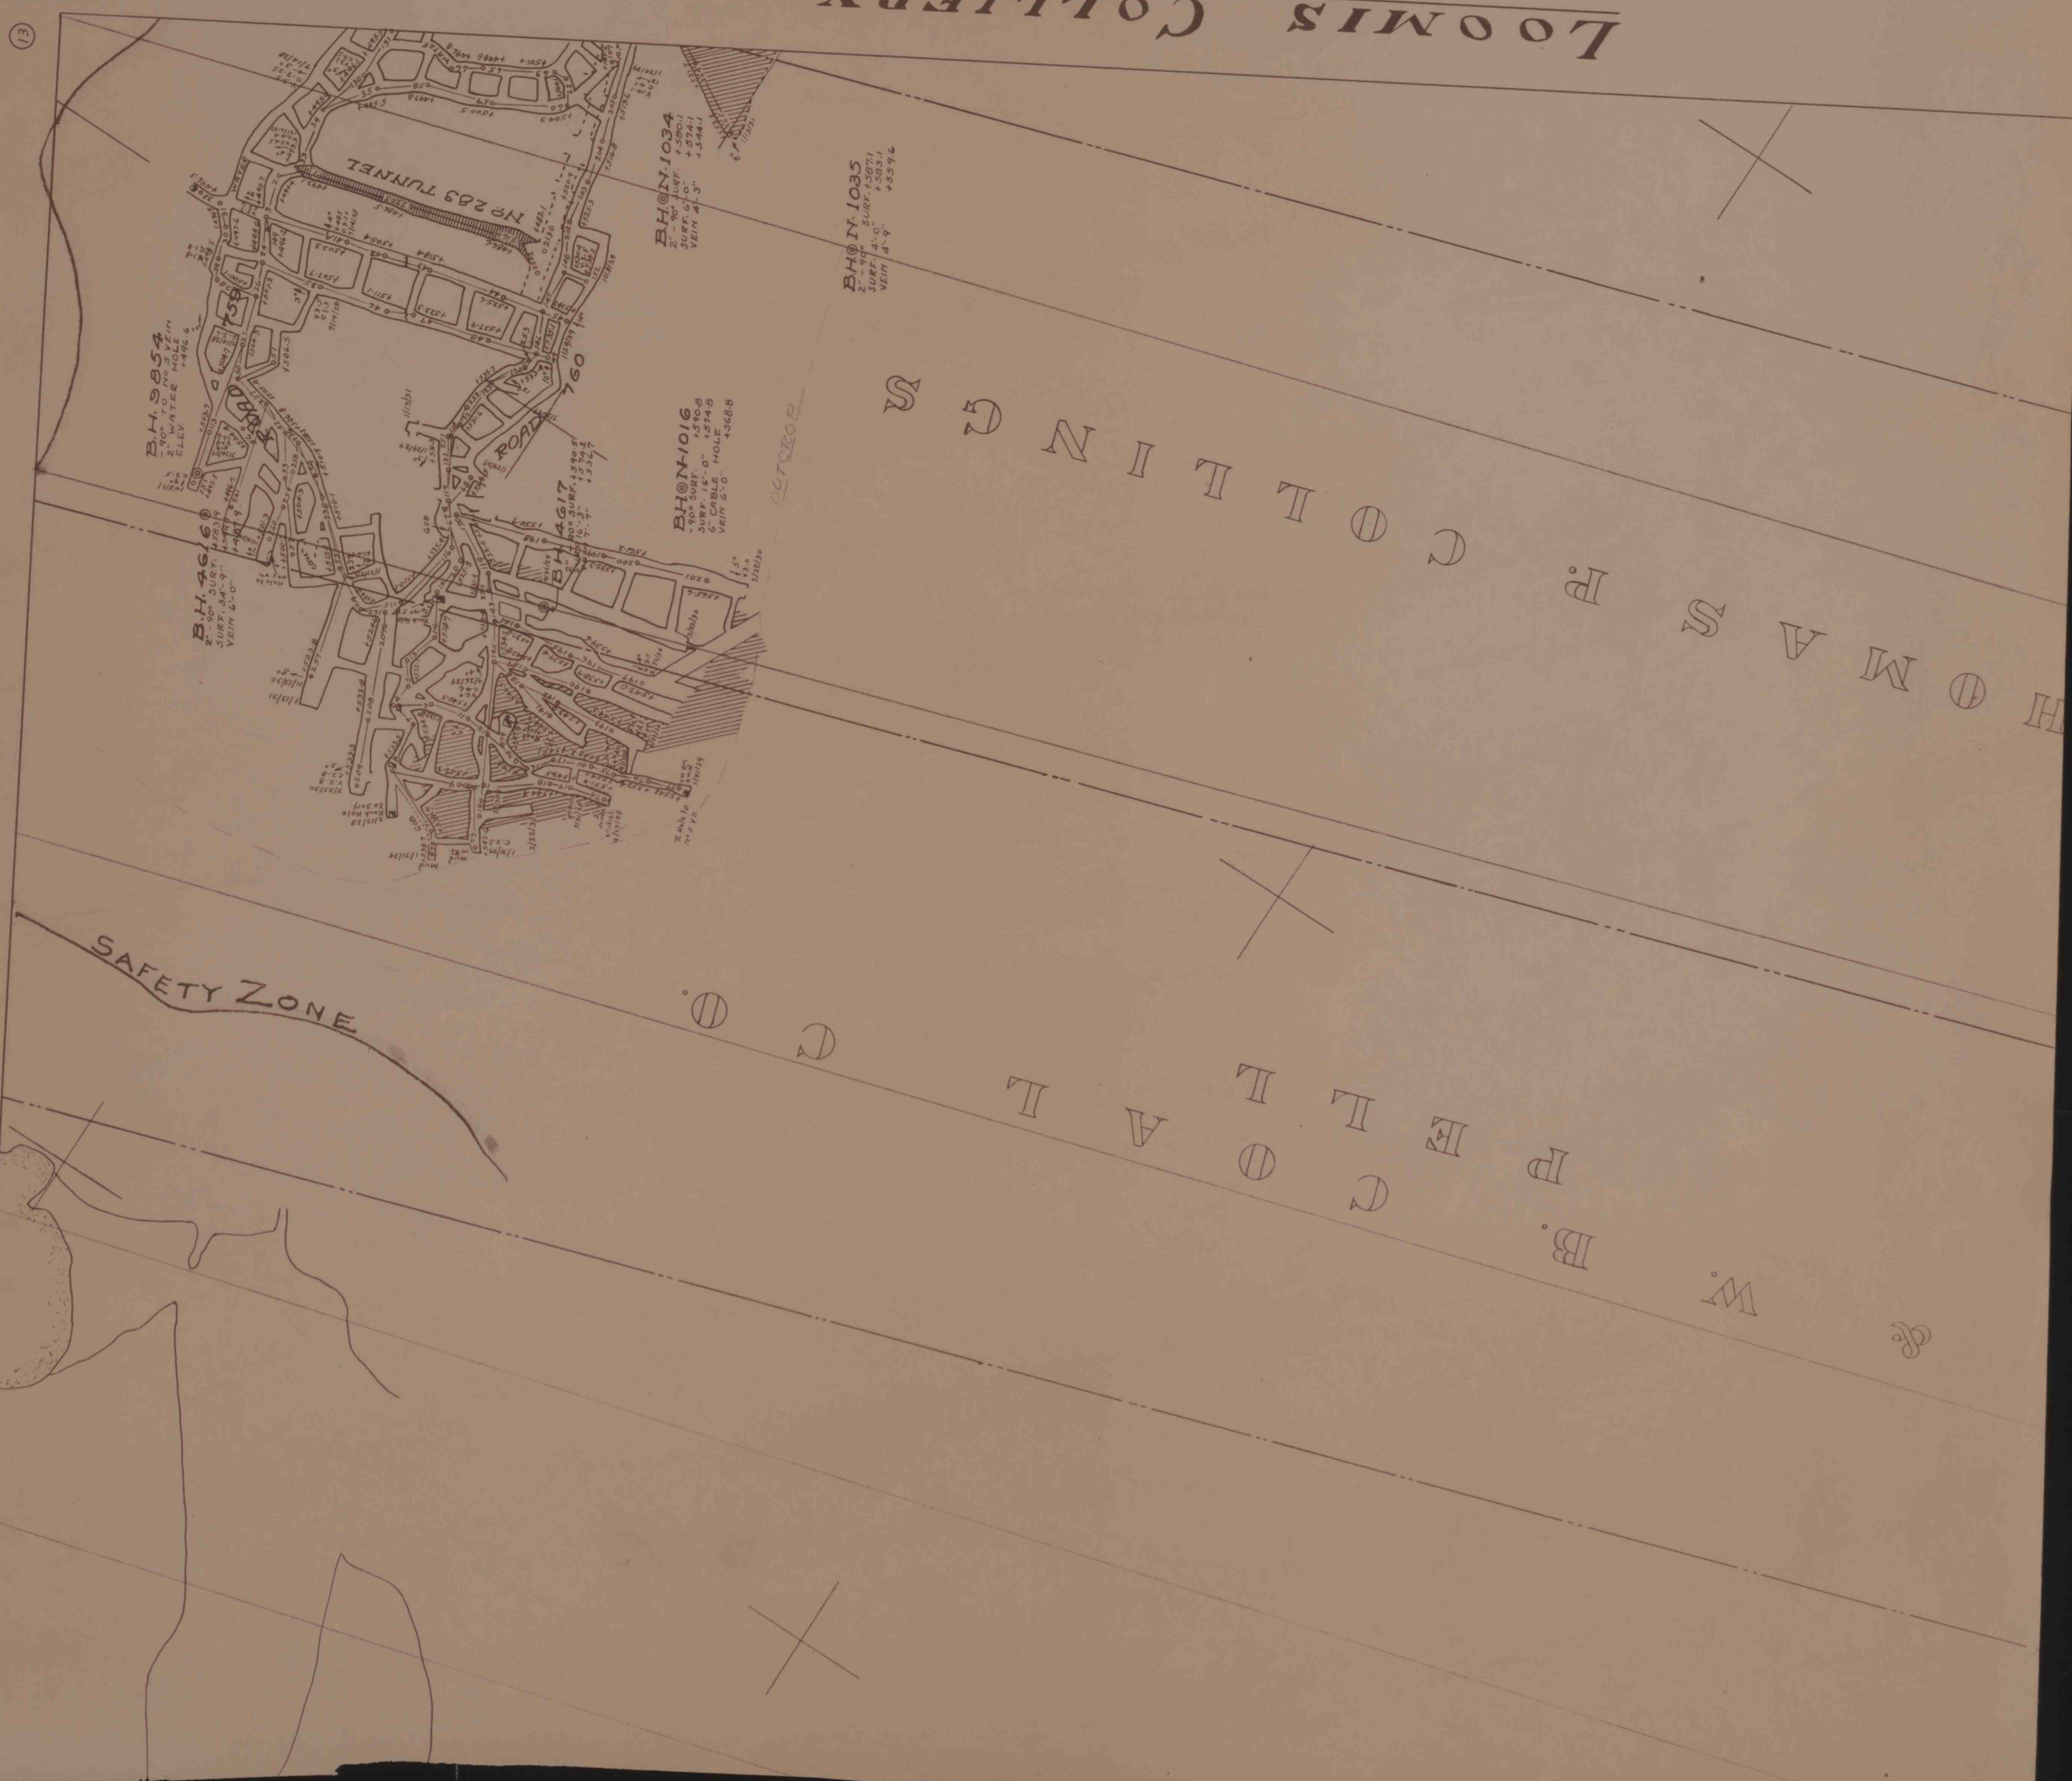Loomis Colliery
No 4 Vein
No 14