


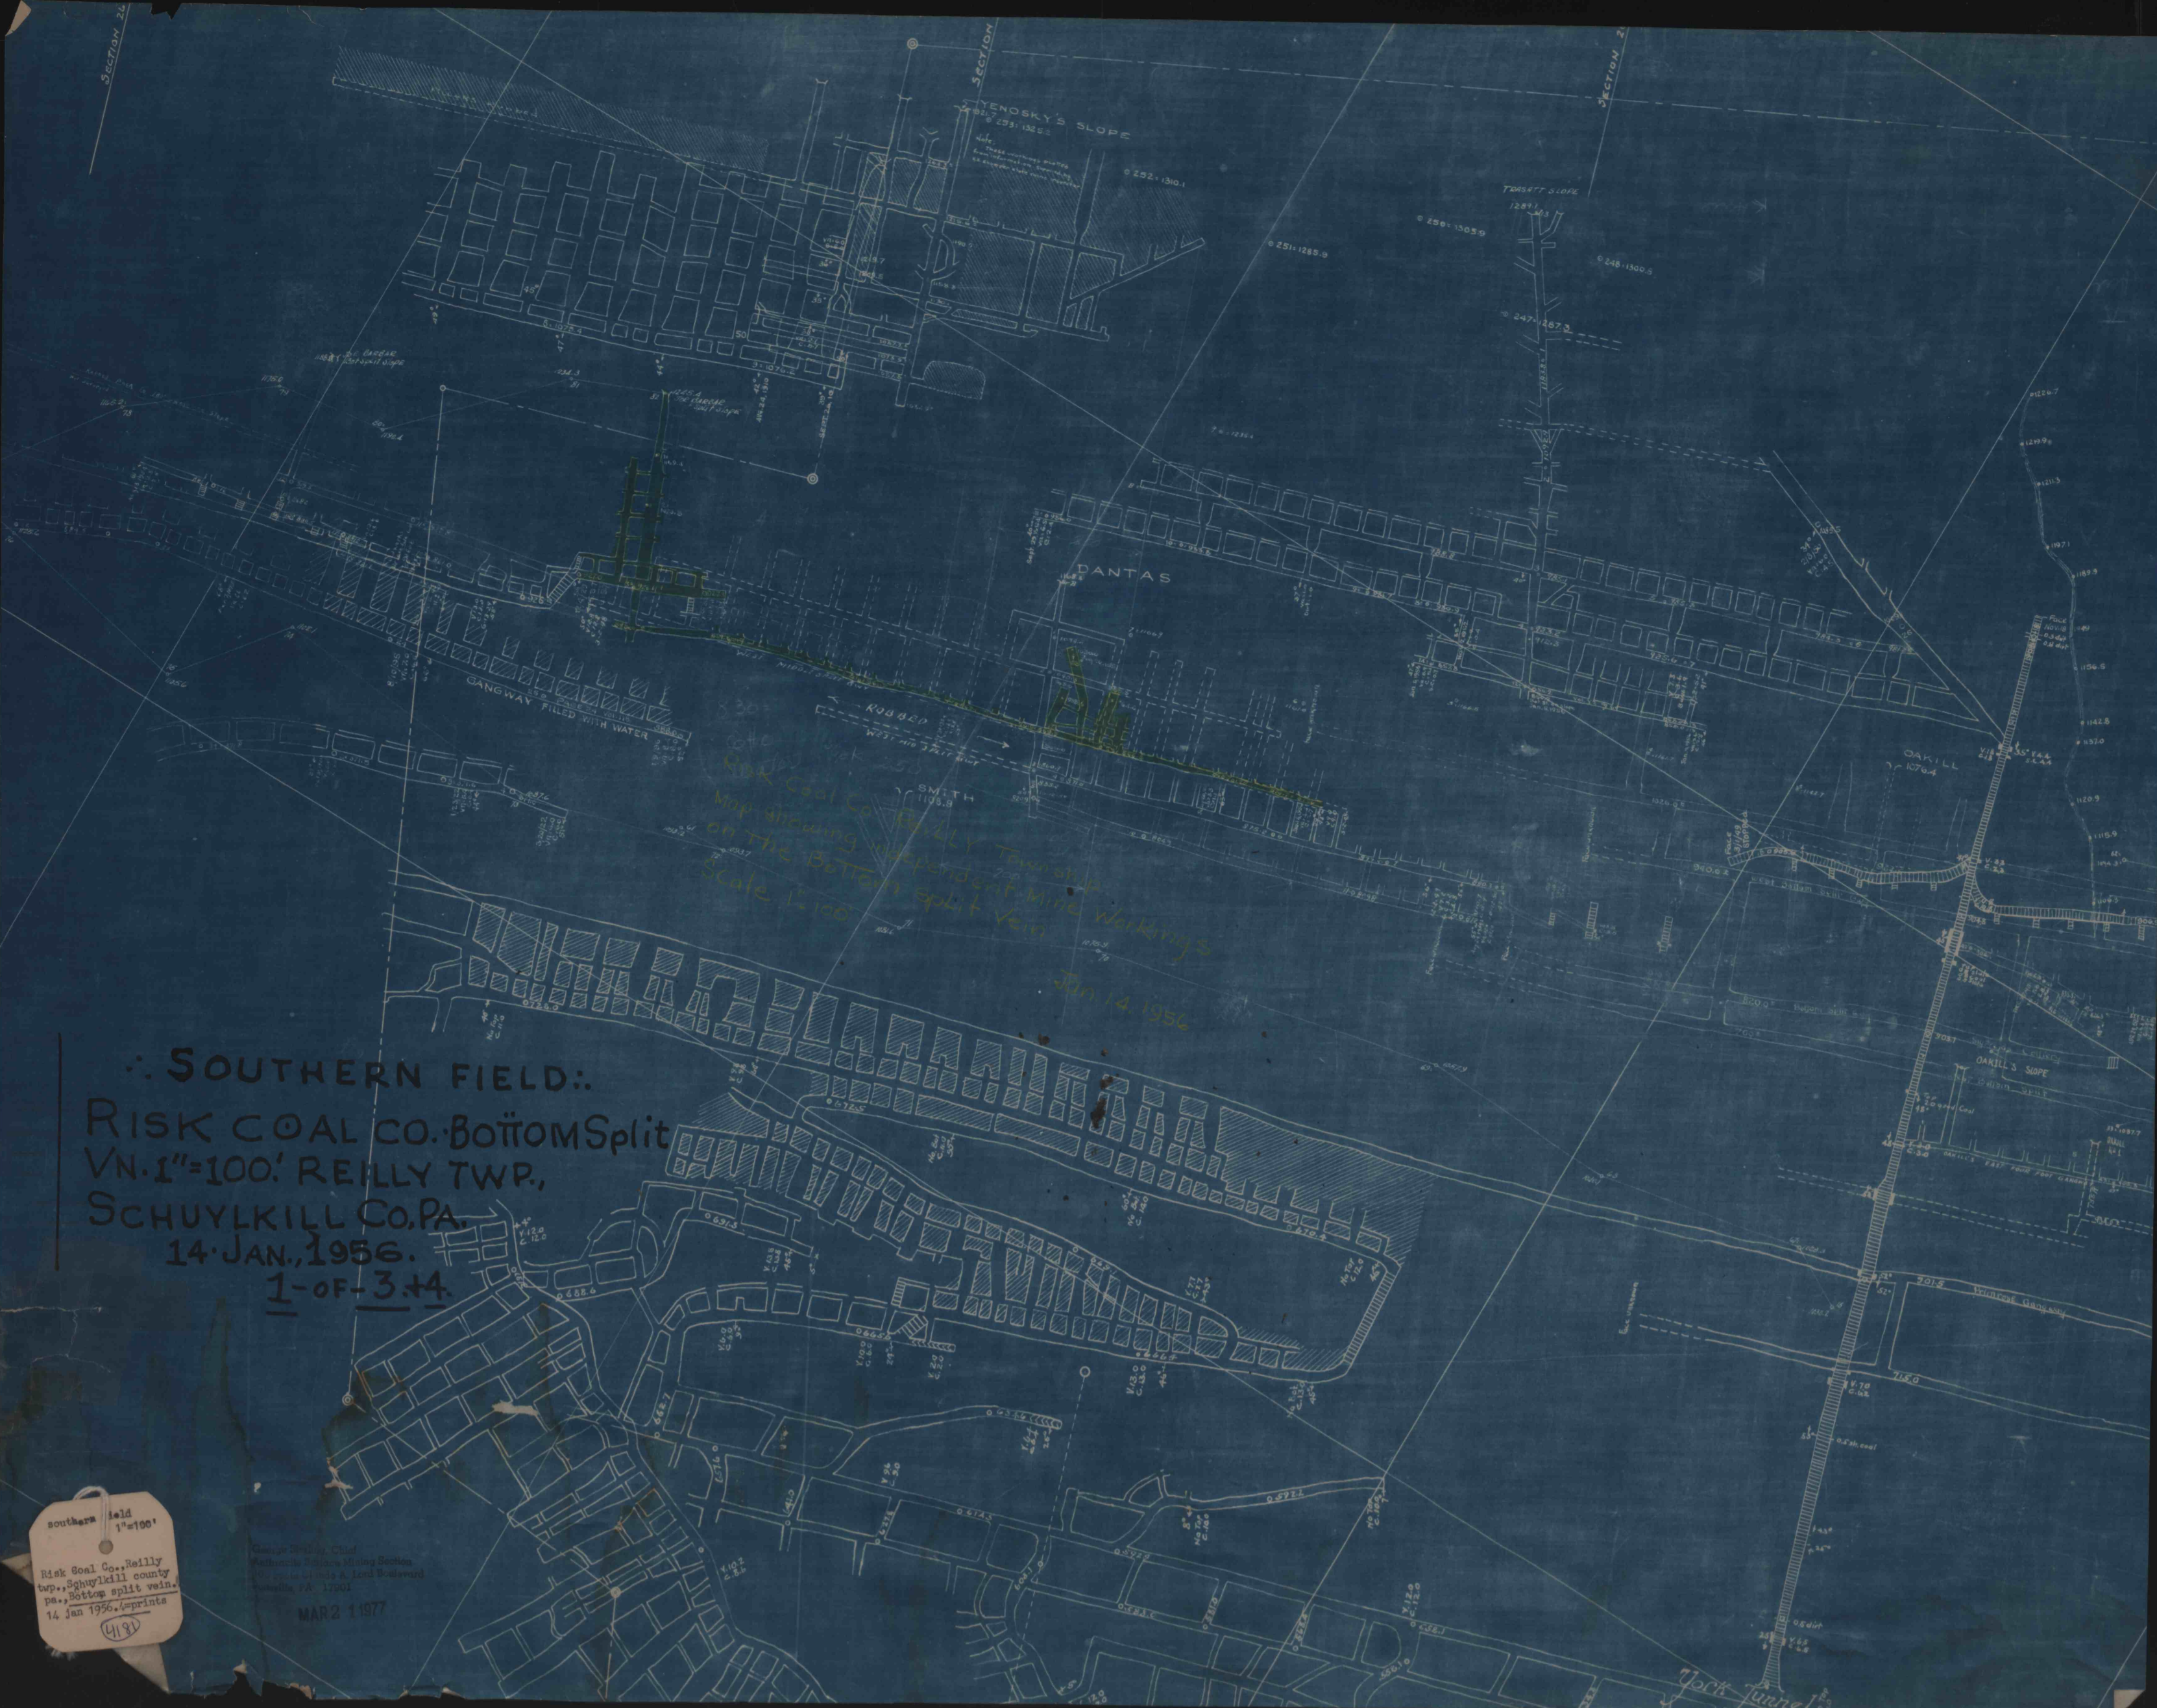

SOUTHERN FIELD:
RISK COAL CO. BOTTOM Split
VN. 1"=100' REILLY TWP.,
SCHUYLKILL CO. PA.
14 JAN. 1956.
1-OF-3.44

southern field
1"=100'
Risk Coal Co., Reilly
Twp., Schuylkill county
pa., Bottom split vein.
14 Jan 1956. 4 prints
4187

