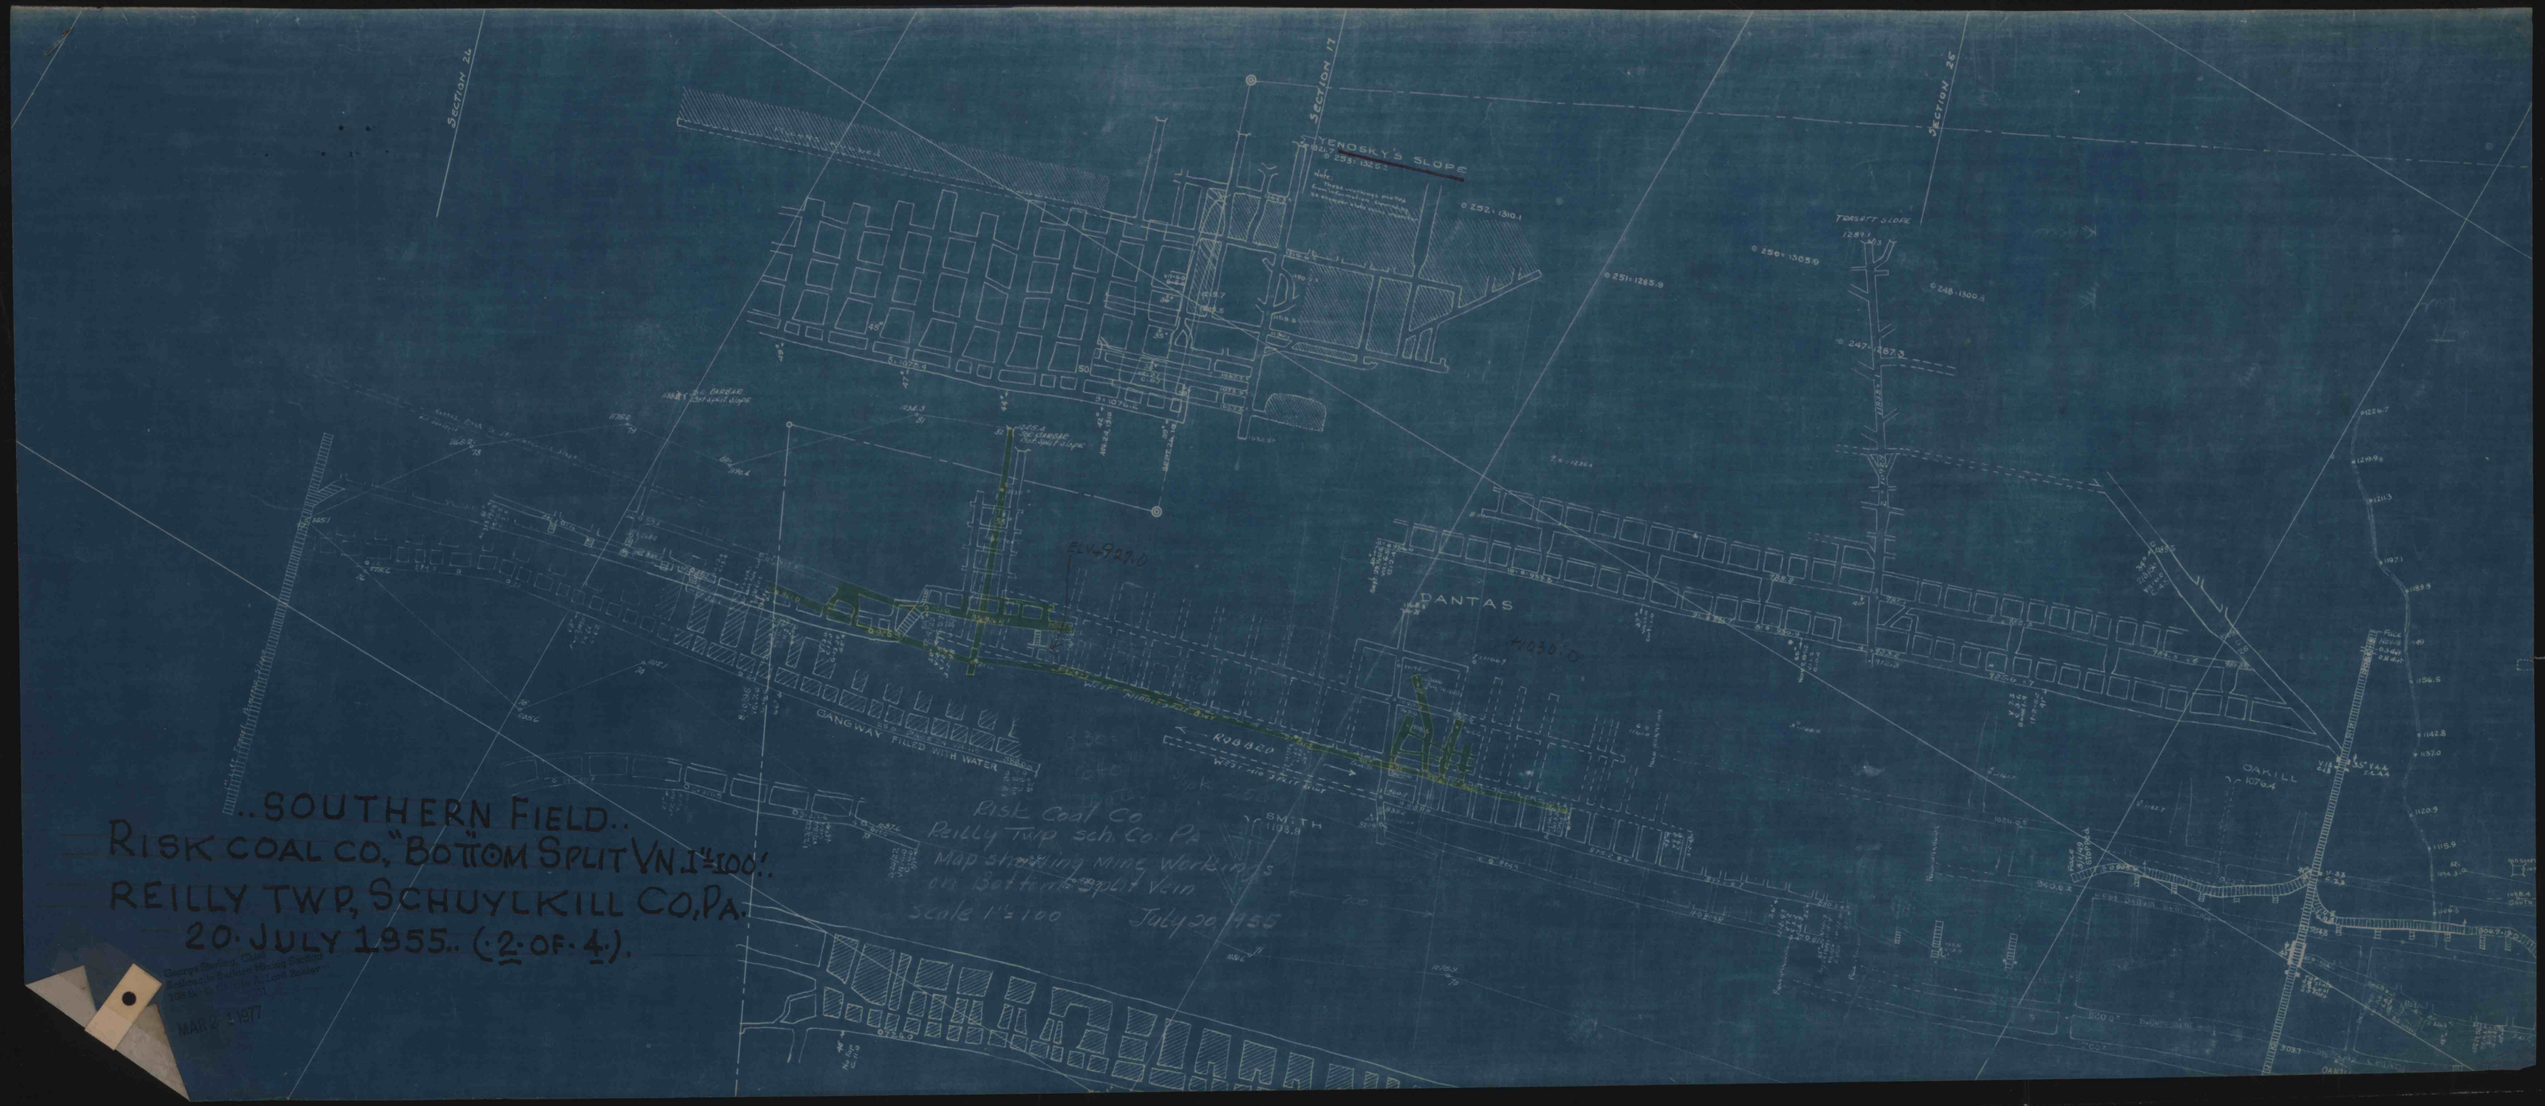
SECTION 24
SECTION 17
SECTION 25
SEMENOSKY'S SLOPE
TORSETT SLOPE
PANTAS
GANGWAY FILLED WITH WATER
SMITH
OAKILL
..SOUTHERN FIELD..
RISK COAL CO. "BOTTOM SPLIT VN. 1"=100'.
REILLY TWP, SCHUYLKILL CO, PA.
20 JULY 1955.. (2 OF 4).
Risk Coal Co
Reilly Twp Sch. Co. Pa
Map Showing Mine Workings
on Bottom Split Vein
Scale 1"=100
July 20 1955
MAR 2 1977