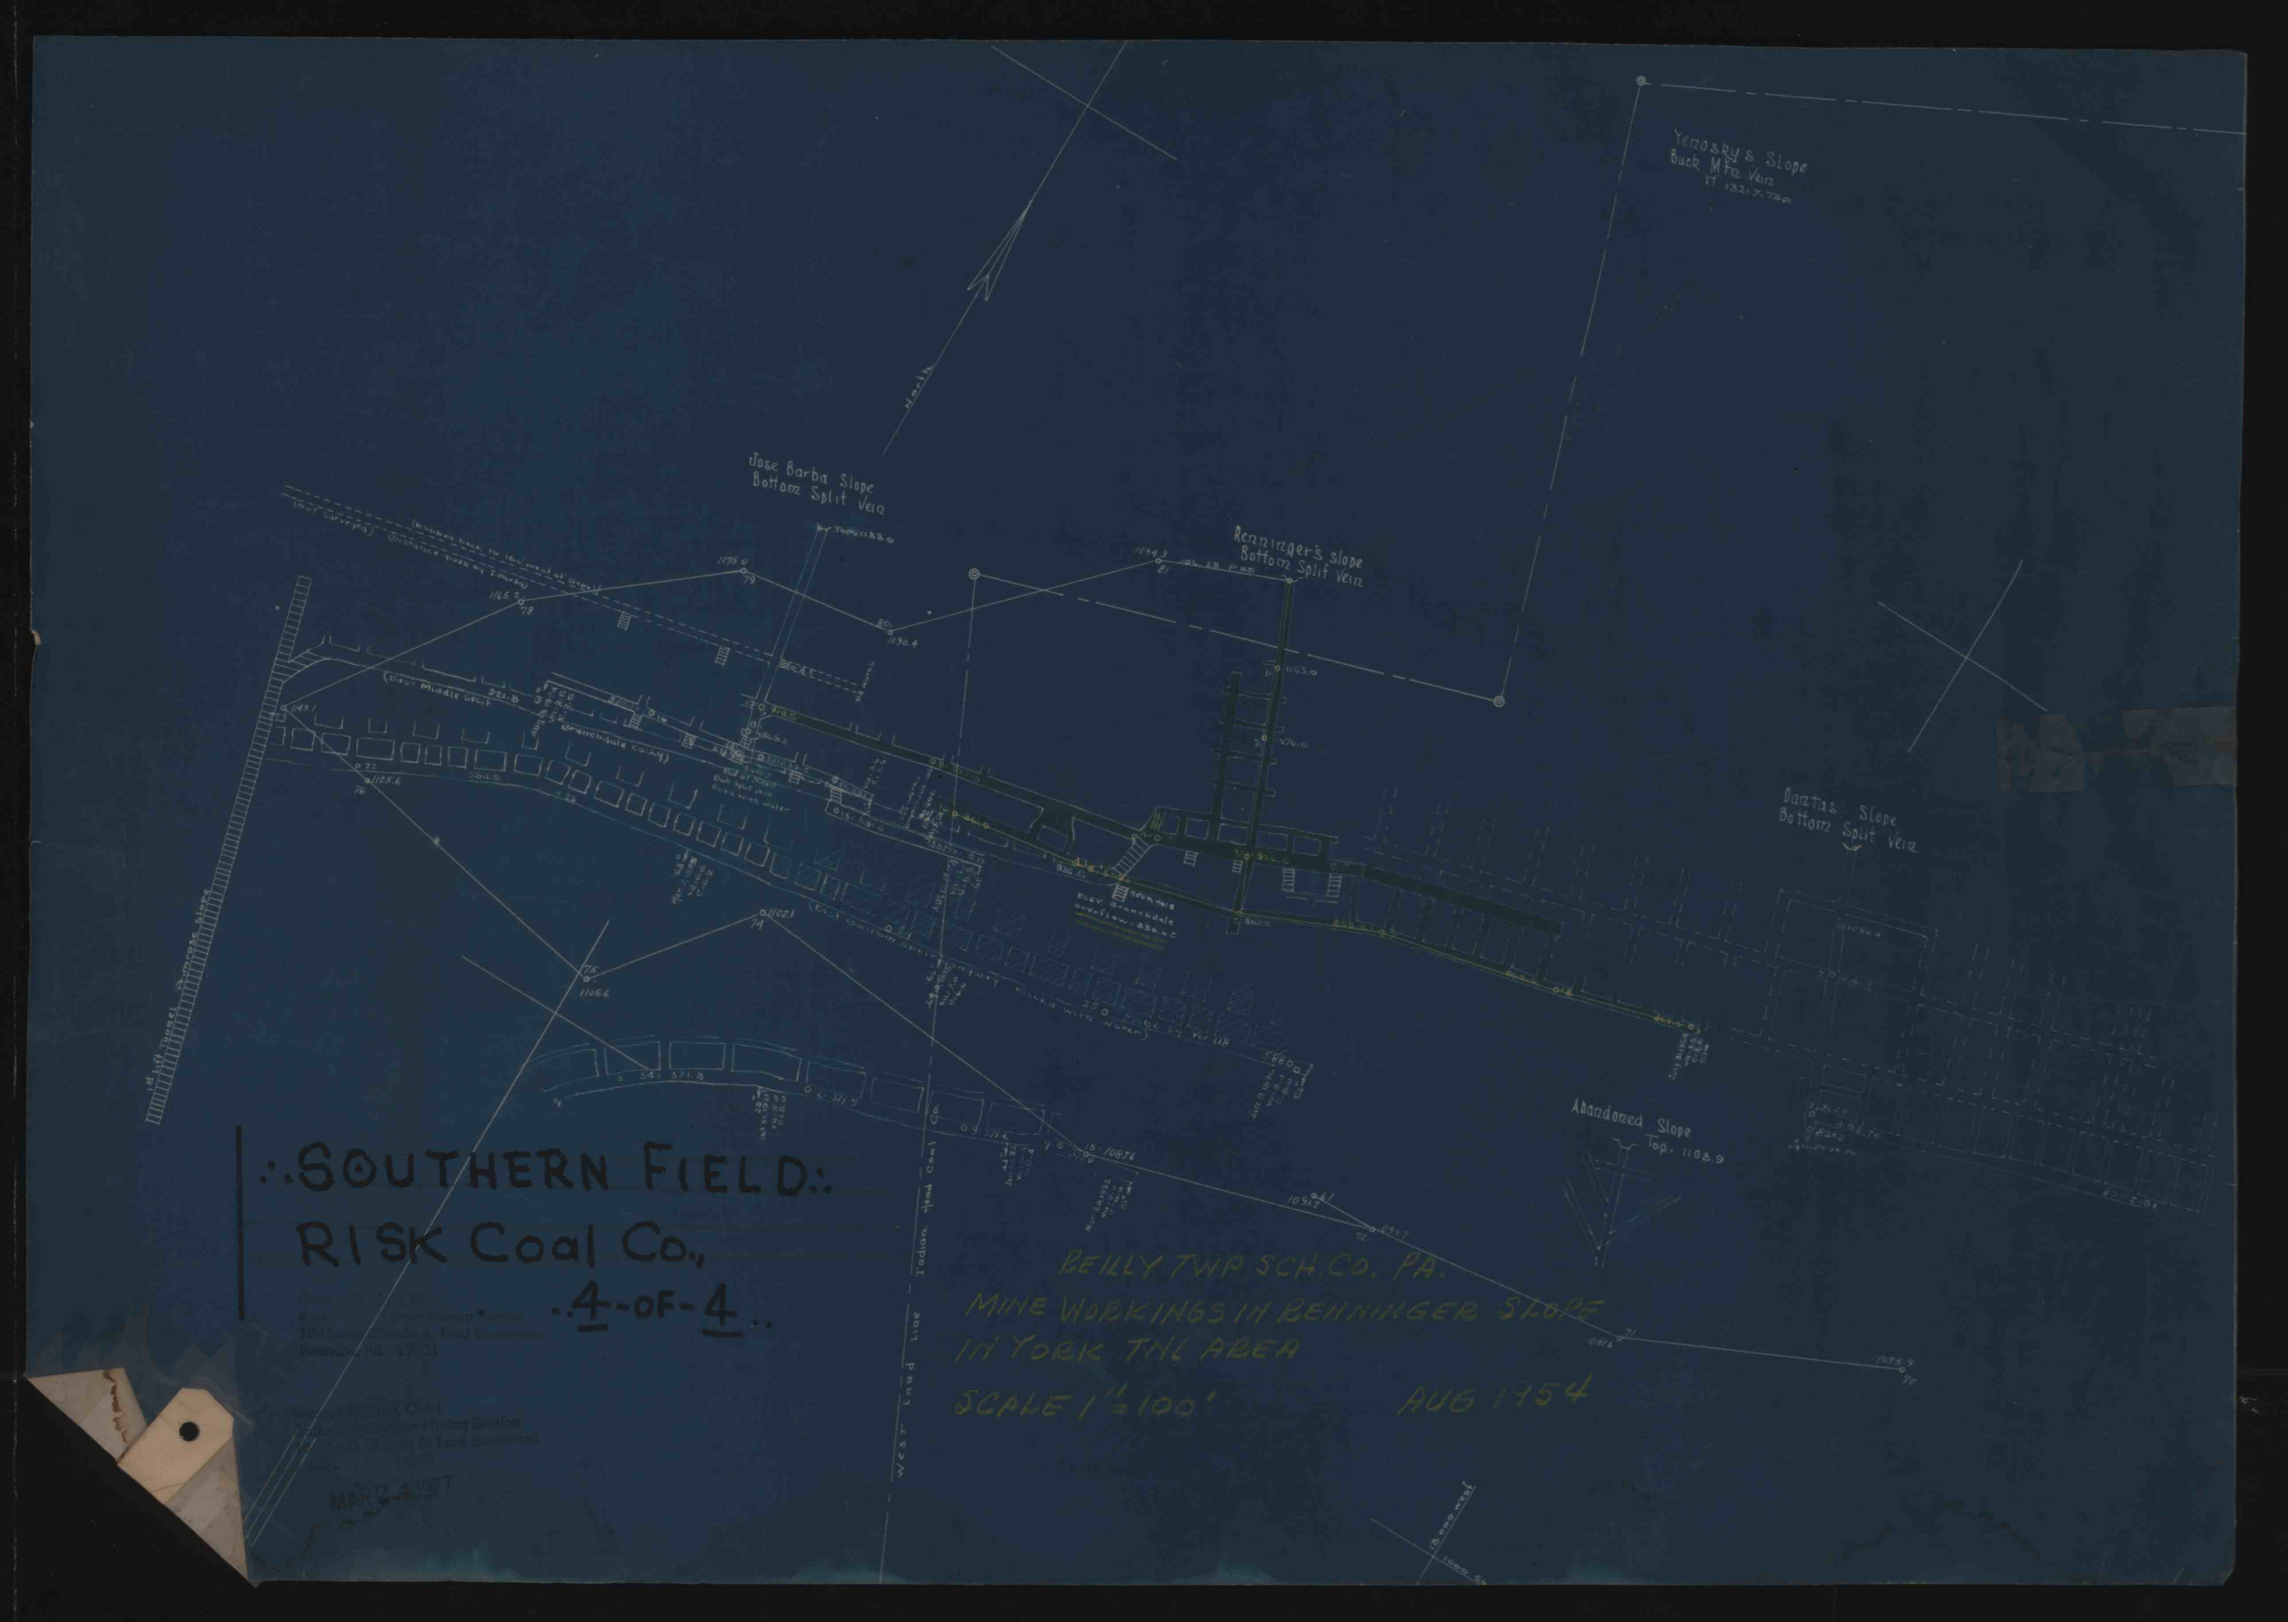
Yenosky's Slope
Buck Mtn. Vein
Jose Barba Slope
Bottom Split Vein
Renninger's slope
Bottom Split Vein
Bantaz Slope
Bottom Split Vein
Abandoned Slope
Top. 1108.9
North
West Land Line Indiana Head Coal Co
∴SOUTHERN FIELD∴
RISK Coal Co.,
∴4-OF-4∴
REILLY TWP SCH. CO. PA.
MINE WORKINGS IN BEHNINGER SLOPE
IN YORK TWP AREA
SCALE 1" = 100'
AUG 1954