


NORWEGIAN

TOWNSHIP

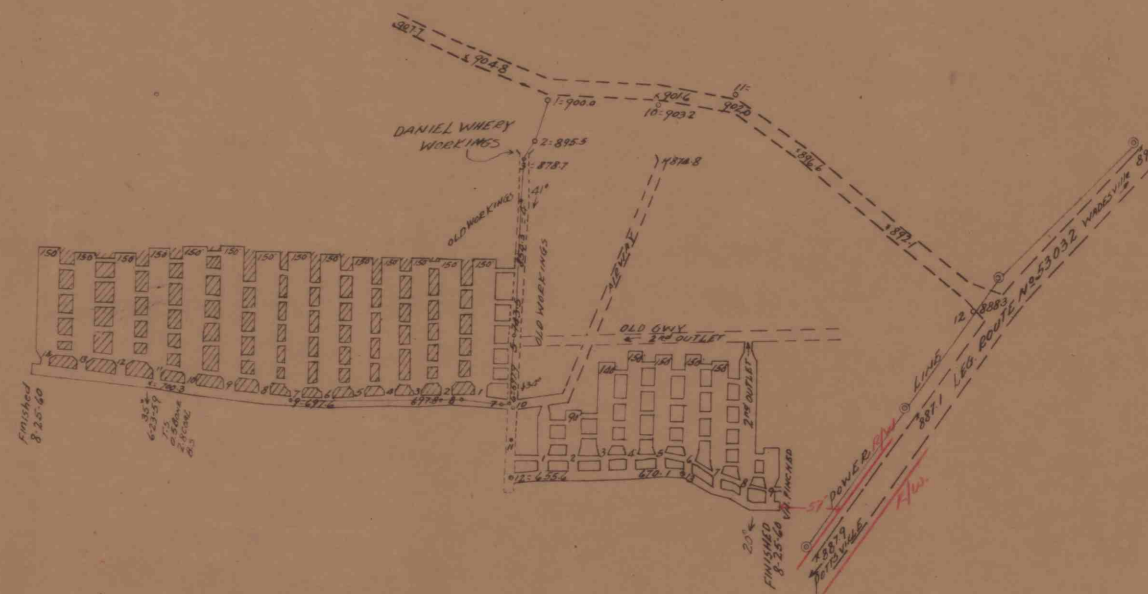

SCHUYLKILL

COUNTY

SOUTHERN FIELD:

MAP SHOWING THE NELSON VEIN WORKINGS OF THE
DANIEL WHERRY MINE NORTH OF LEGISLATIVE ROUTE
NR 53032 BETWEEN WADESVILLE AND POTTSVILLE
PEACH MOUNTAIN IN NORWEGIAN TWP, SCH. COUNTY, PA.
Scale 1"=100' AUGUST 25, 1960 JOHN C. BIRD, JR.
REG. SURV. NR 6307-E

4183