



22888 Church Fire 14-83


Sec 1 AREA-ZERO

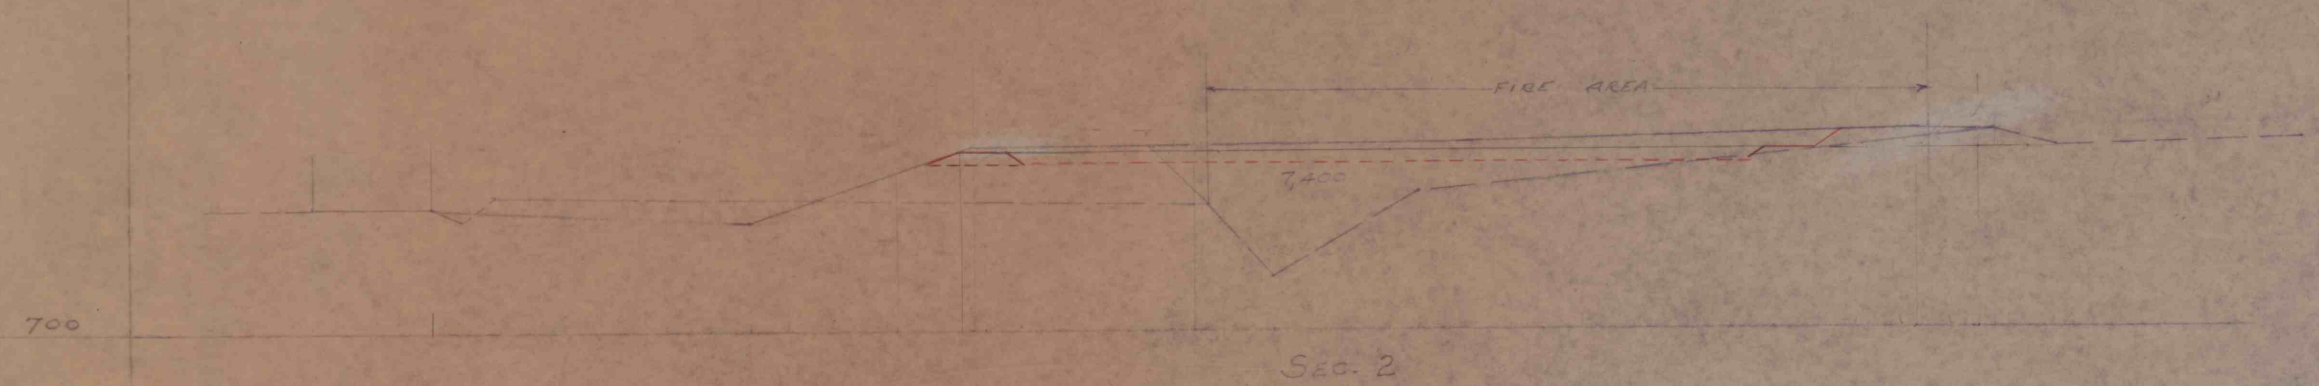


Sec. 2

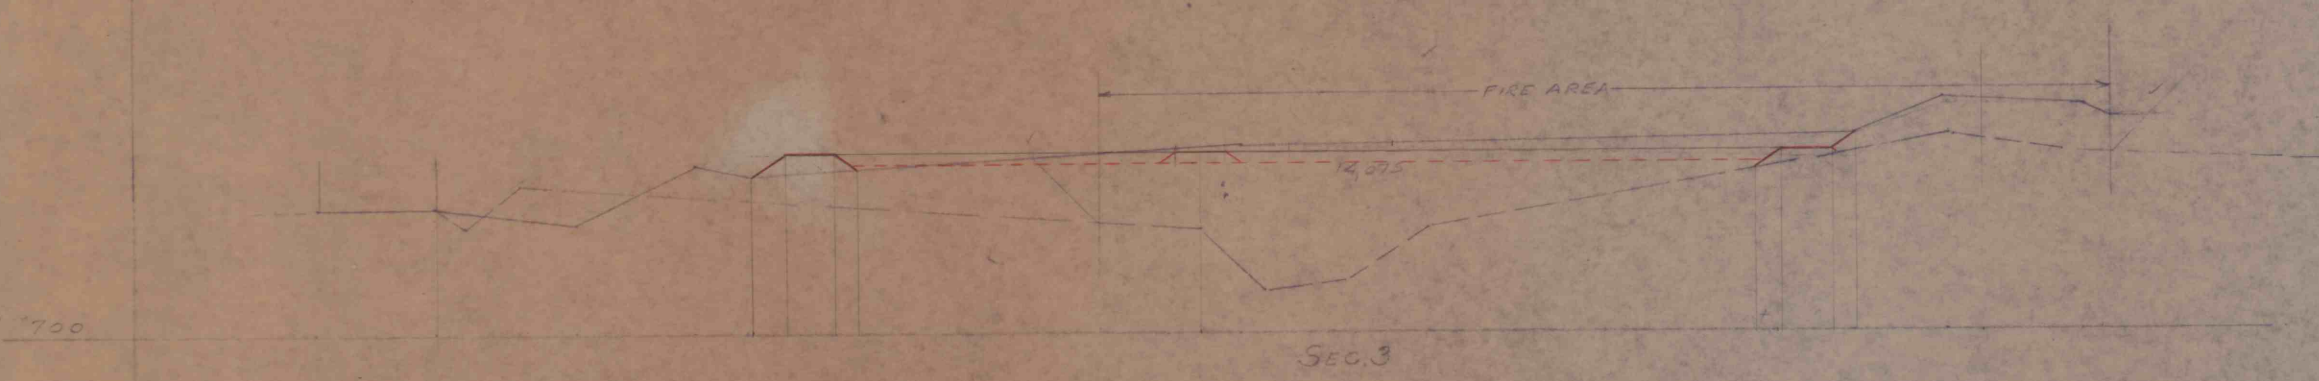


Sec. 3

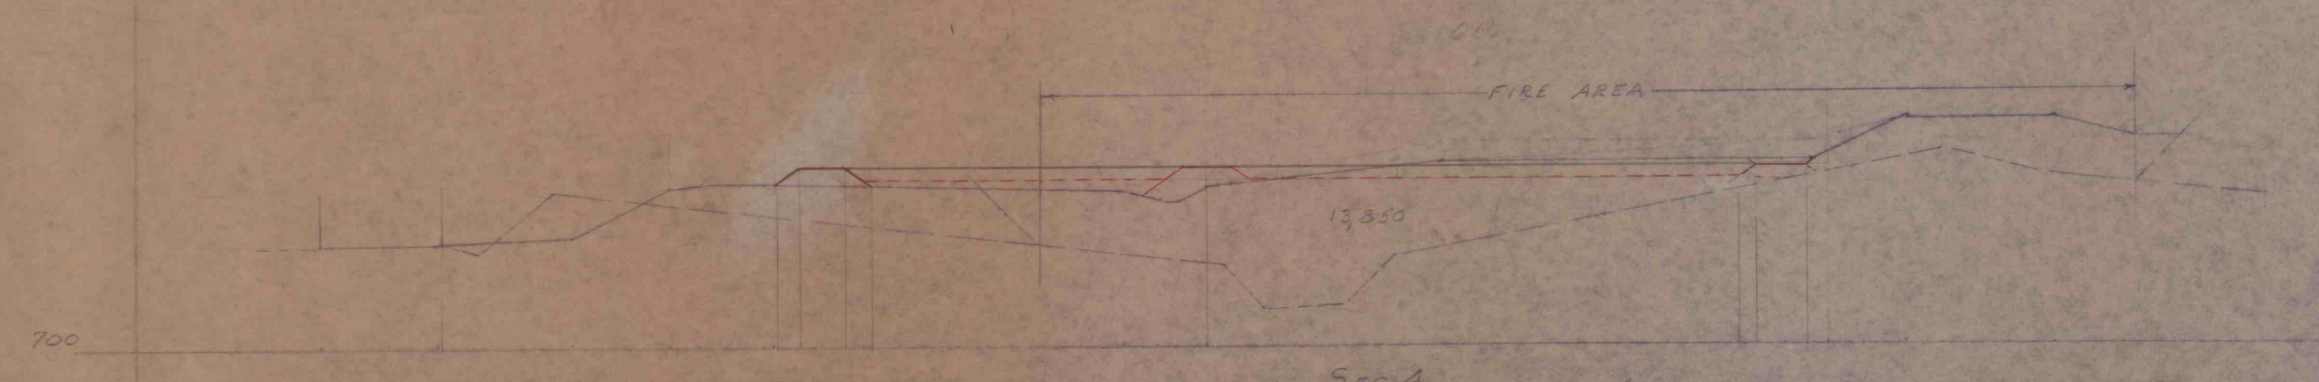


Sec. 4

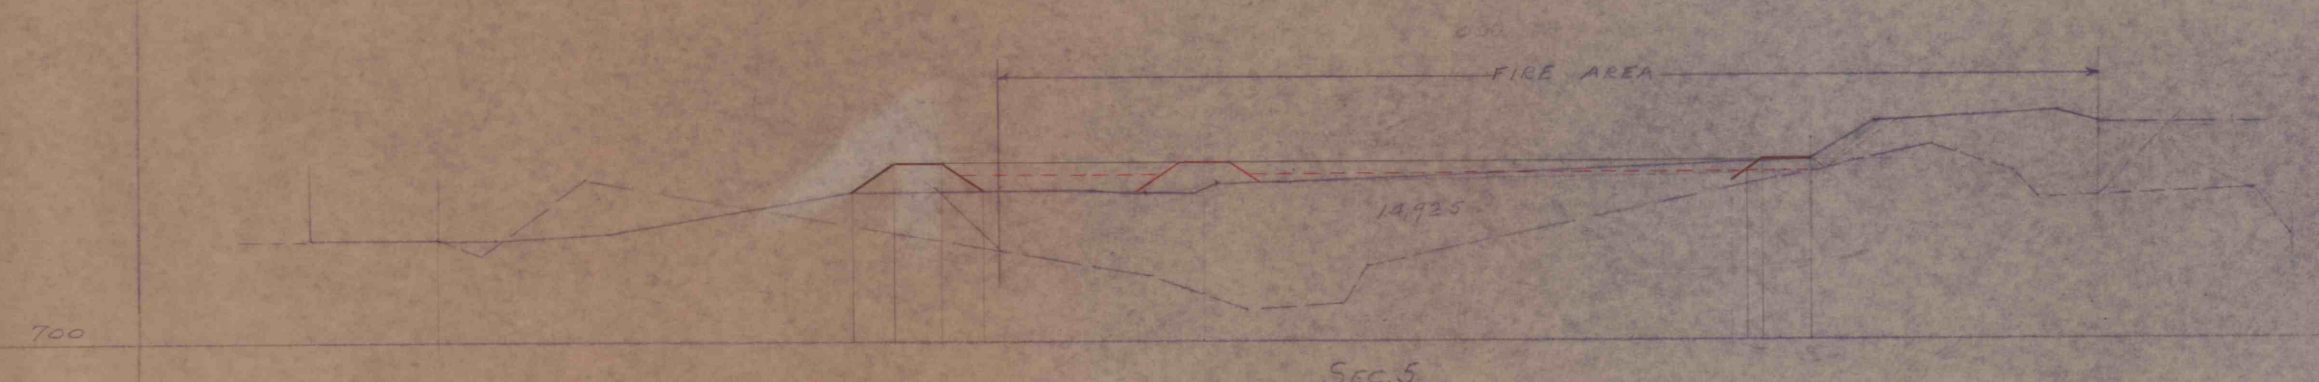


Sec. 5

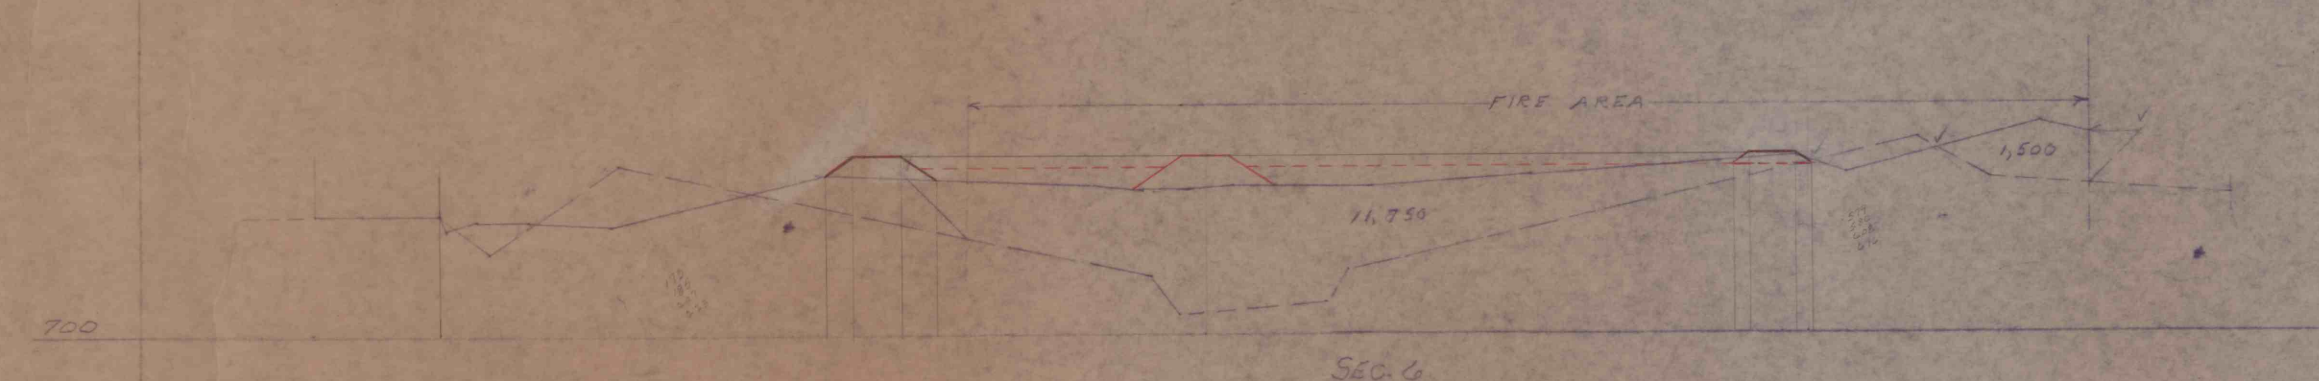


Sec. 6

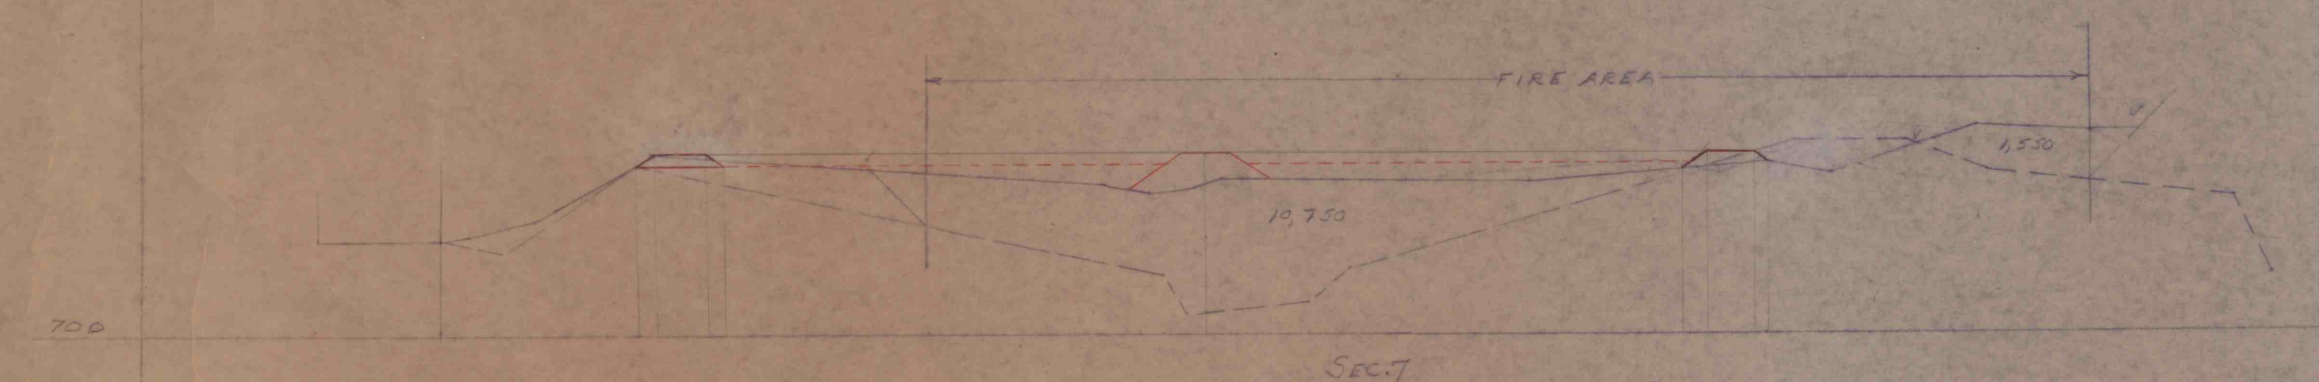


Sec. 7

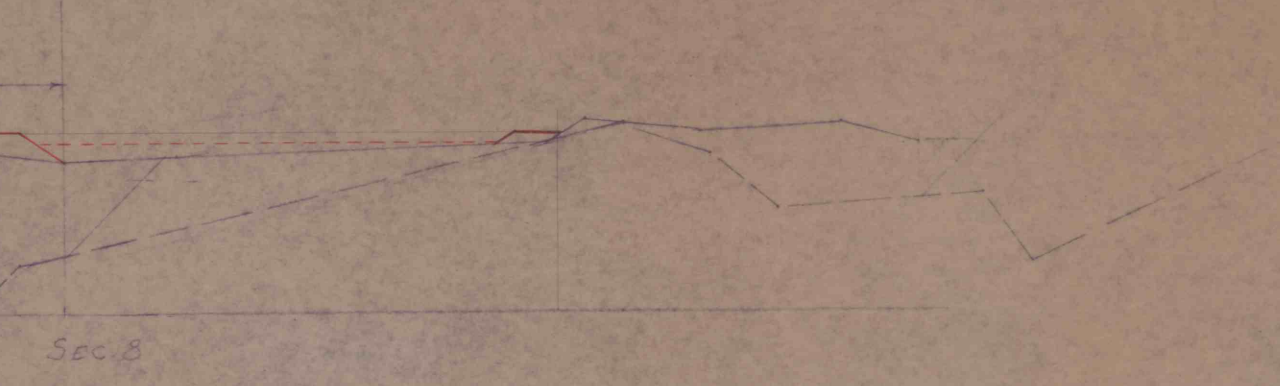

Sec. 8

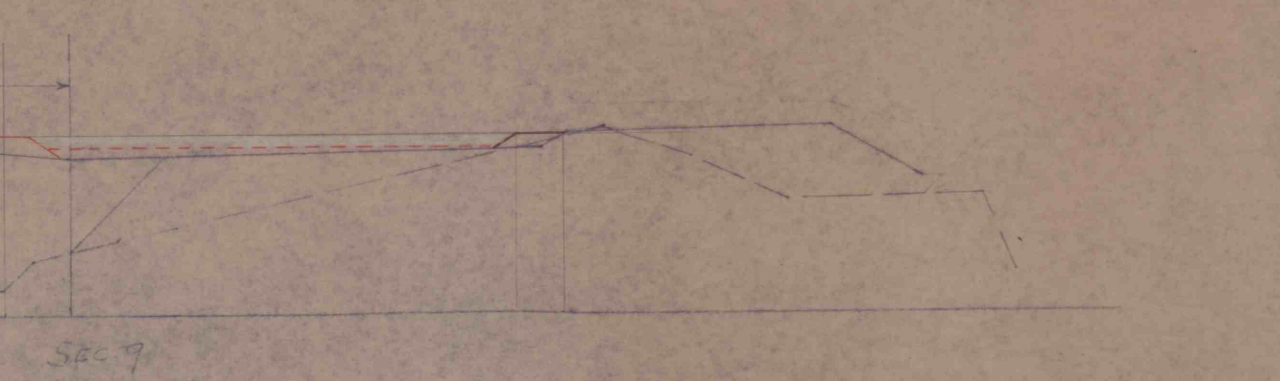


Sec. 9

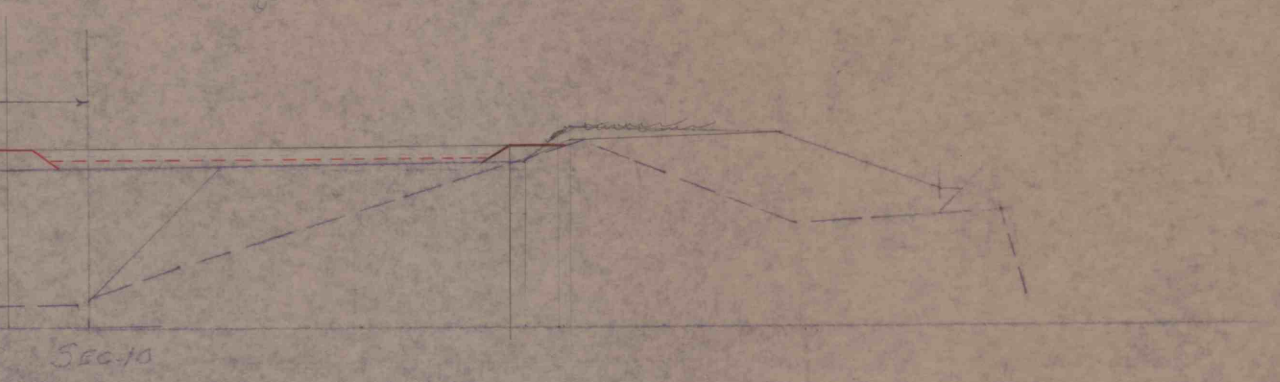


Sec. 10



Sec. 11

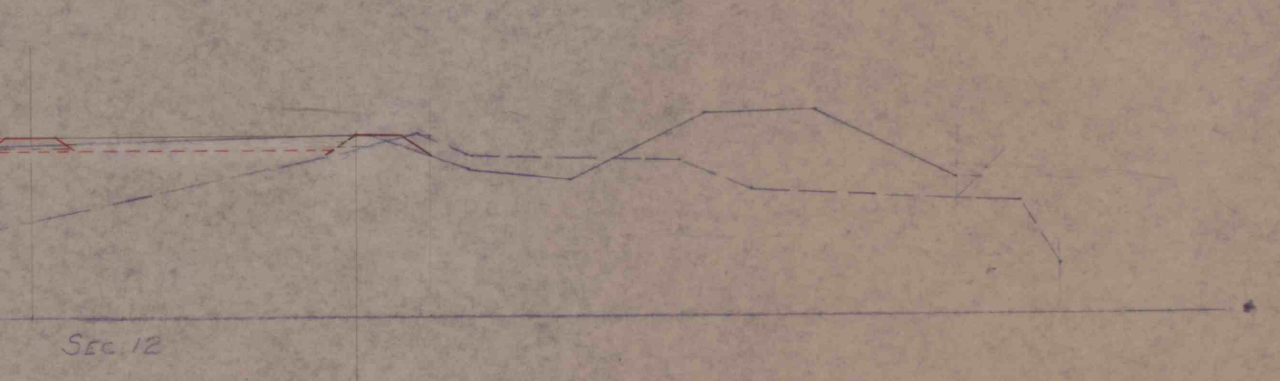

Sec. 12

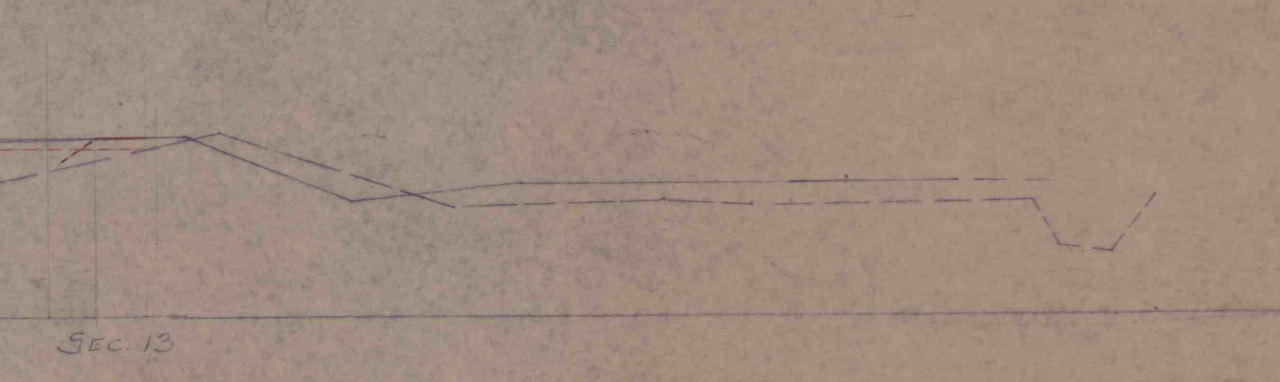

Sec. 13

Sec. 13 AREA-ZERO

CROSS SECTIONS
BANK FIRE
CHURCH & WASHINGTON STS.
TAYLOR BOROUGH
LACKAWANNA CO., PENNSYLVANIA
PENNA. DEPT. OF MINES & MINERAL INDUSTRIES
SCALE: HORIZ. 8" = 100' VERT. 1" = 5'
JANUARY 1968

Taylor Bank Fire, Project #203
Surface & cross sections
Photo: shore & vert.
Church & Washington Sts.,
Taylor Boro., Lackawanna
County, Pa. Jan.-June

486

14-83 Bank Fire

14-83 Bank Fire