


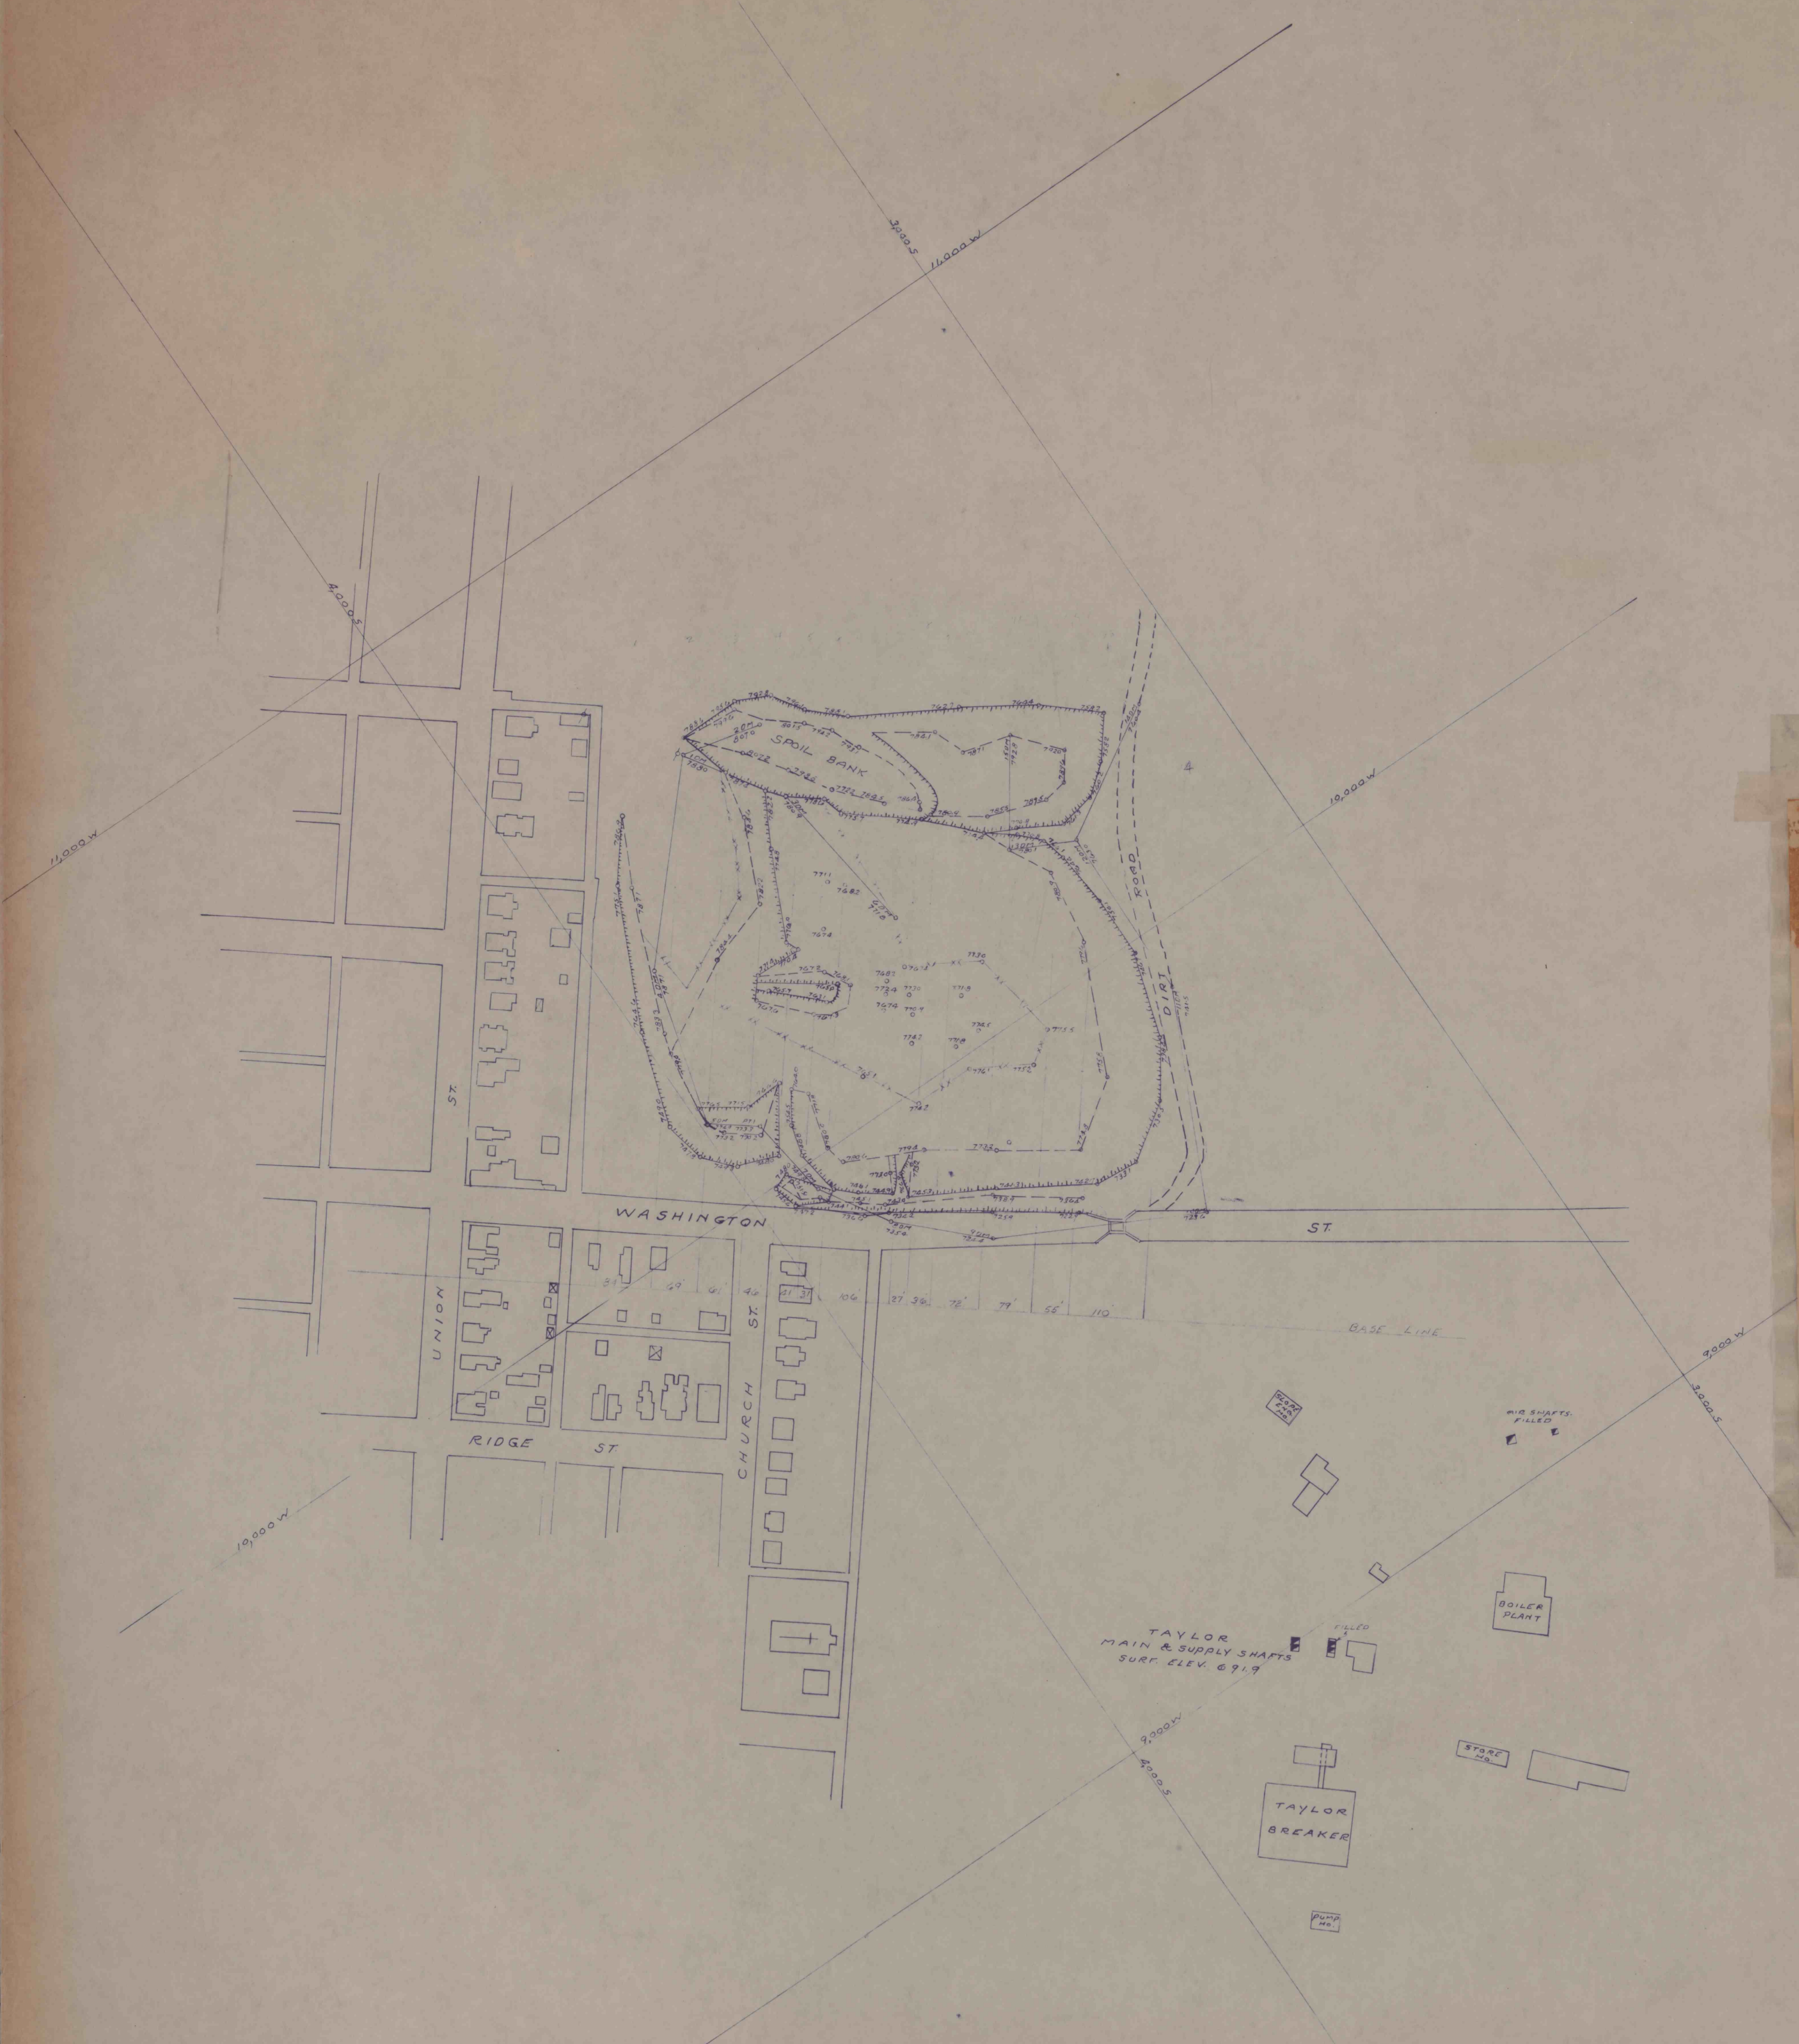

INTERIOR
TAYLOR BANK FIRE
WASHINGTON & CHURCH STS.
TAYLOR, PA.

SECTION	SURFACE FT.
1 - 2	$\frac{0 + 7102}{2} \times 64' = 210,800$
2 - 3	$\frac{7100 + 7107}{2} \times 60' = 710,800$
3 - 4	$\frac{7107 + 7130}{2} \times 61' = 851,713$
4 - 5	$\frac{7130 + 7152}{2} \times 61' = 661,623$
5 - 6	$\frac{7152 + 7150}{2} \times 61' = 597,500$
6 - 7	$\frac{7150 + 7130}{2} \times 61' = 596,800$
7 - 8	$\frac{7130 + 7102}{2} \times 60' = 1,132,075$
8 - 9	$\frac{7102 + 70100}{2} \times 27' = 250,188$
9 - 10	$\frac{70100 + 70,000}{2} \times 36' = 270,500$
10 - 11	$\frac{70,000 + 71,000}{2} \times 72' = 804,960$
11 - 12	$\frac{71,000 + 71,000}{2} \times 79' = 601,783$
12 - 13	$\frac{71,000 + 0}{2} \times 55' = 105,188$
TOTAL	6,621,900

$\frac{6,621,900}{27} = 252,640$ outside yards
A.L.E. = P.H. 1/24/68

..NORTHERN FIELD..

SURFACE MAP
SHOWING
BANK FIRE
CHURCH & WASHINGTON STS.
TAYLOR BORO, LACKAWANNA CO, PENN.
PENN. DEPT. OF MINES & MINERAL INDUSTRIES
SCALE 1" = 100' JANUARY 1968