




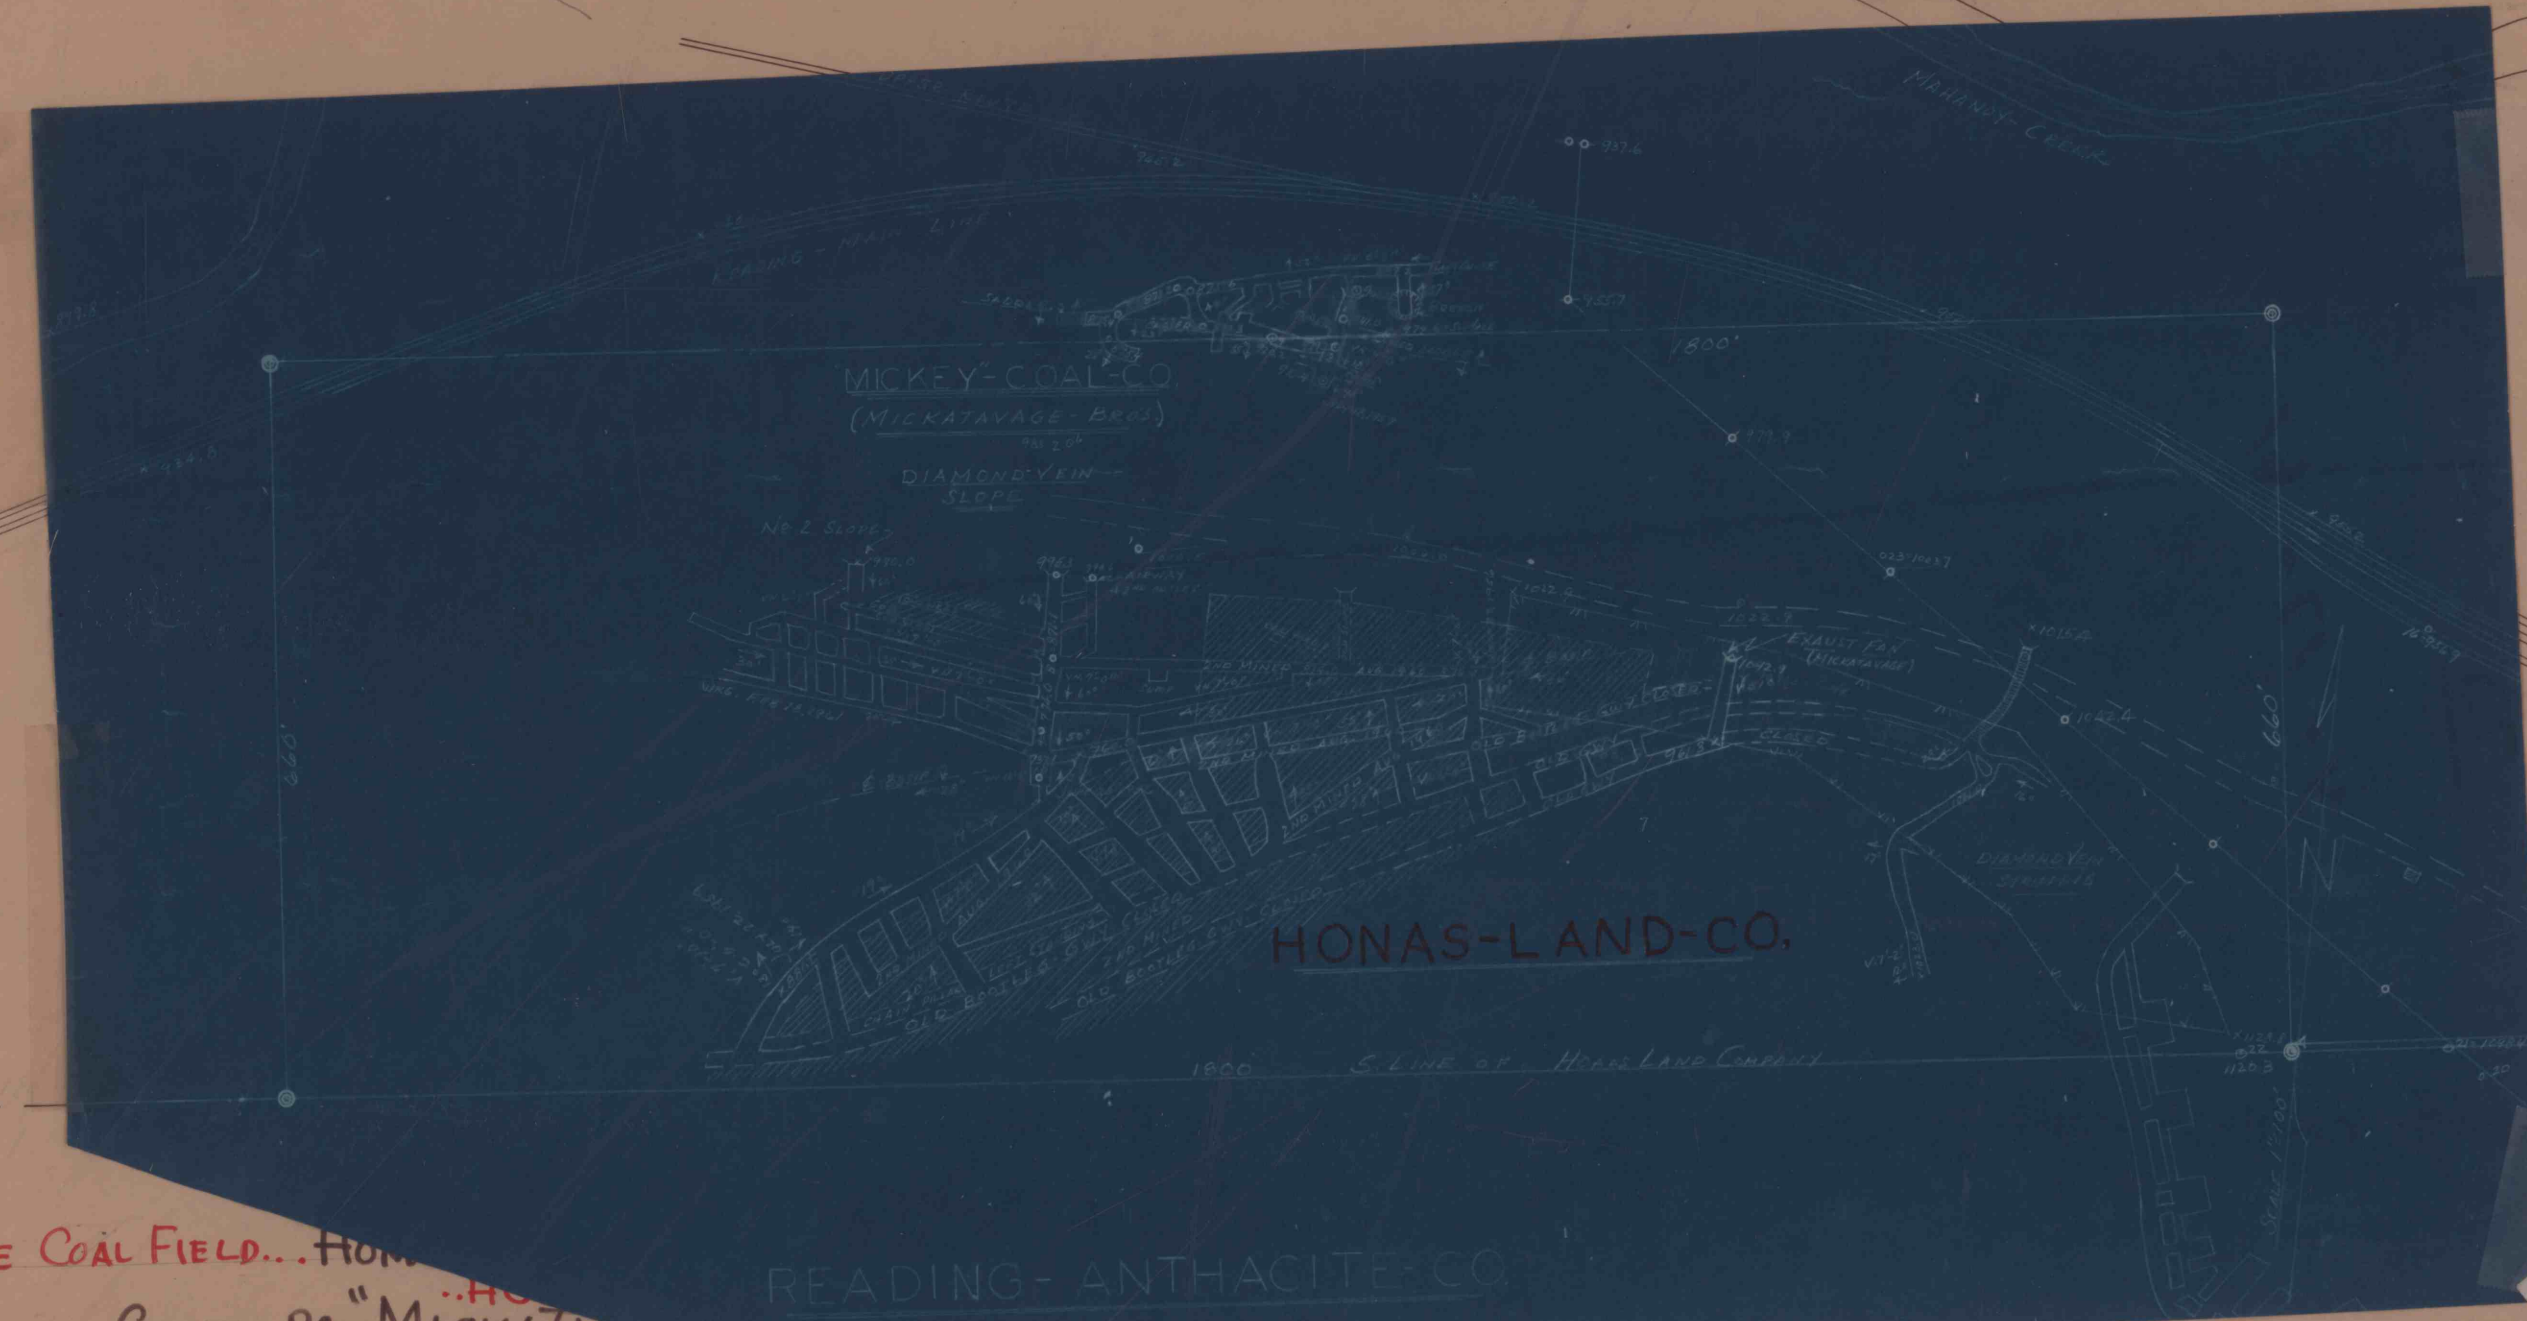

...WESTERN MIDDLE COAL FIELD...
BUTLER TWP, SCHUYLKILL COUNTY, PA., MICKATAVA
NOVEMBER 18, 1959. "STRIPP'G-MINES" IN "PRESTON AREA"
.. SHEET: 2-OF-2. ..

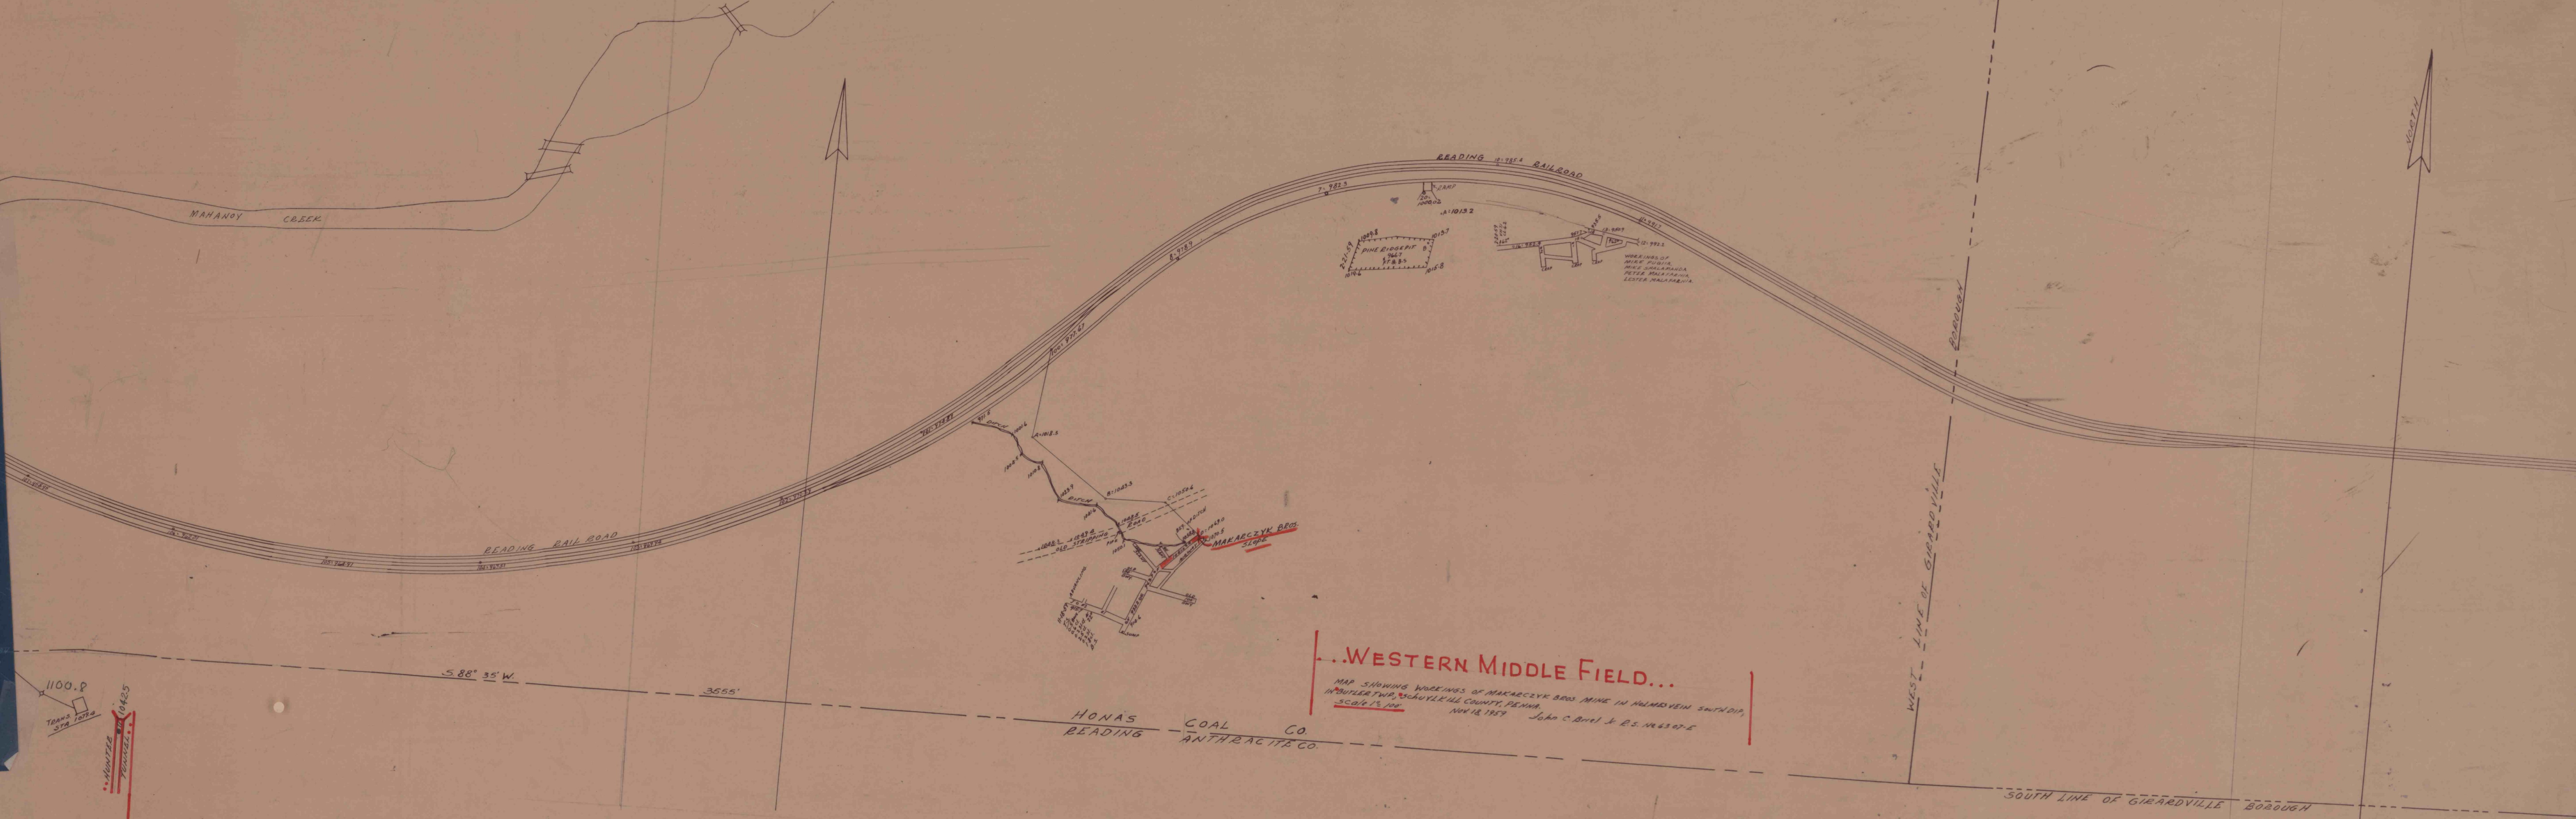

...WESTERN MIDDLE FIELD...
IN BUTLER TWP, SCHUYLKILL COUNTY, PENN.
NOV 18 1959. S.D. C. D. 111 & E.S. 111 27-1-E
SCALE 1" = 100'

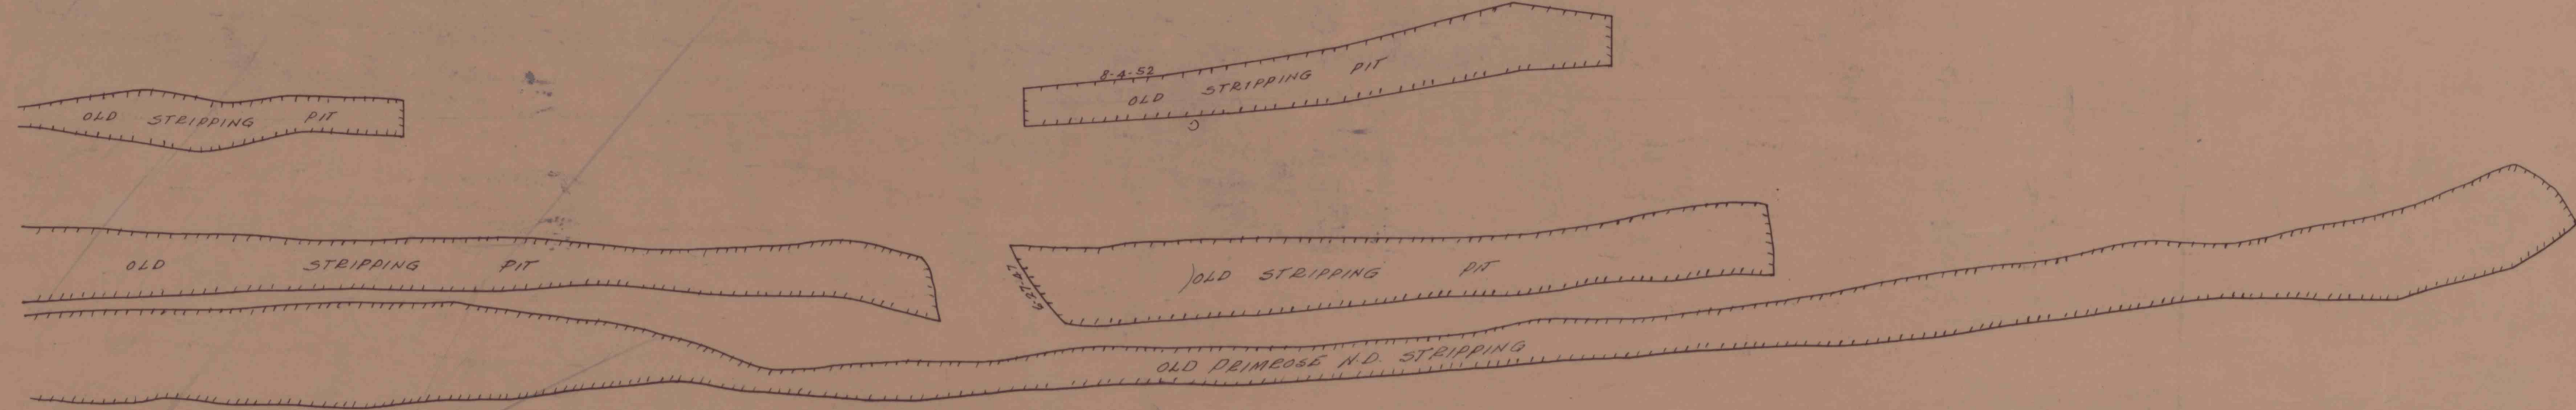