


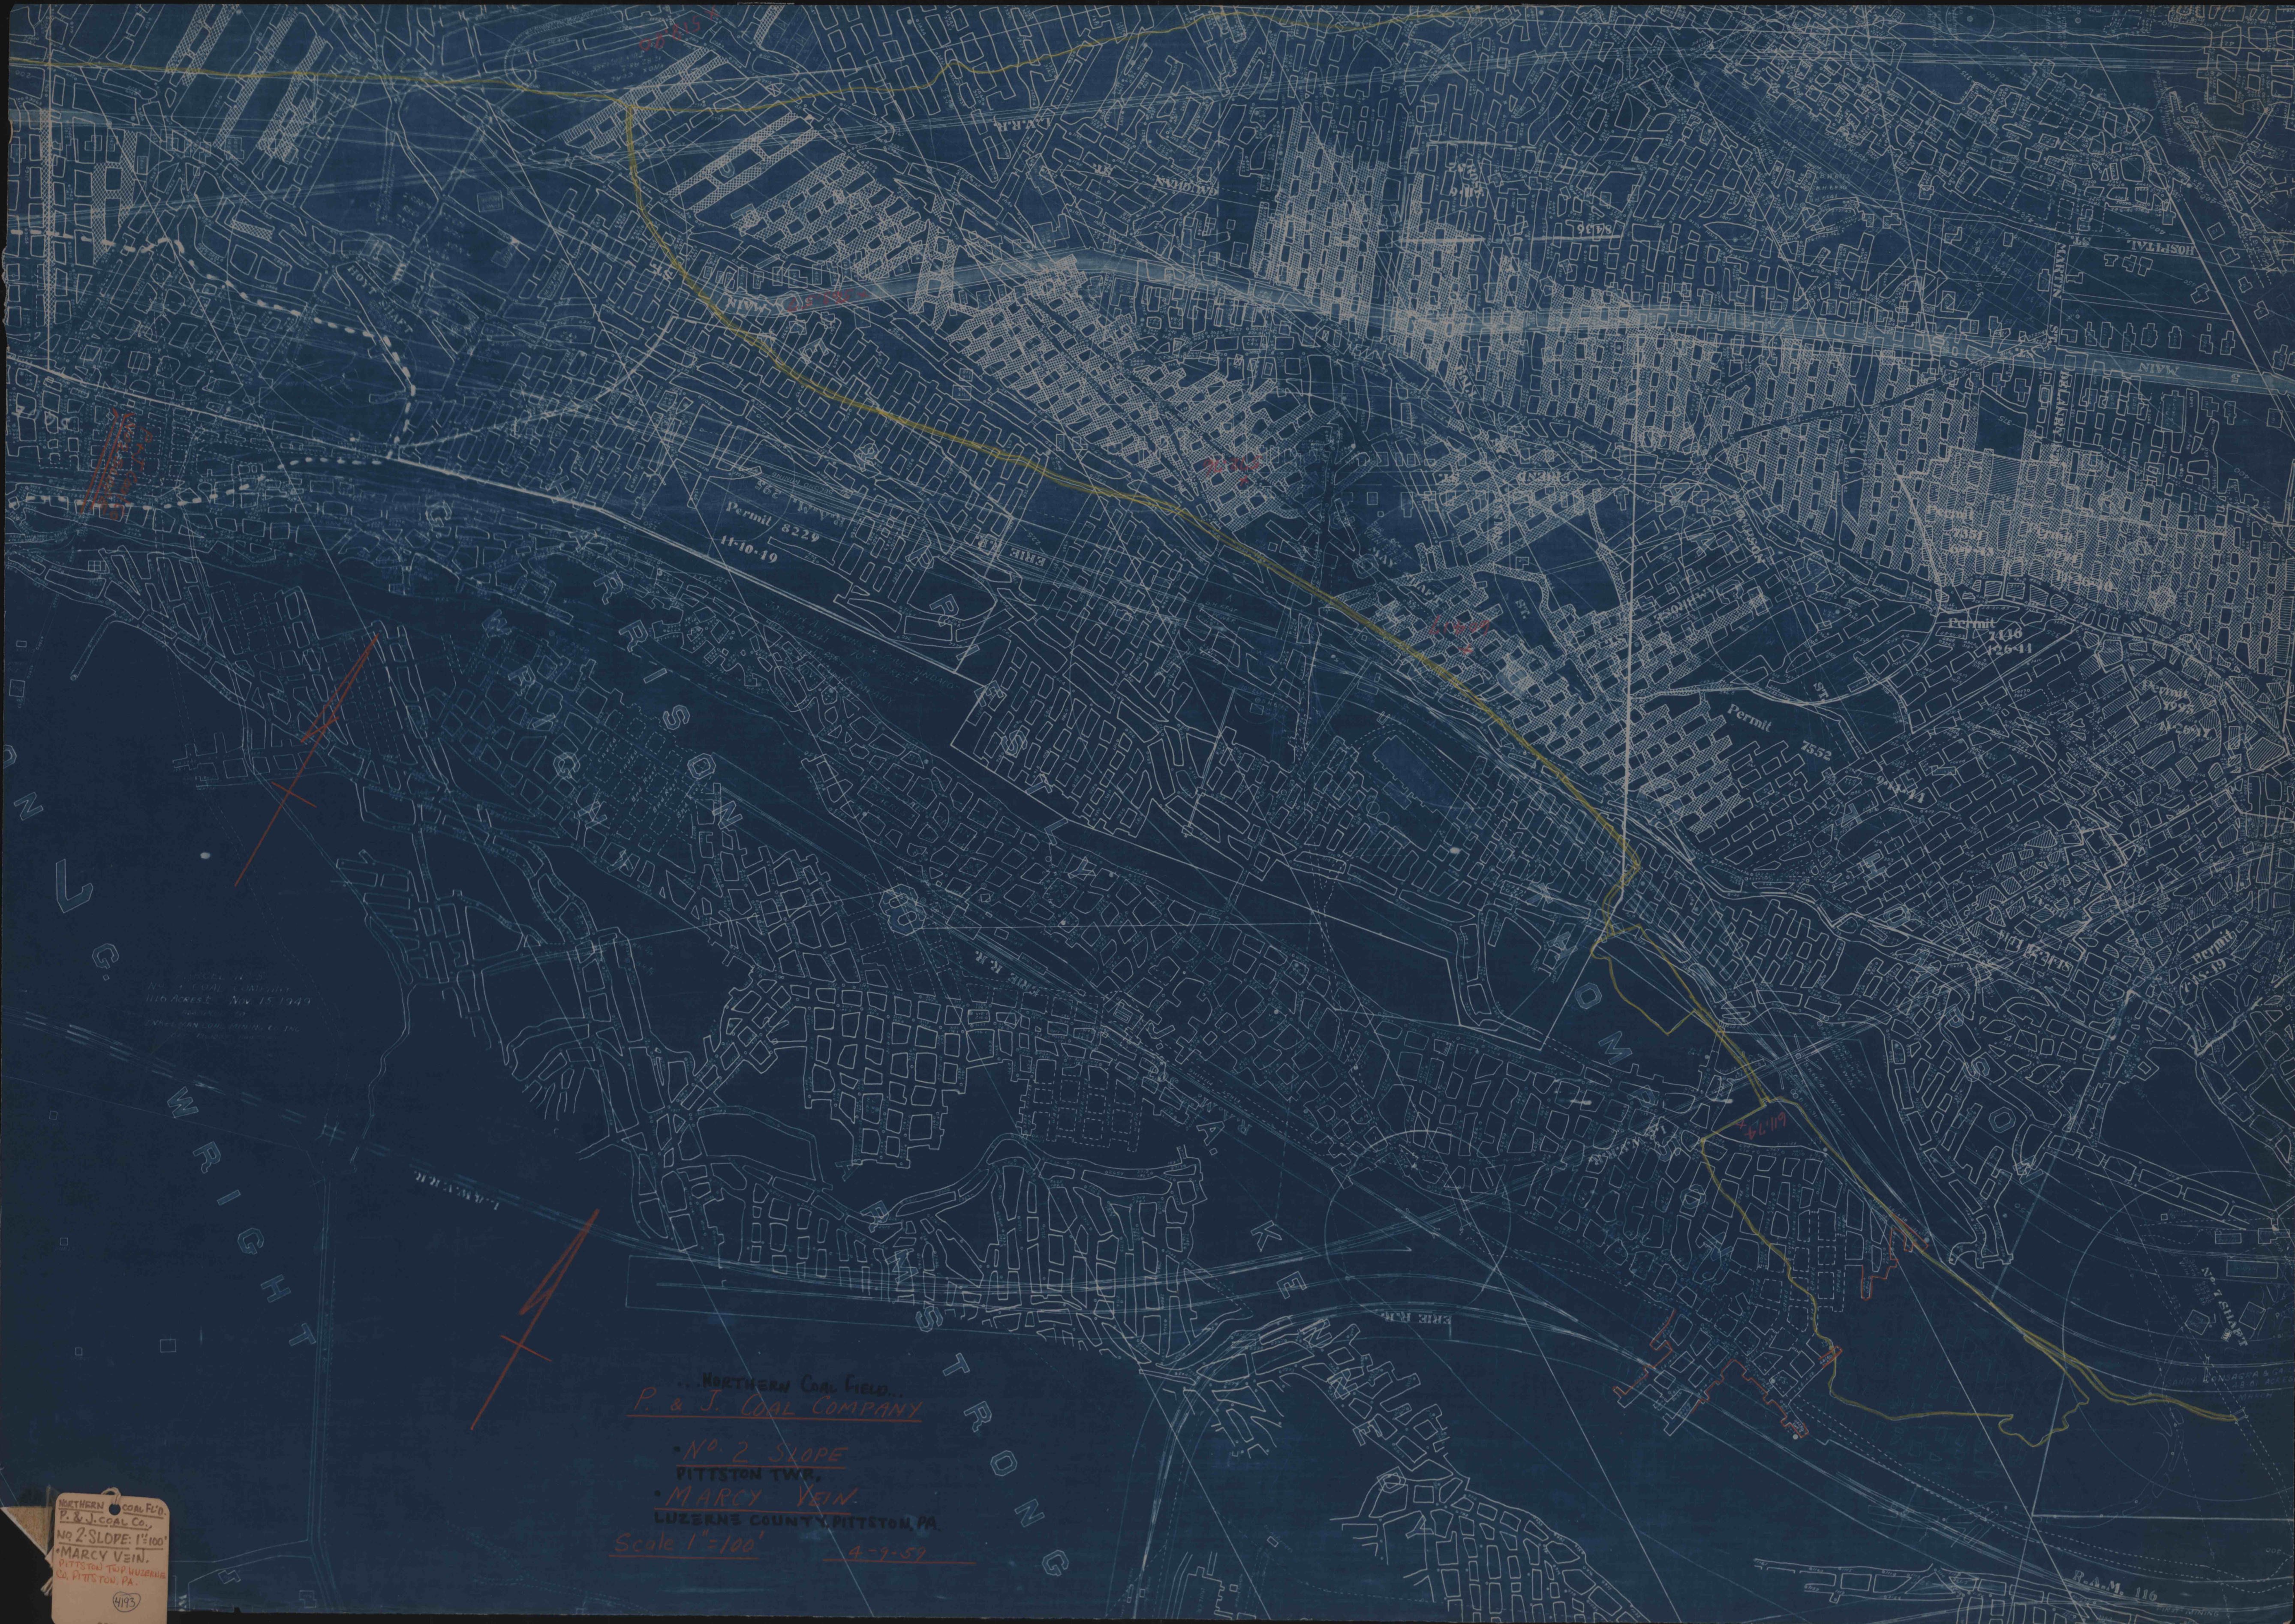

NORTHERN COAL FIELD
P. & J. COAL COMPANY
No 2 SLOPE
MARCY VEIN
Scale 1"=100' 4-7-57

NORTHERN COAL FIELD
P. & J. COAL CO.
No 2 SLOPE: 1"=100'
MARCY VEIN
4193
PRINT.