


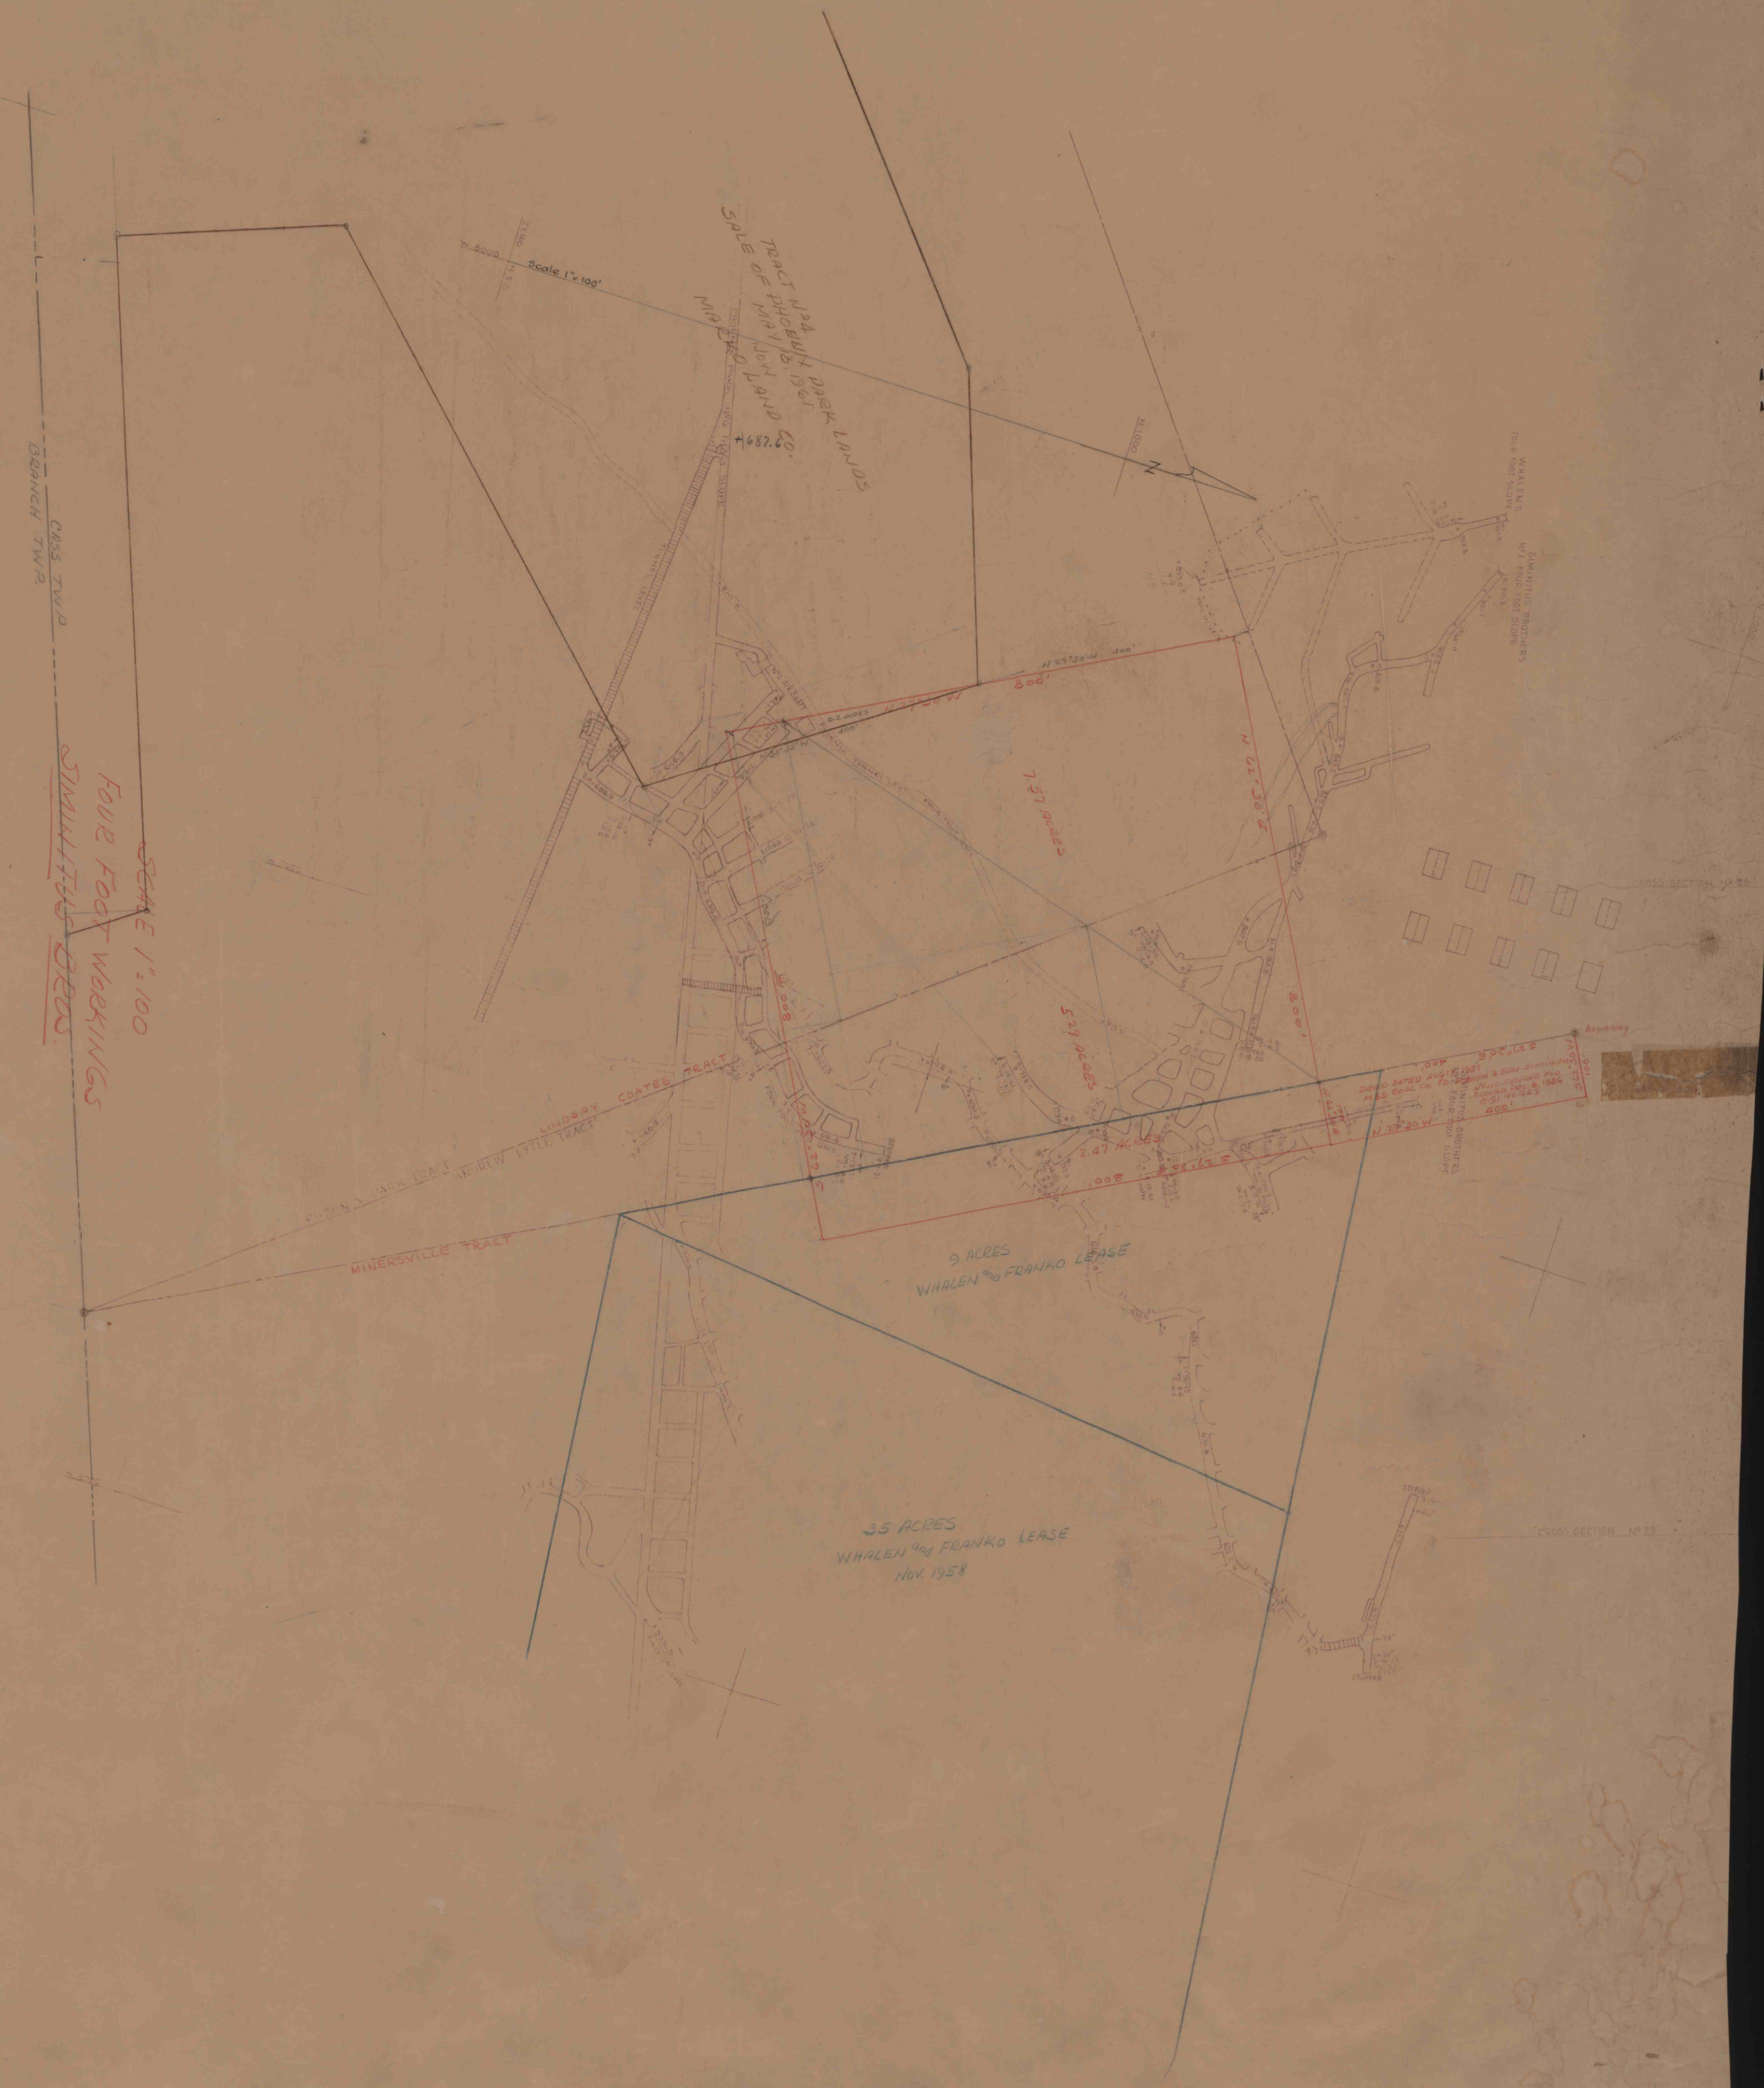

SCALE 1"=100
FOUR FOOT WORKINGS
SIMULTANEOUS DEPOS.

