

LYKENS VALLEY SLOPE

HEGINS TWP, SCHUYLKILL CO., PENNA.


OPERATOR - ROY MORGAN & SONS

SCALE 1"=100'

N. 40° E. MERIDIAN - DATUM - MEAN TIDE - JULY 8-49

D. H. DUNBAR, M.E.

PA. REG. 10137

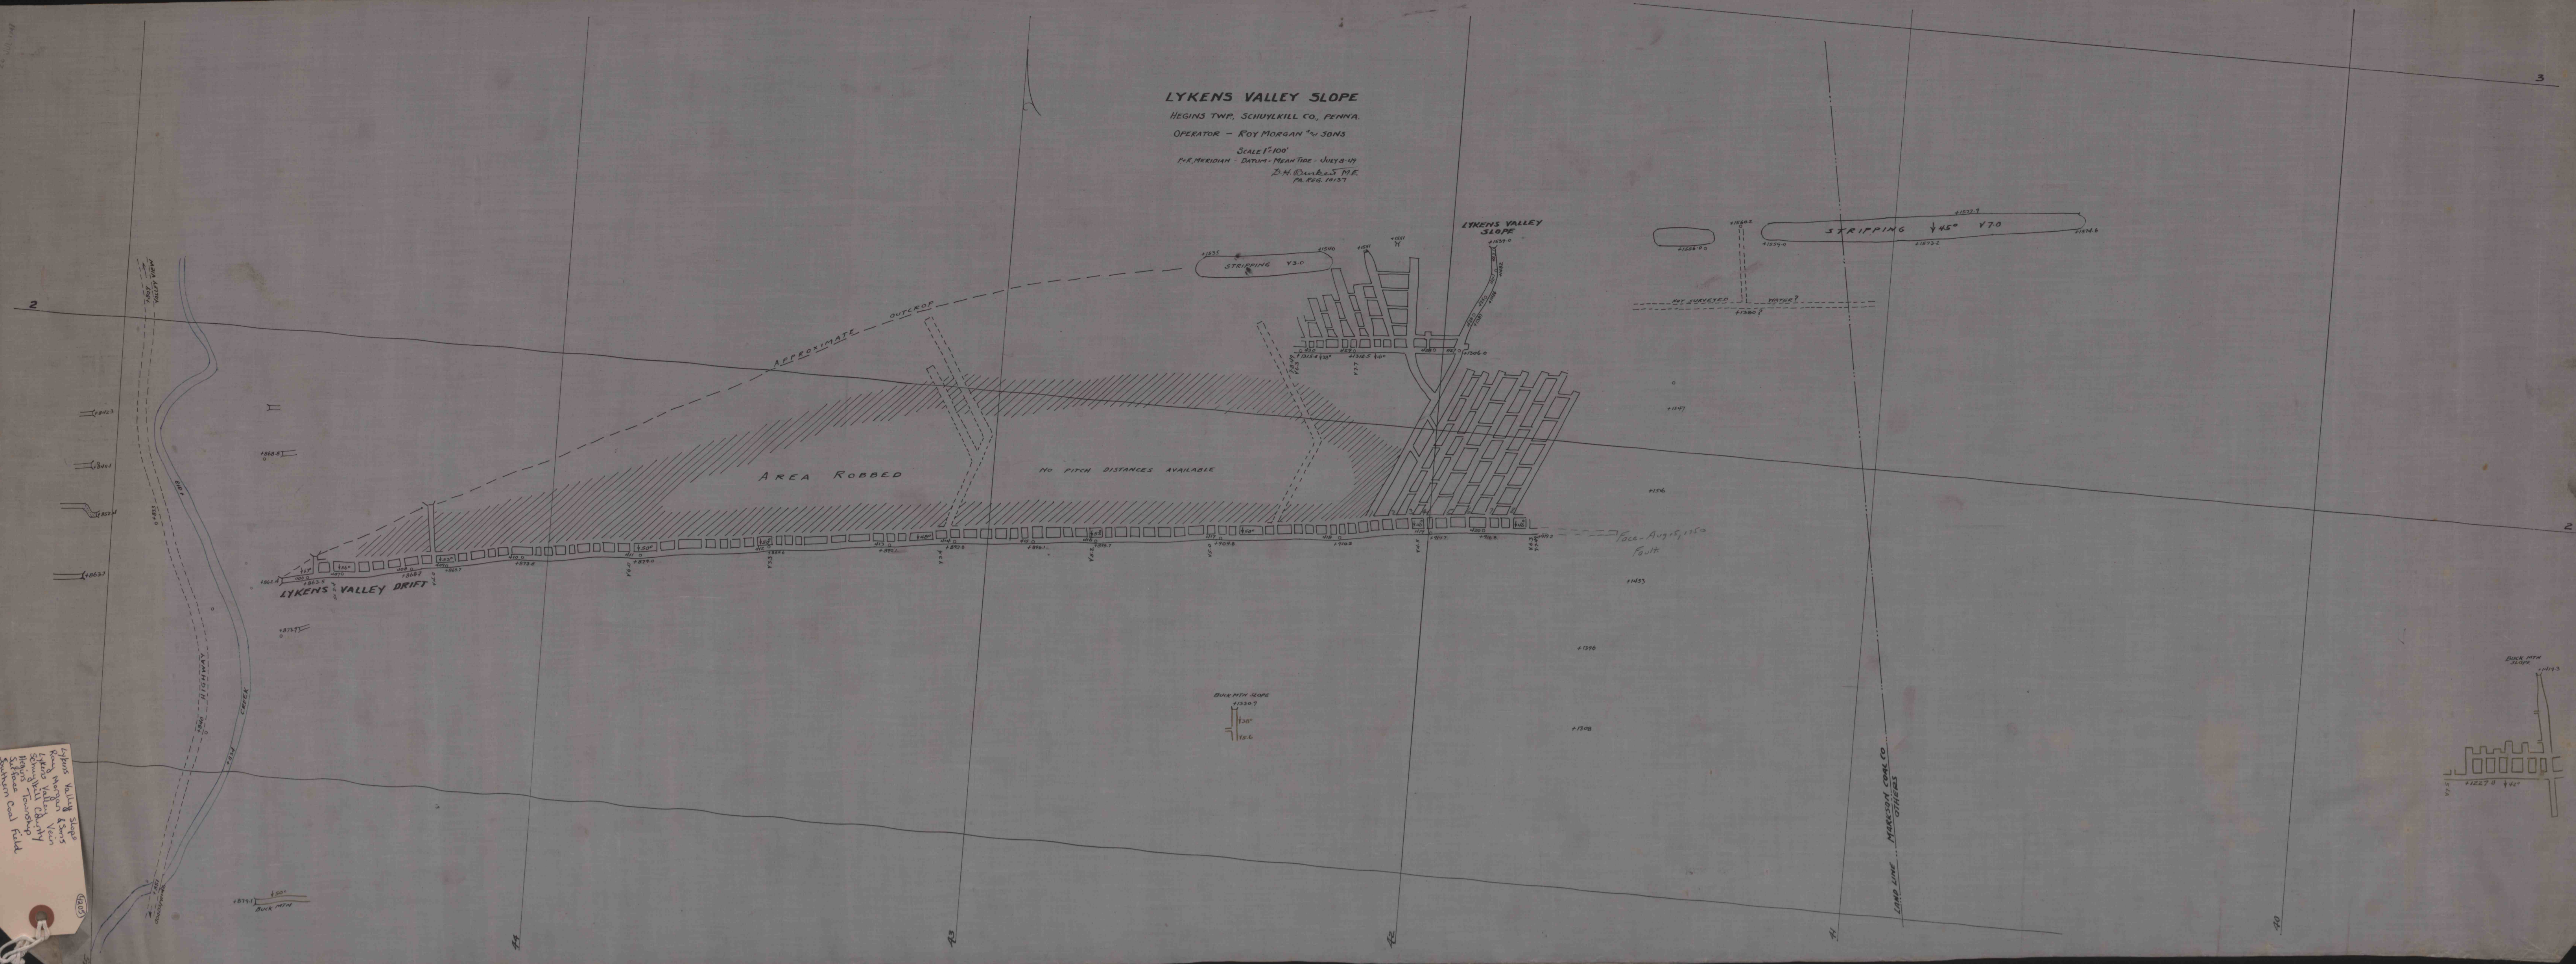

Lykens Valley Slope
Roy Morgan & Sons
Lykens Valley
Schuylkill County
Hegins Township
