


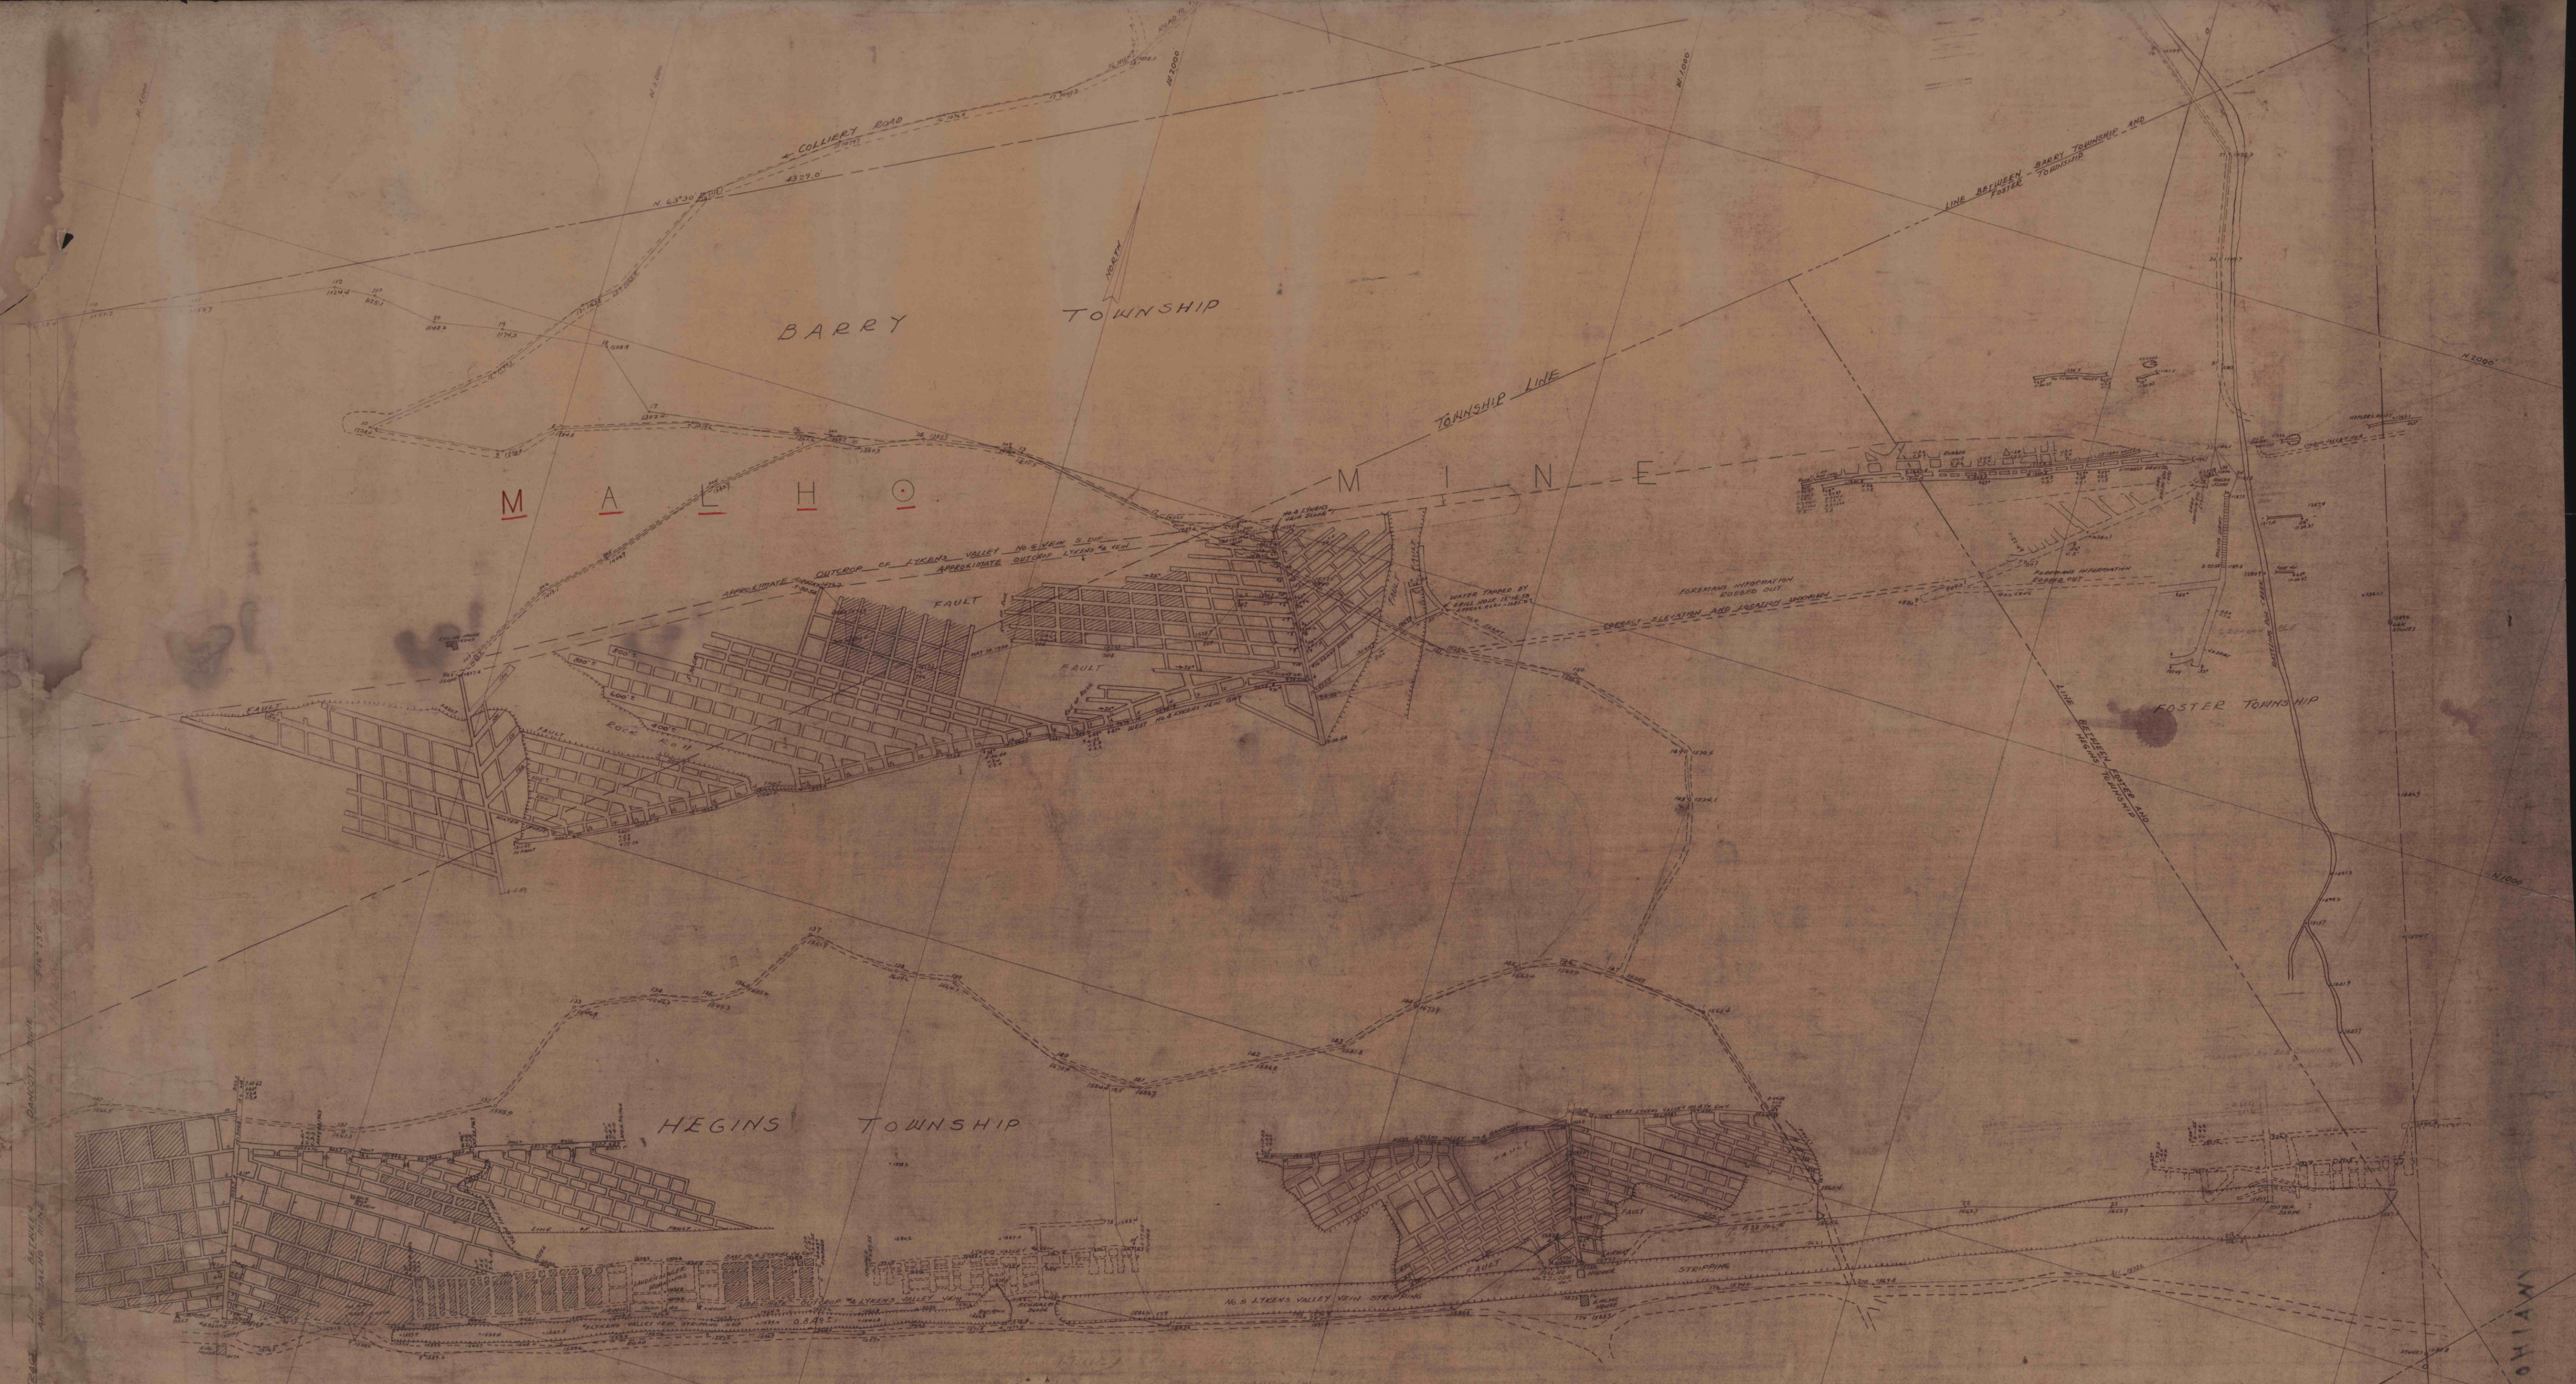

SOUTHERN COAL FIELD.

NORTH DIP, SITUATE IN HEGINS TOWNSHIP, SCHUYLKILL COUNTY, PENNA.

Scale: 1"=100' POTTSVILLE, PENNA. . . . J. C. BRIEL, JR.,
REG. SURVEYOR #6307E

MAR 2 1 1977


OCT. 24, 1963. . . .
POSTED: APRIL 30, 1964.



