


NATIONAL EAST SECTION
N° 2 DUNMORE VEIN
SLIDE - N° 10-2

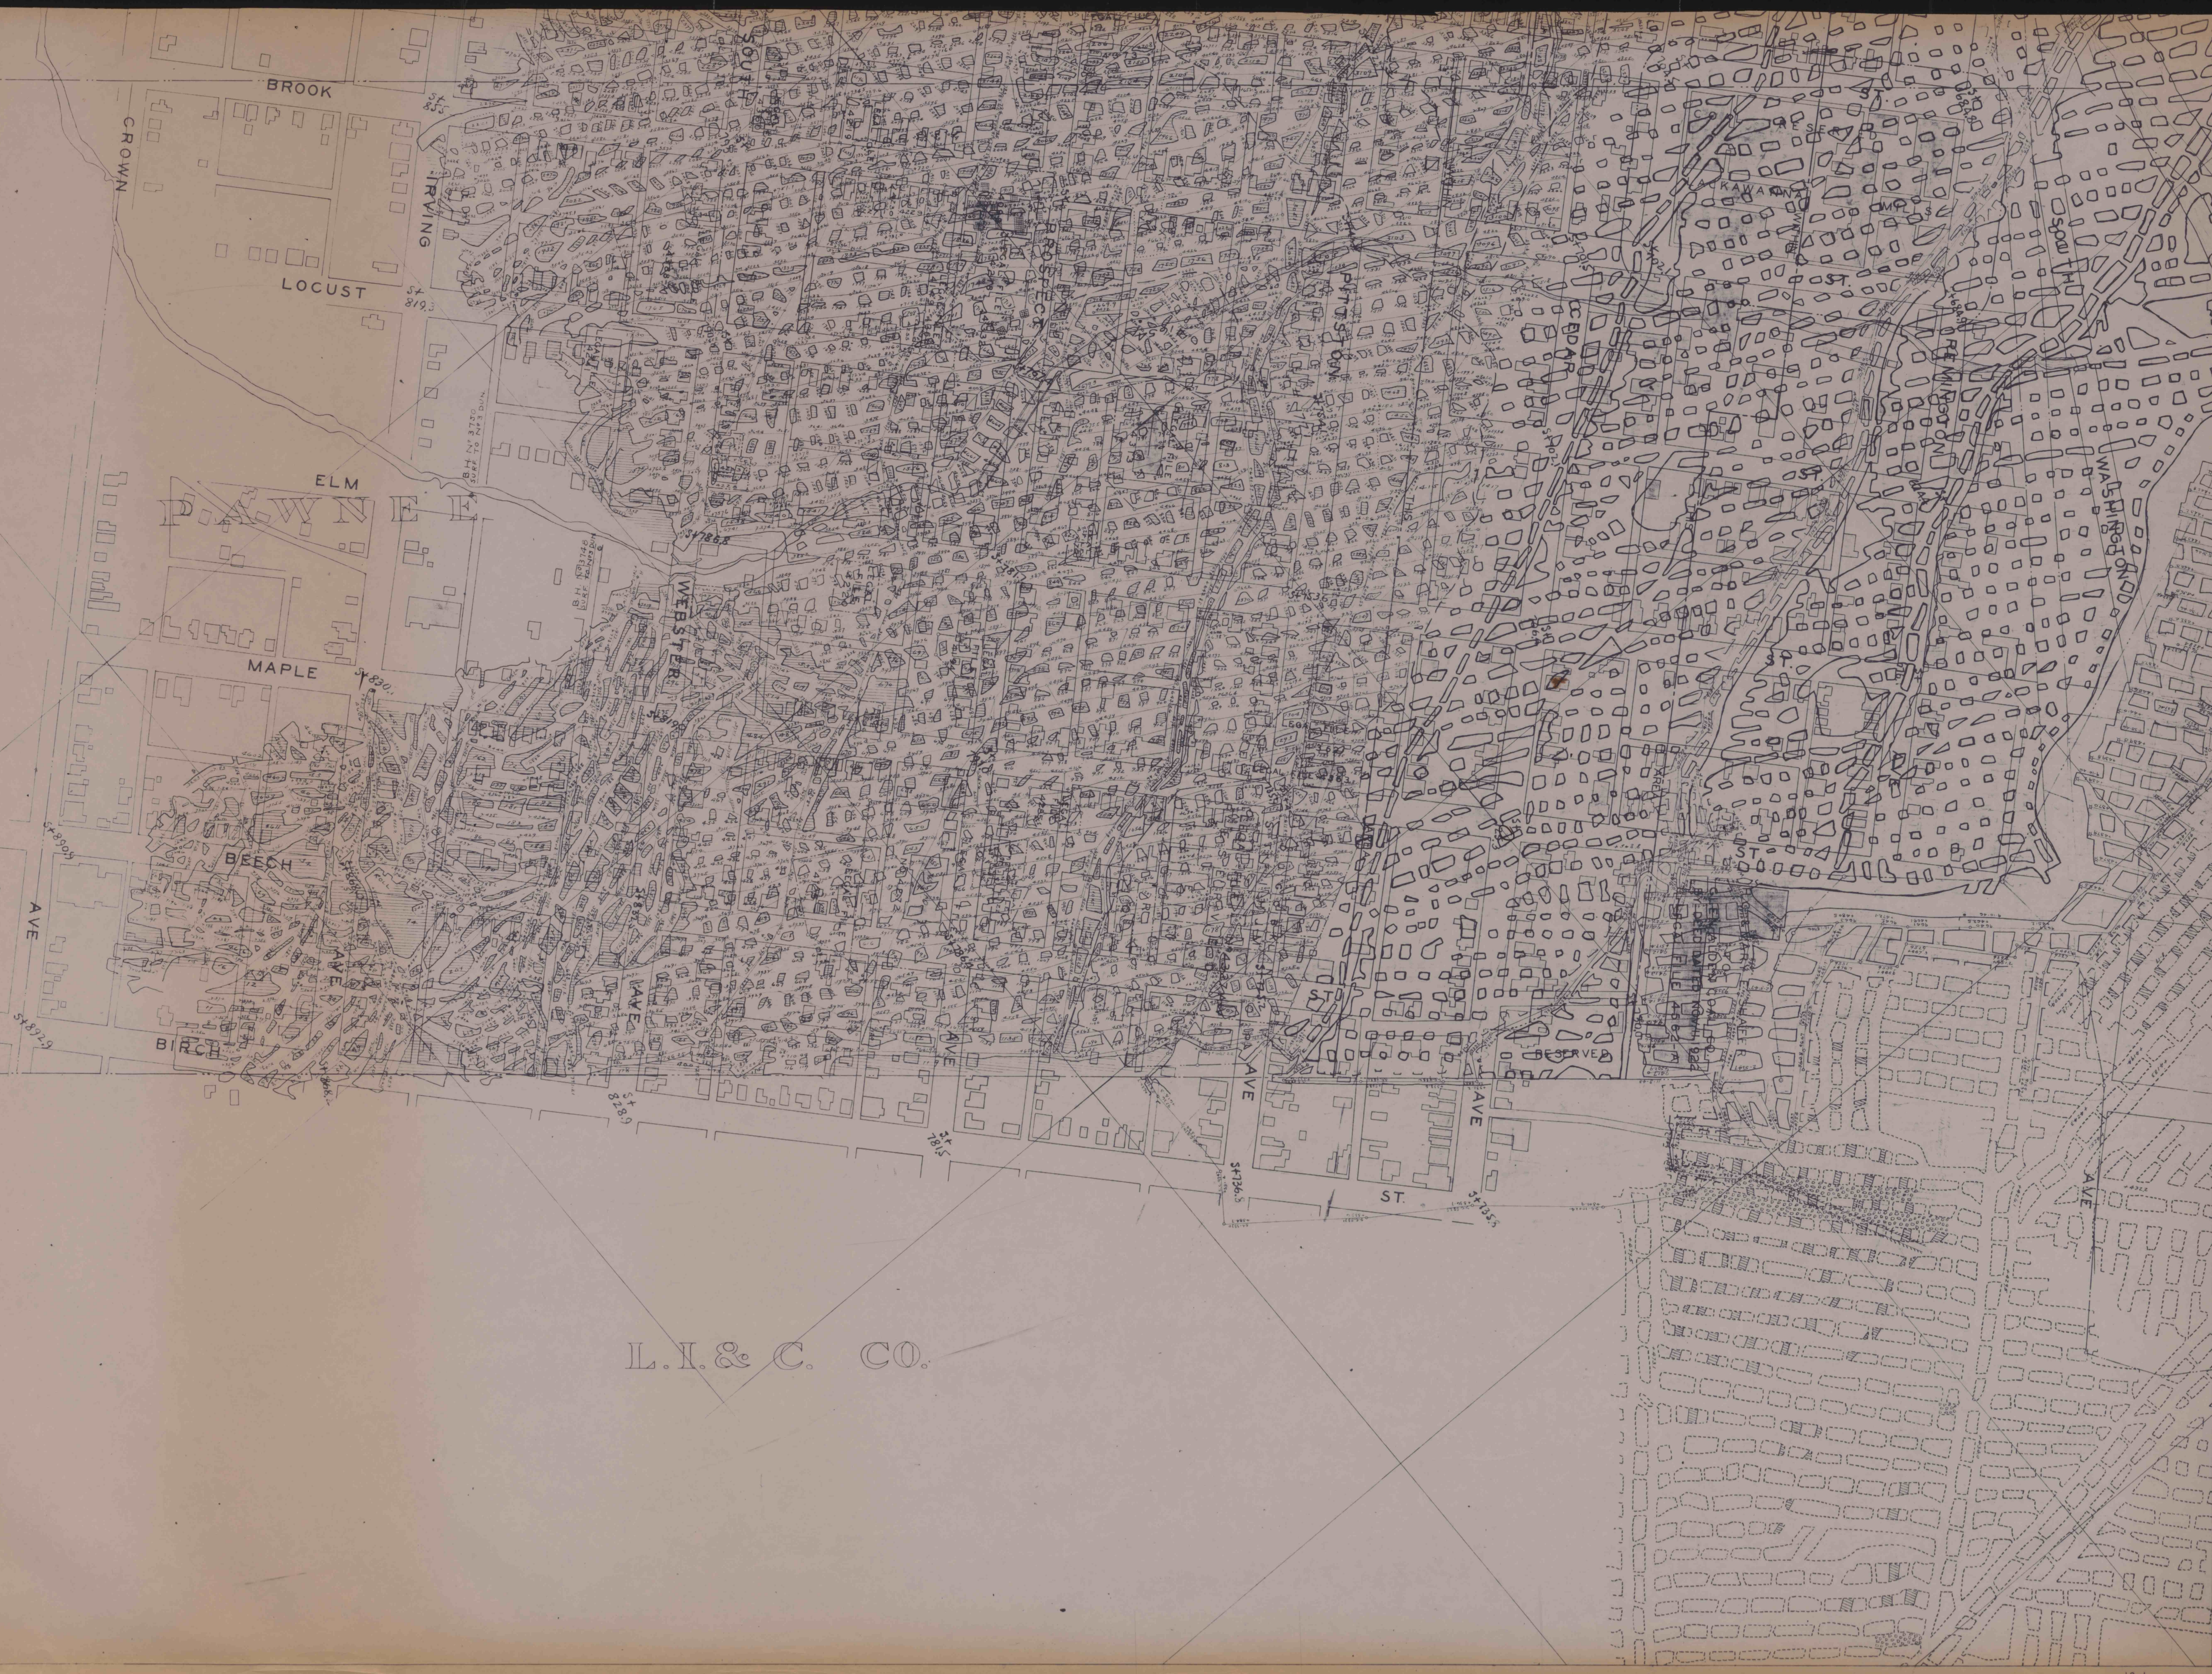

NATIONAL EAST SECTION
N° 2 DUNMORE VEIN
SLIDE - N° 10-2

