


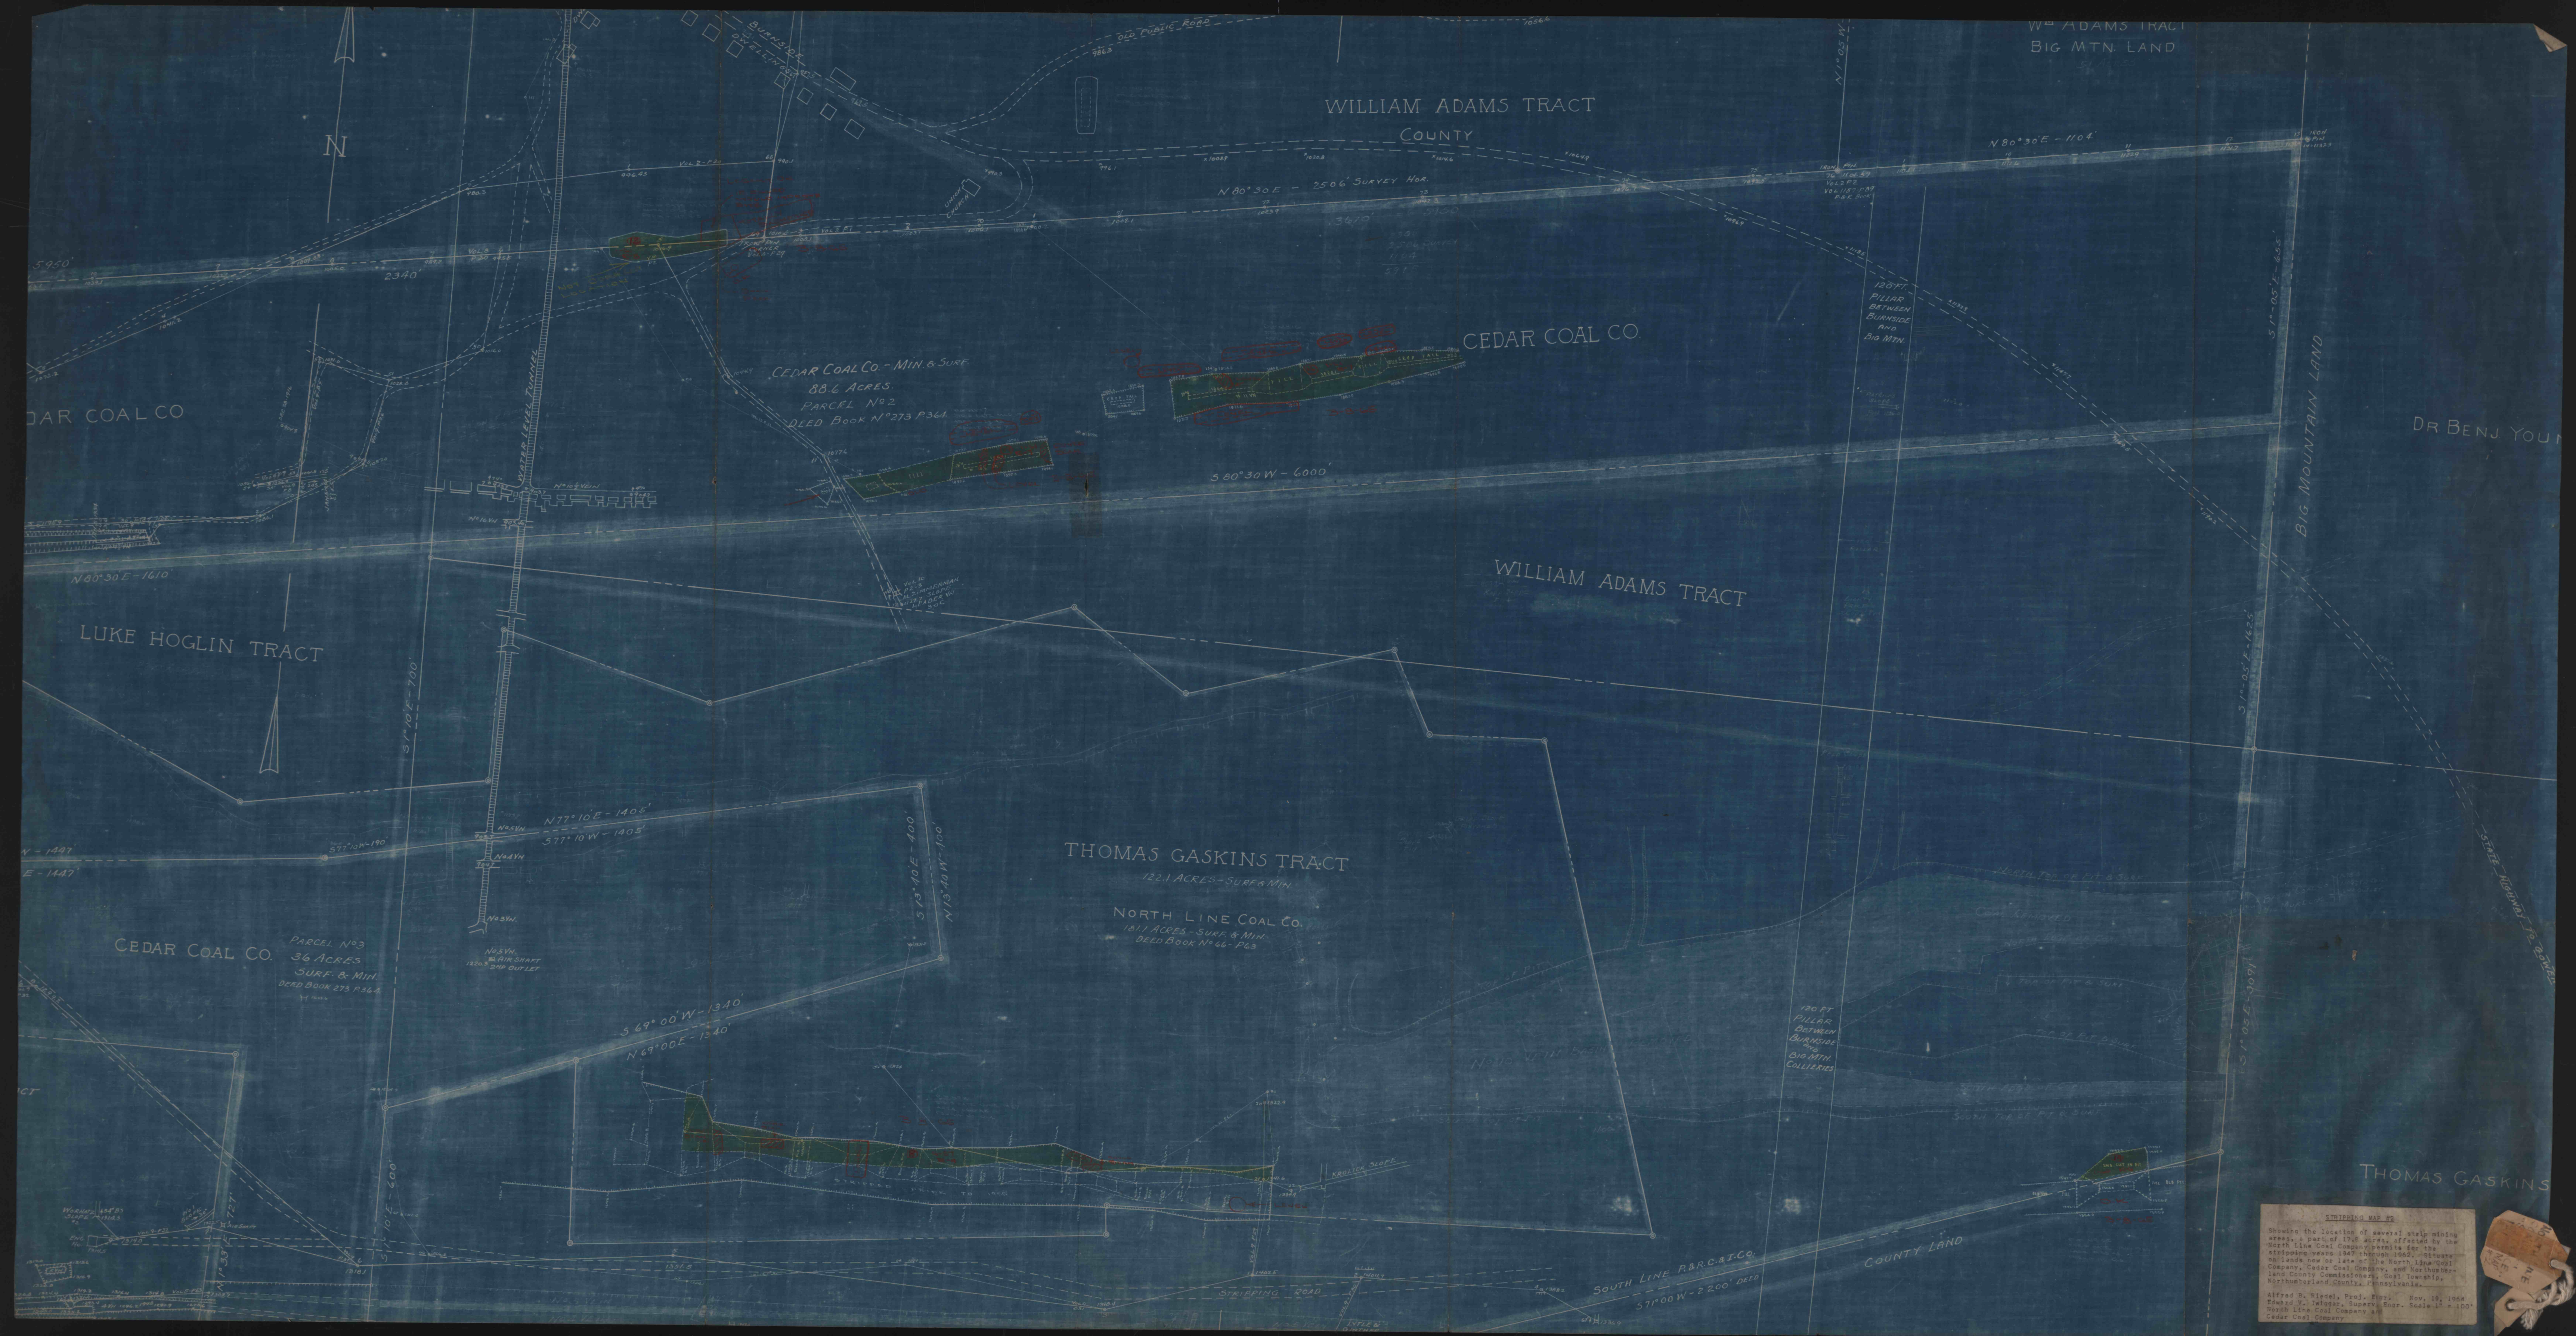

WILLIAM ADAMS TRACT
COUNTY

W^m ADAMS TRACT
BIG MTN. LAND

CEDAR COAL CO.

CEDAR COAL CO. - MIN. & SURF.
88.6 ACRES.
PARCEL No 2
DEED BOOK No 273 P 364

WILLIAM ADAMS TRACT

LUKE HOGLEIN TRACT

THOMAS GASKINS TRACT

NORTH LINE COAL CO.
1811 ACRES - SURF & MIN.
DEED BOOK No 46 - P 63

CEDAR COAL CO. PARCEL No 3
36 ACRES
SURF. & MIN.
DEED BOOK 273 P 364

THOMAS GASKINS

Alfred R. Hadel, Prof. Eng. Nov. 19, 1960
Edward V. Winger, Superv. Engr. Scale 1" = 100'
North Line Coal Company and Cedar Coal Company