


DELANEY

GEORGE GROH JR

AUGUST LAVENBURG

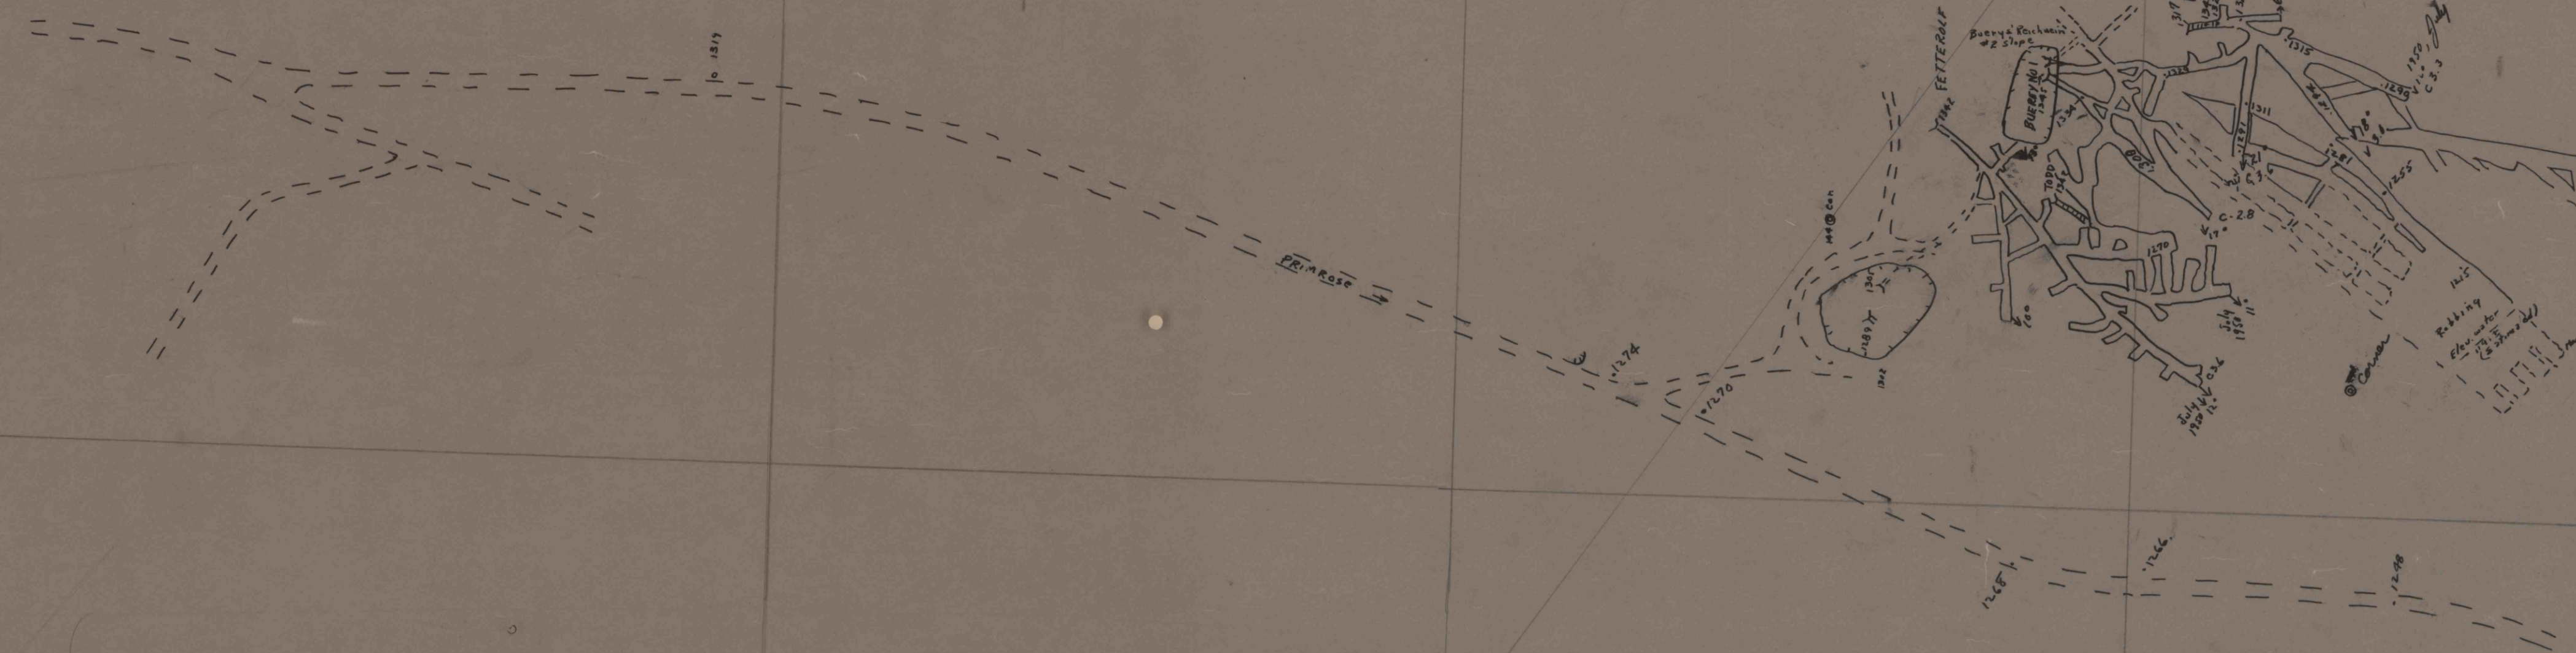

PHINEAS FREEMAN

Location of mining
off # 122 Slopes of Rockwell
& Bury on South Dip of
Seven Ft vein.
1" = 100'

In Red is
Shampers' interpretation
of how working
on Seven Ft vein
to Scott workings
Scott + 1211
Scott workings
band
dashed lines may
be wrong according
to Shampers

1" = 100'