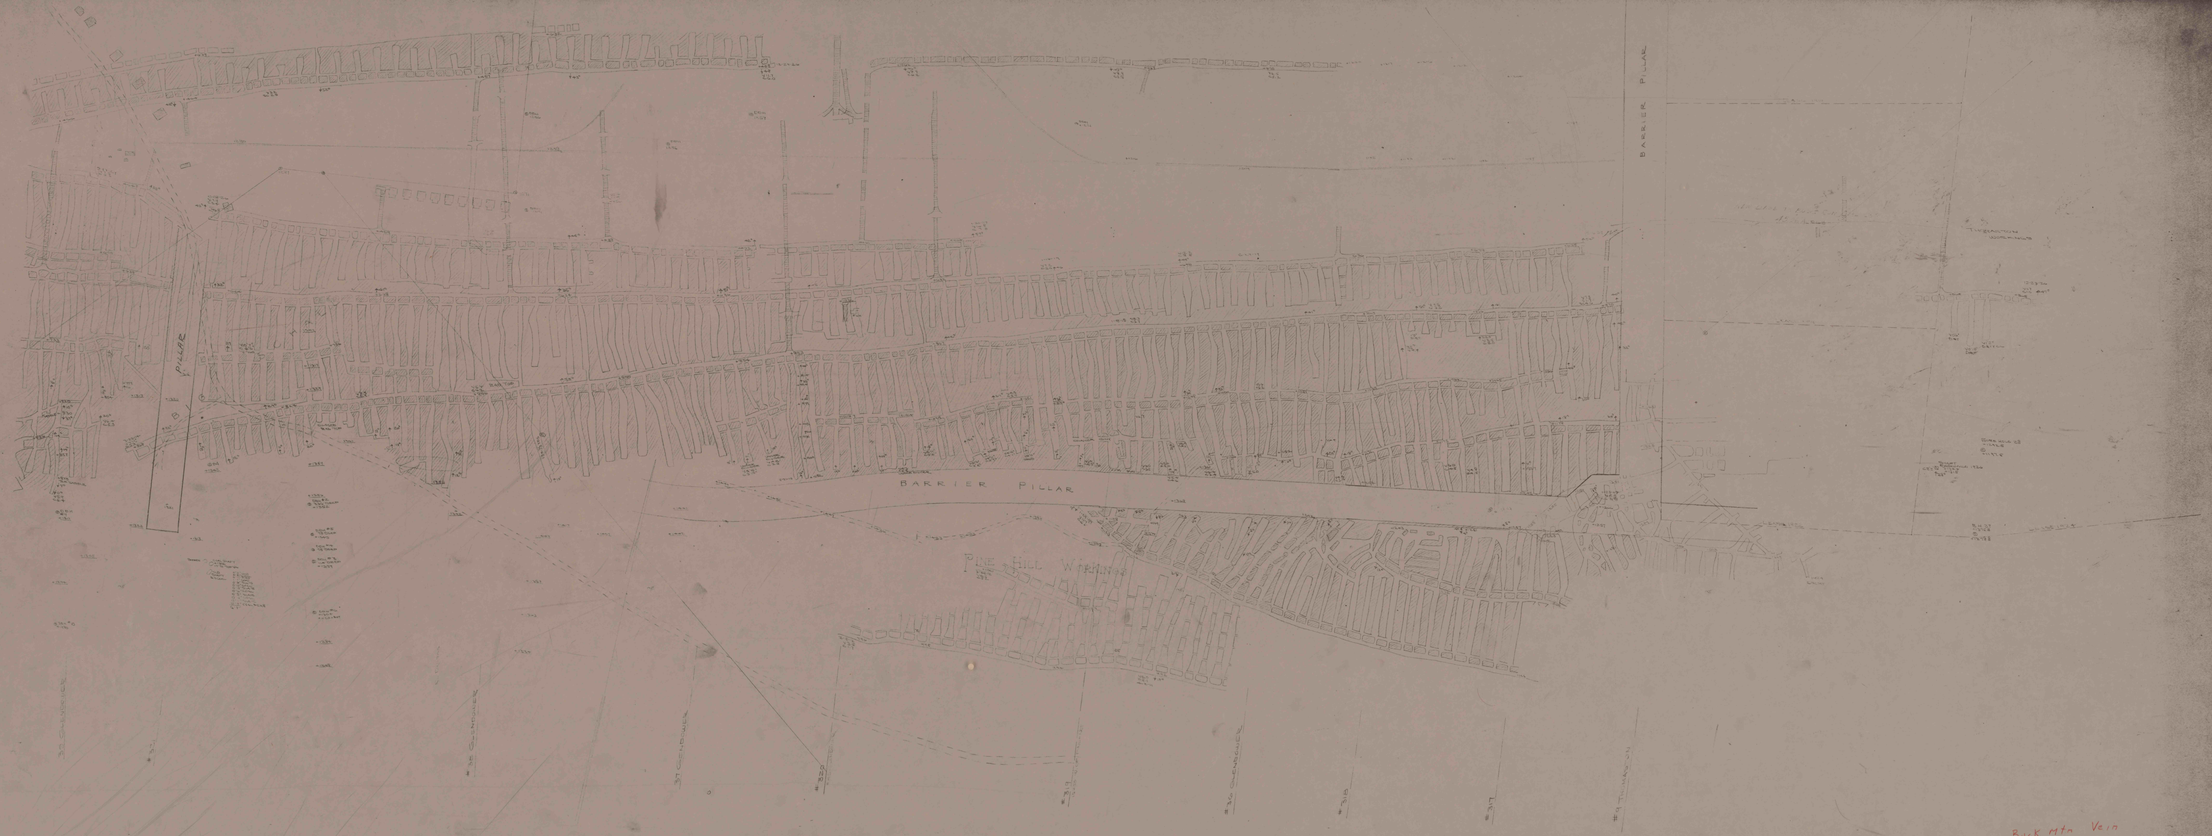

Buck Mtn Vein
Buck Run Area

Buck rtn Vein
Buck Run, Pine Hill
& Thomaston workings