


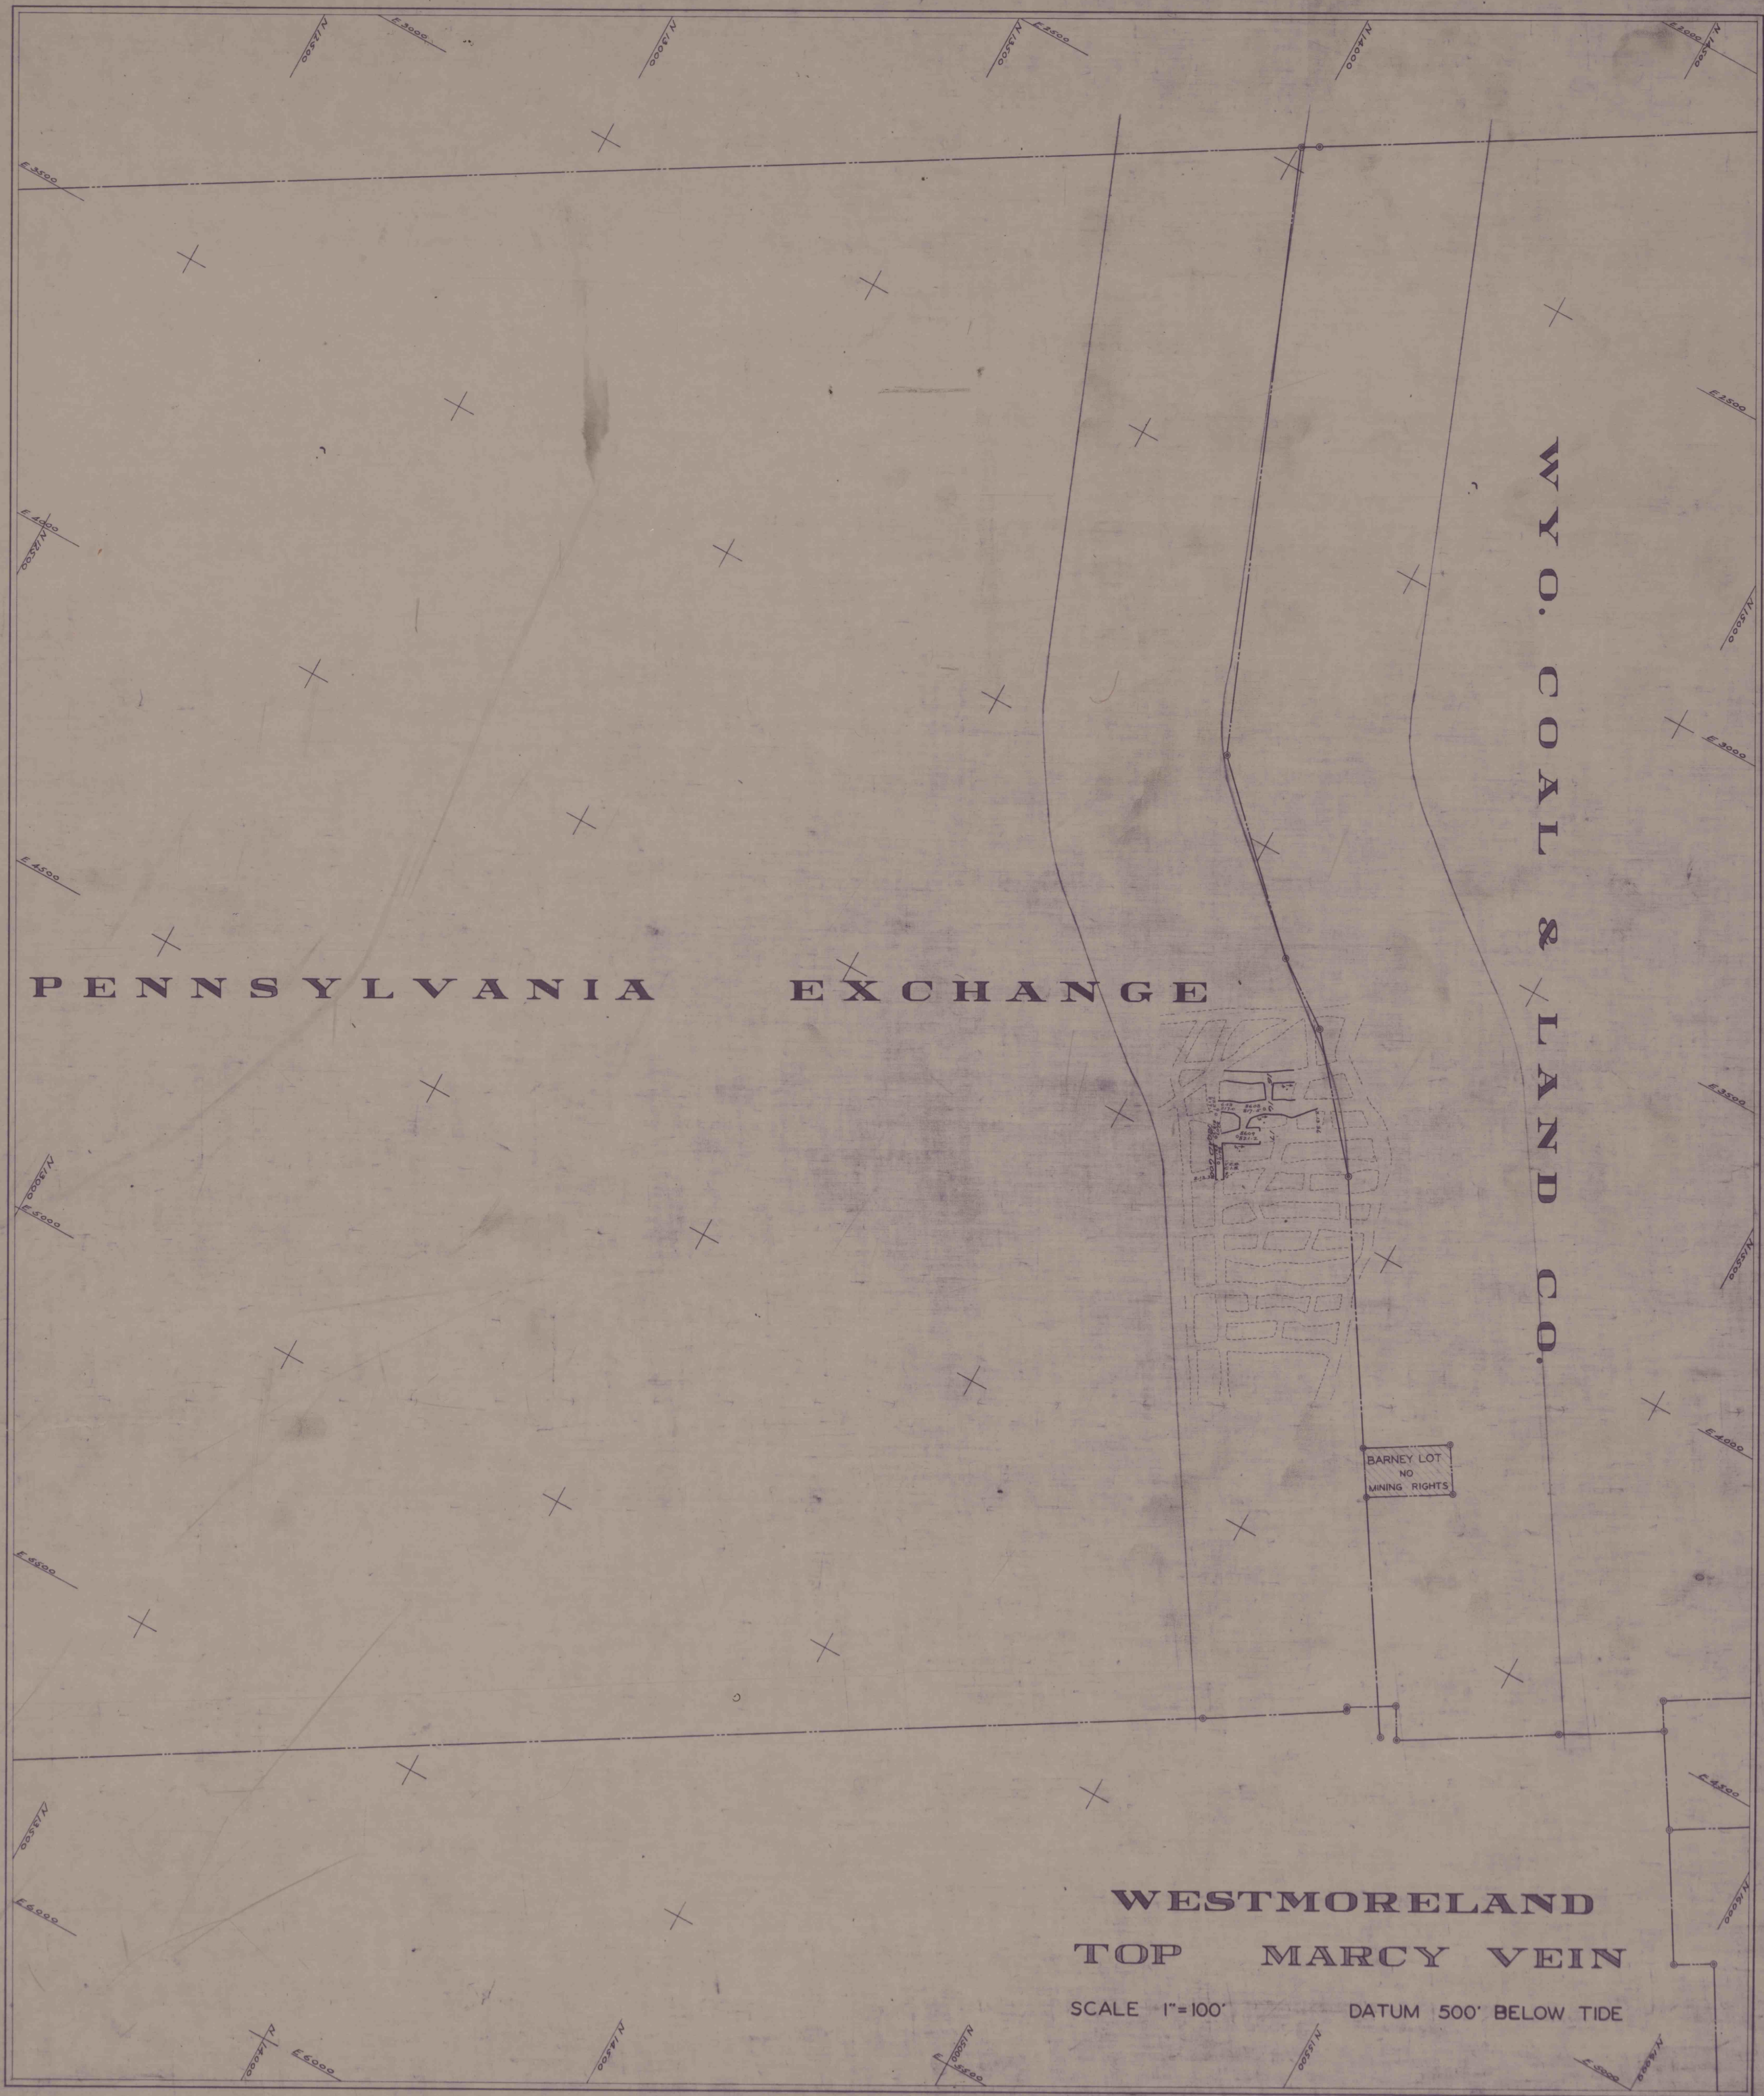

PENNSYLVANIA

EXCHANGE

WYO. COAL & LAND CO.

BARNEY LOT
NO
MINING RIGHTS

WESTMORELAND
TOP MARCY VEIN

SCALE 1"=100'

DATUM 500' BELOW TIDE