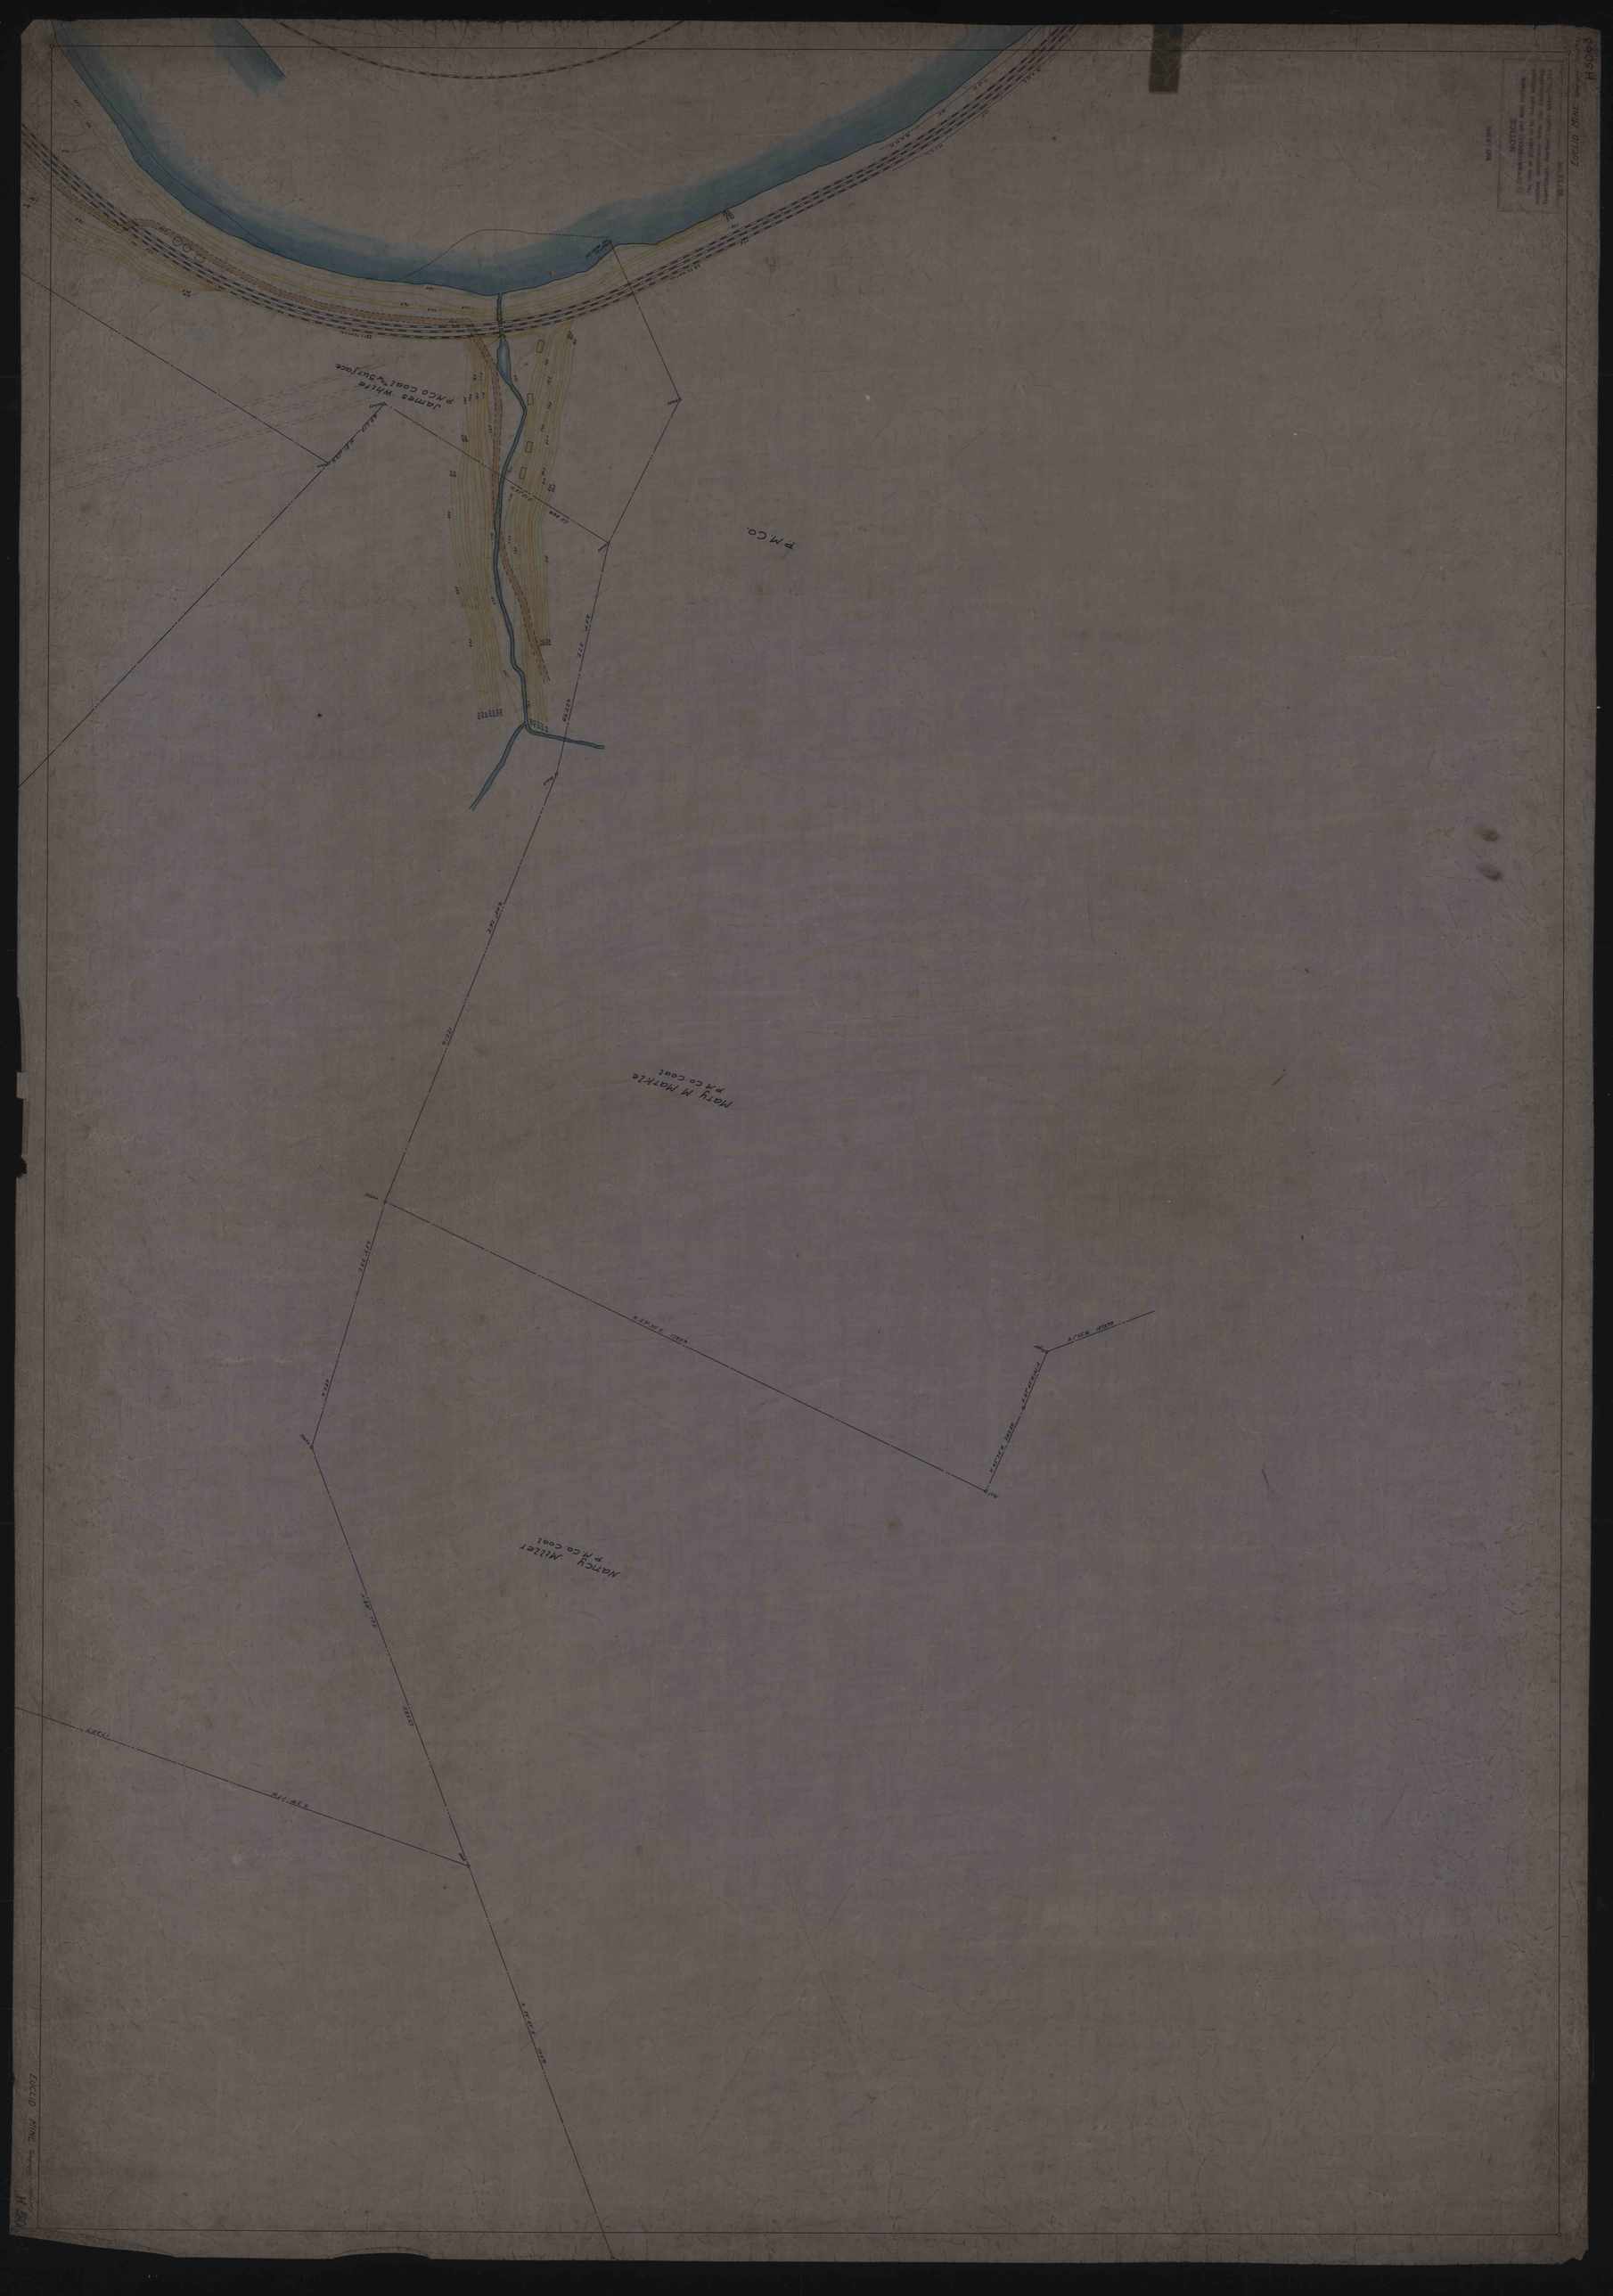
EUCLID MINE
NOTICE
P.M. CO.
James White
P.M.Co Coal Surface
Mary M Mattle
P.M. Co Coal
Nancy Miller
P.M. Co Coal