


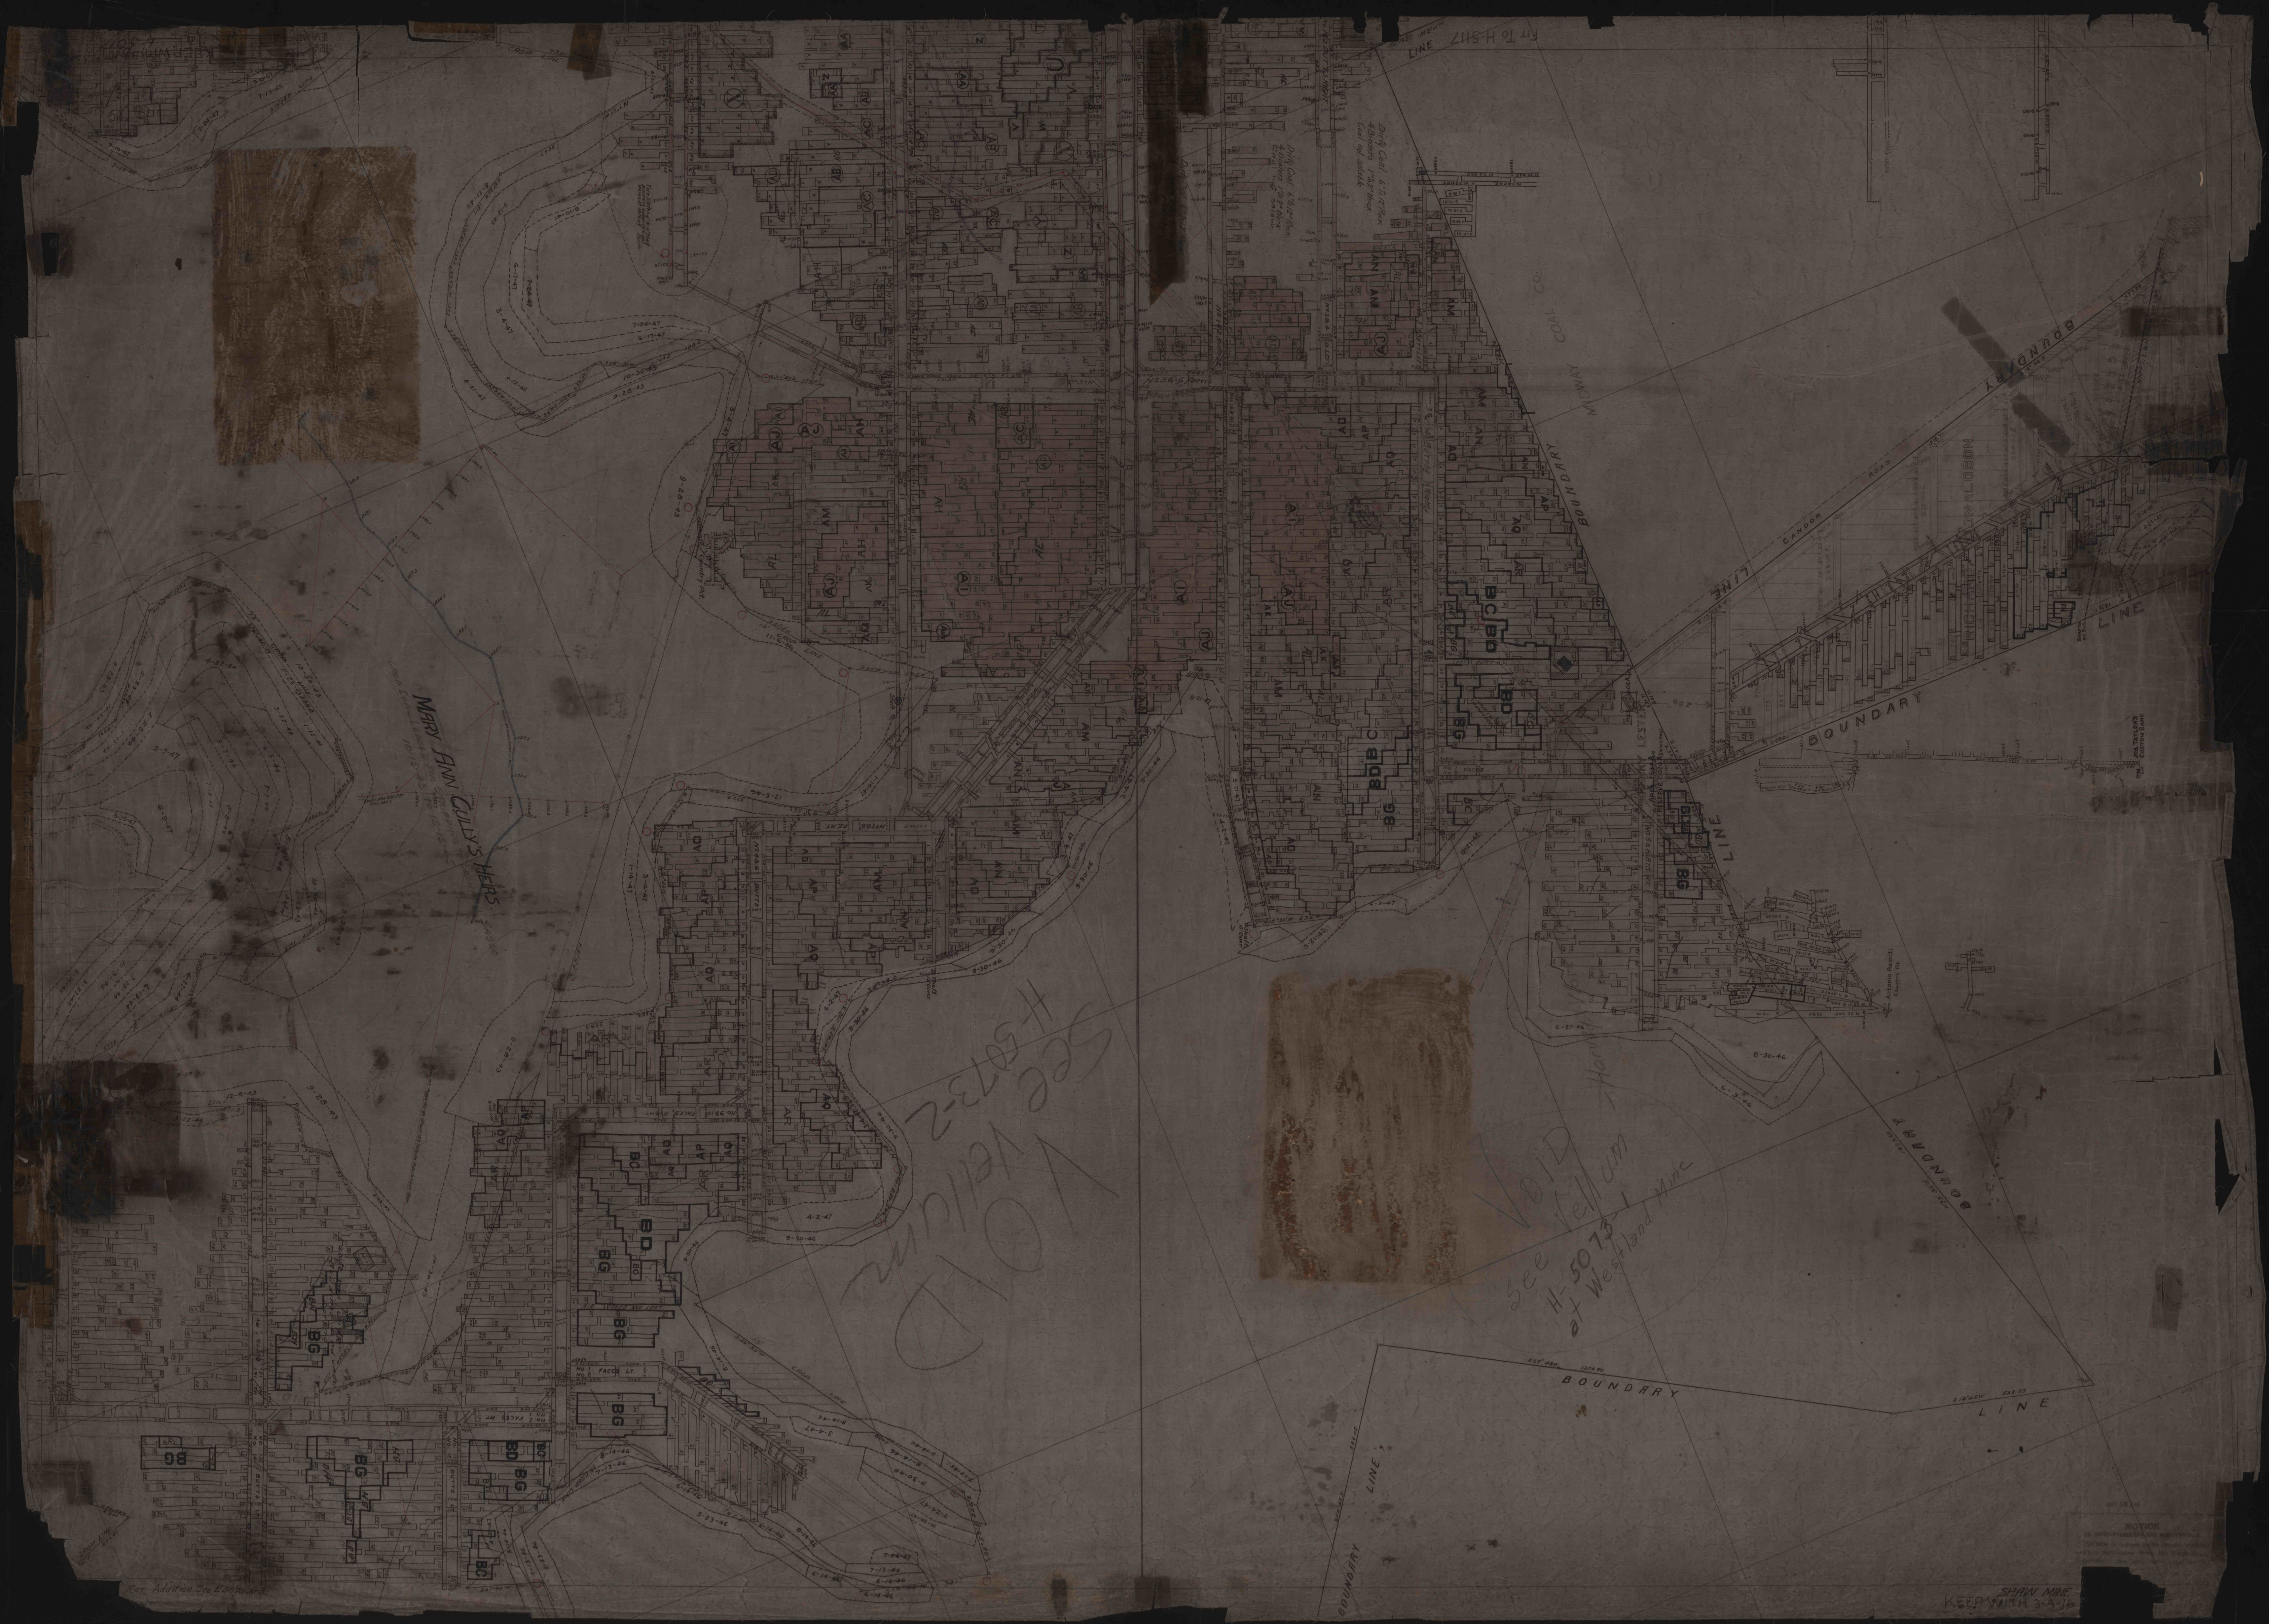

MAY ANN CUL'S HERS

SEE VELLUM
H-5073-2

VOID
see vellum
H-5073-1
at Westland Mine

SHIN MINE
KEEP WITH 3-A-16