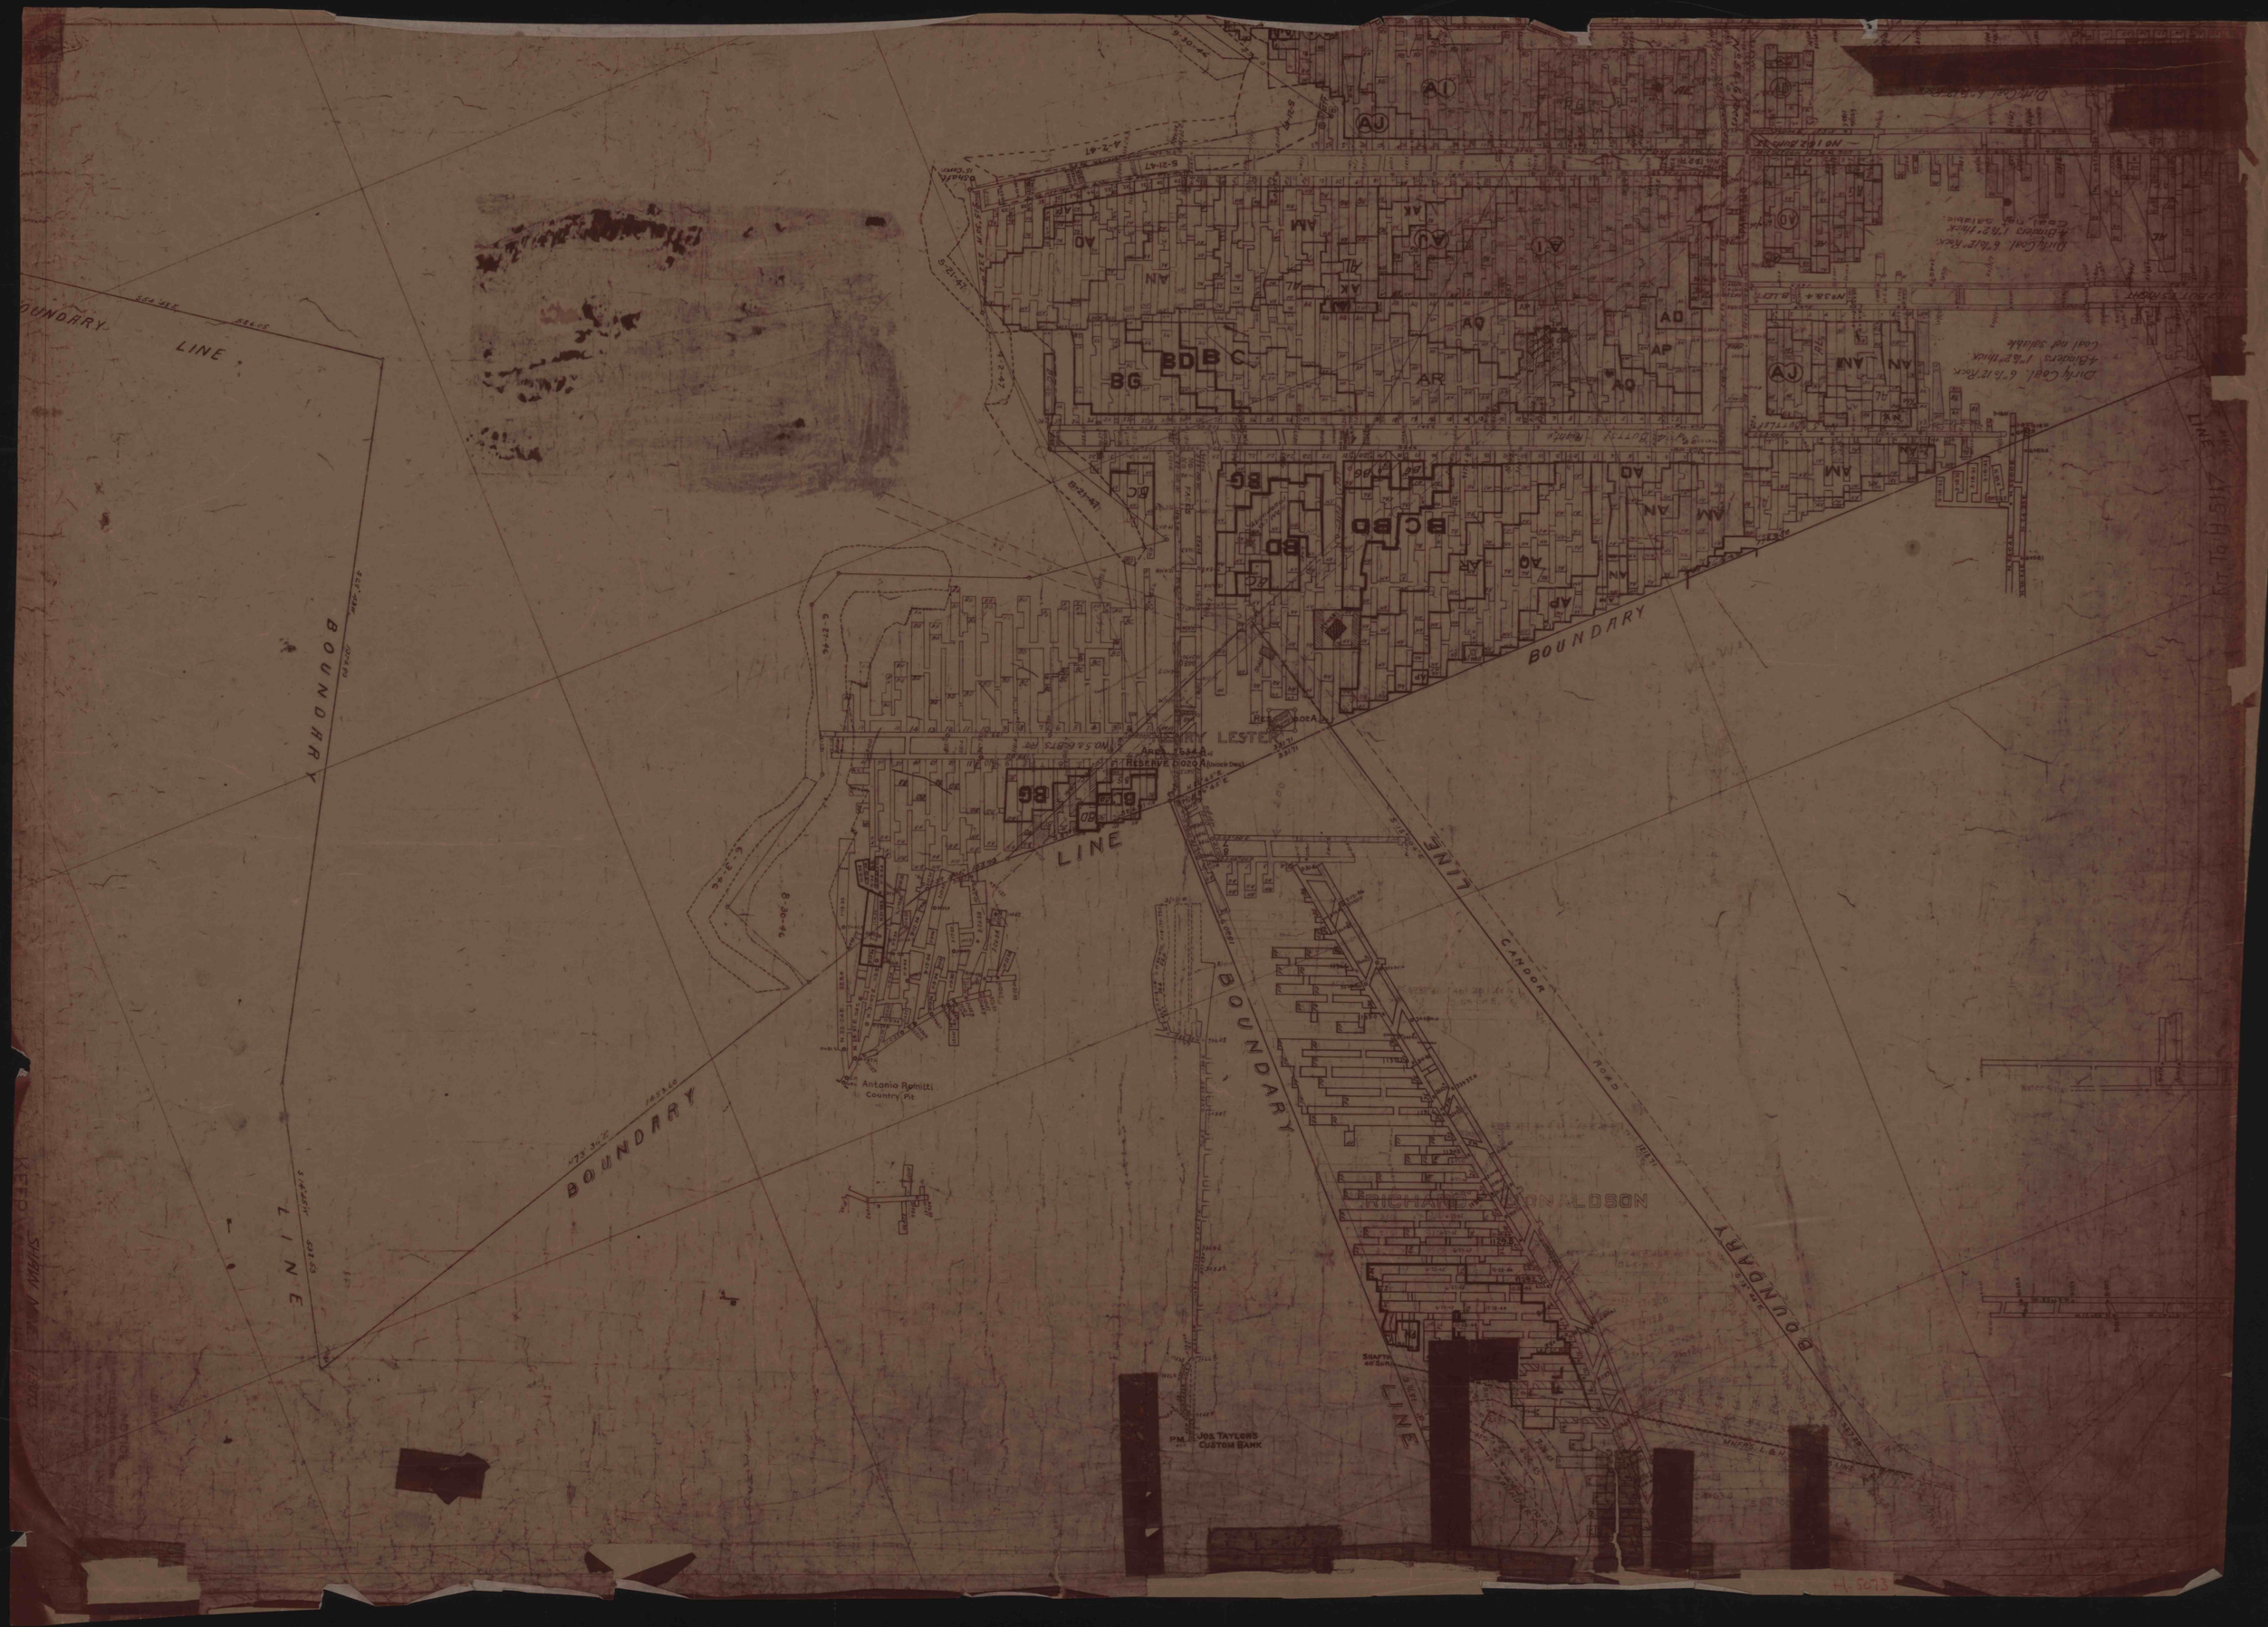
BOUNDARY LINE
BOUNDARY LINE
BOUNDARY LINE
BOUNDARY LINE
BOUNDARY LINE
BOUNDARY LINE
CANDOR ROAD
RESERVE 10020 A
Antonio Romitti
Country Pit
Jos. Taylors
Custom Bank
RICHARD DONALDSON
Dirty Coal 6'to 12' thick
Coal not saleable
Dirty Coal 6'to 12' thick
Coal not saleable
SHAM MINE LIMITS