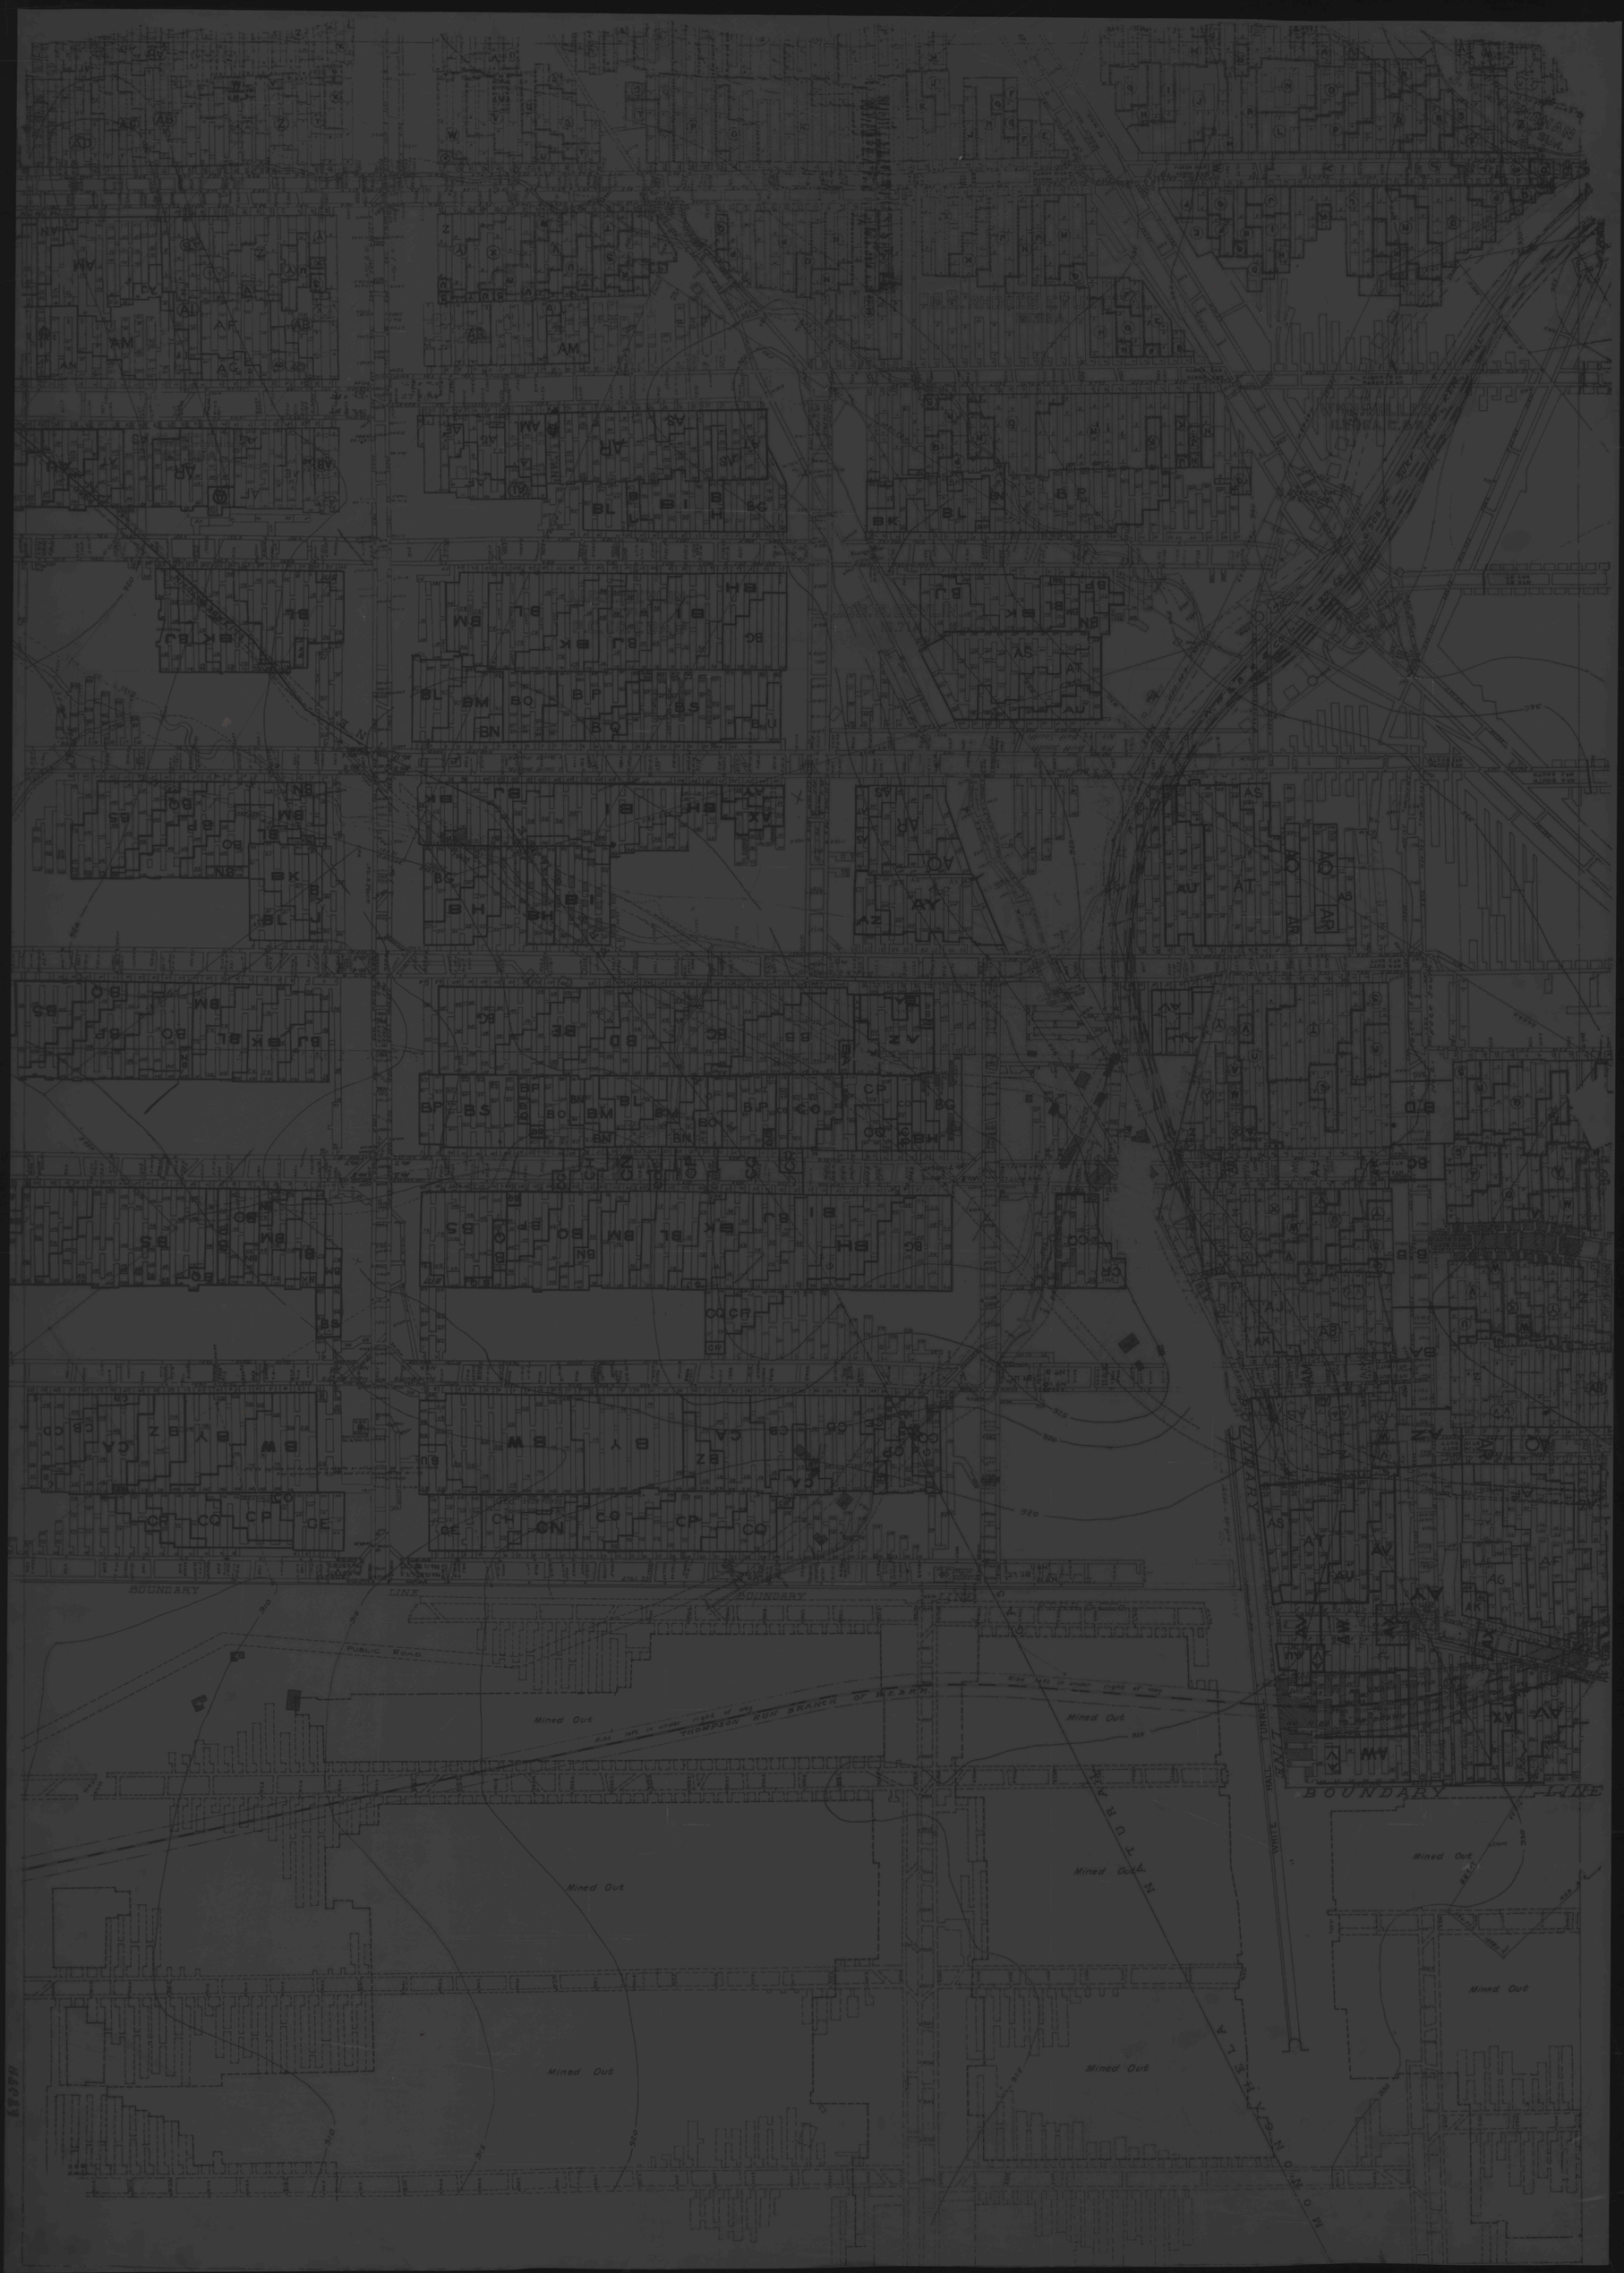
BOUNDARY LINE
PUBLIC ROAD
THOMPSON RUN BRANCH OF W.B.R.R.
Mined Out
Mined Out
Mined Out
Mined Out
Mined Out
Mined Out
Mined Out
Mined Out
NATURAL
WHITE
BOUNDARY LINE
BOUNDARY LINE