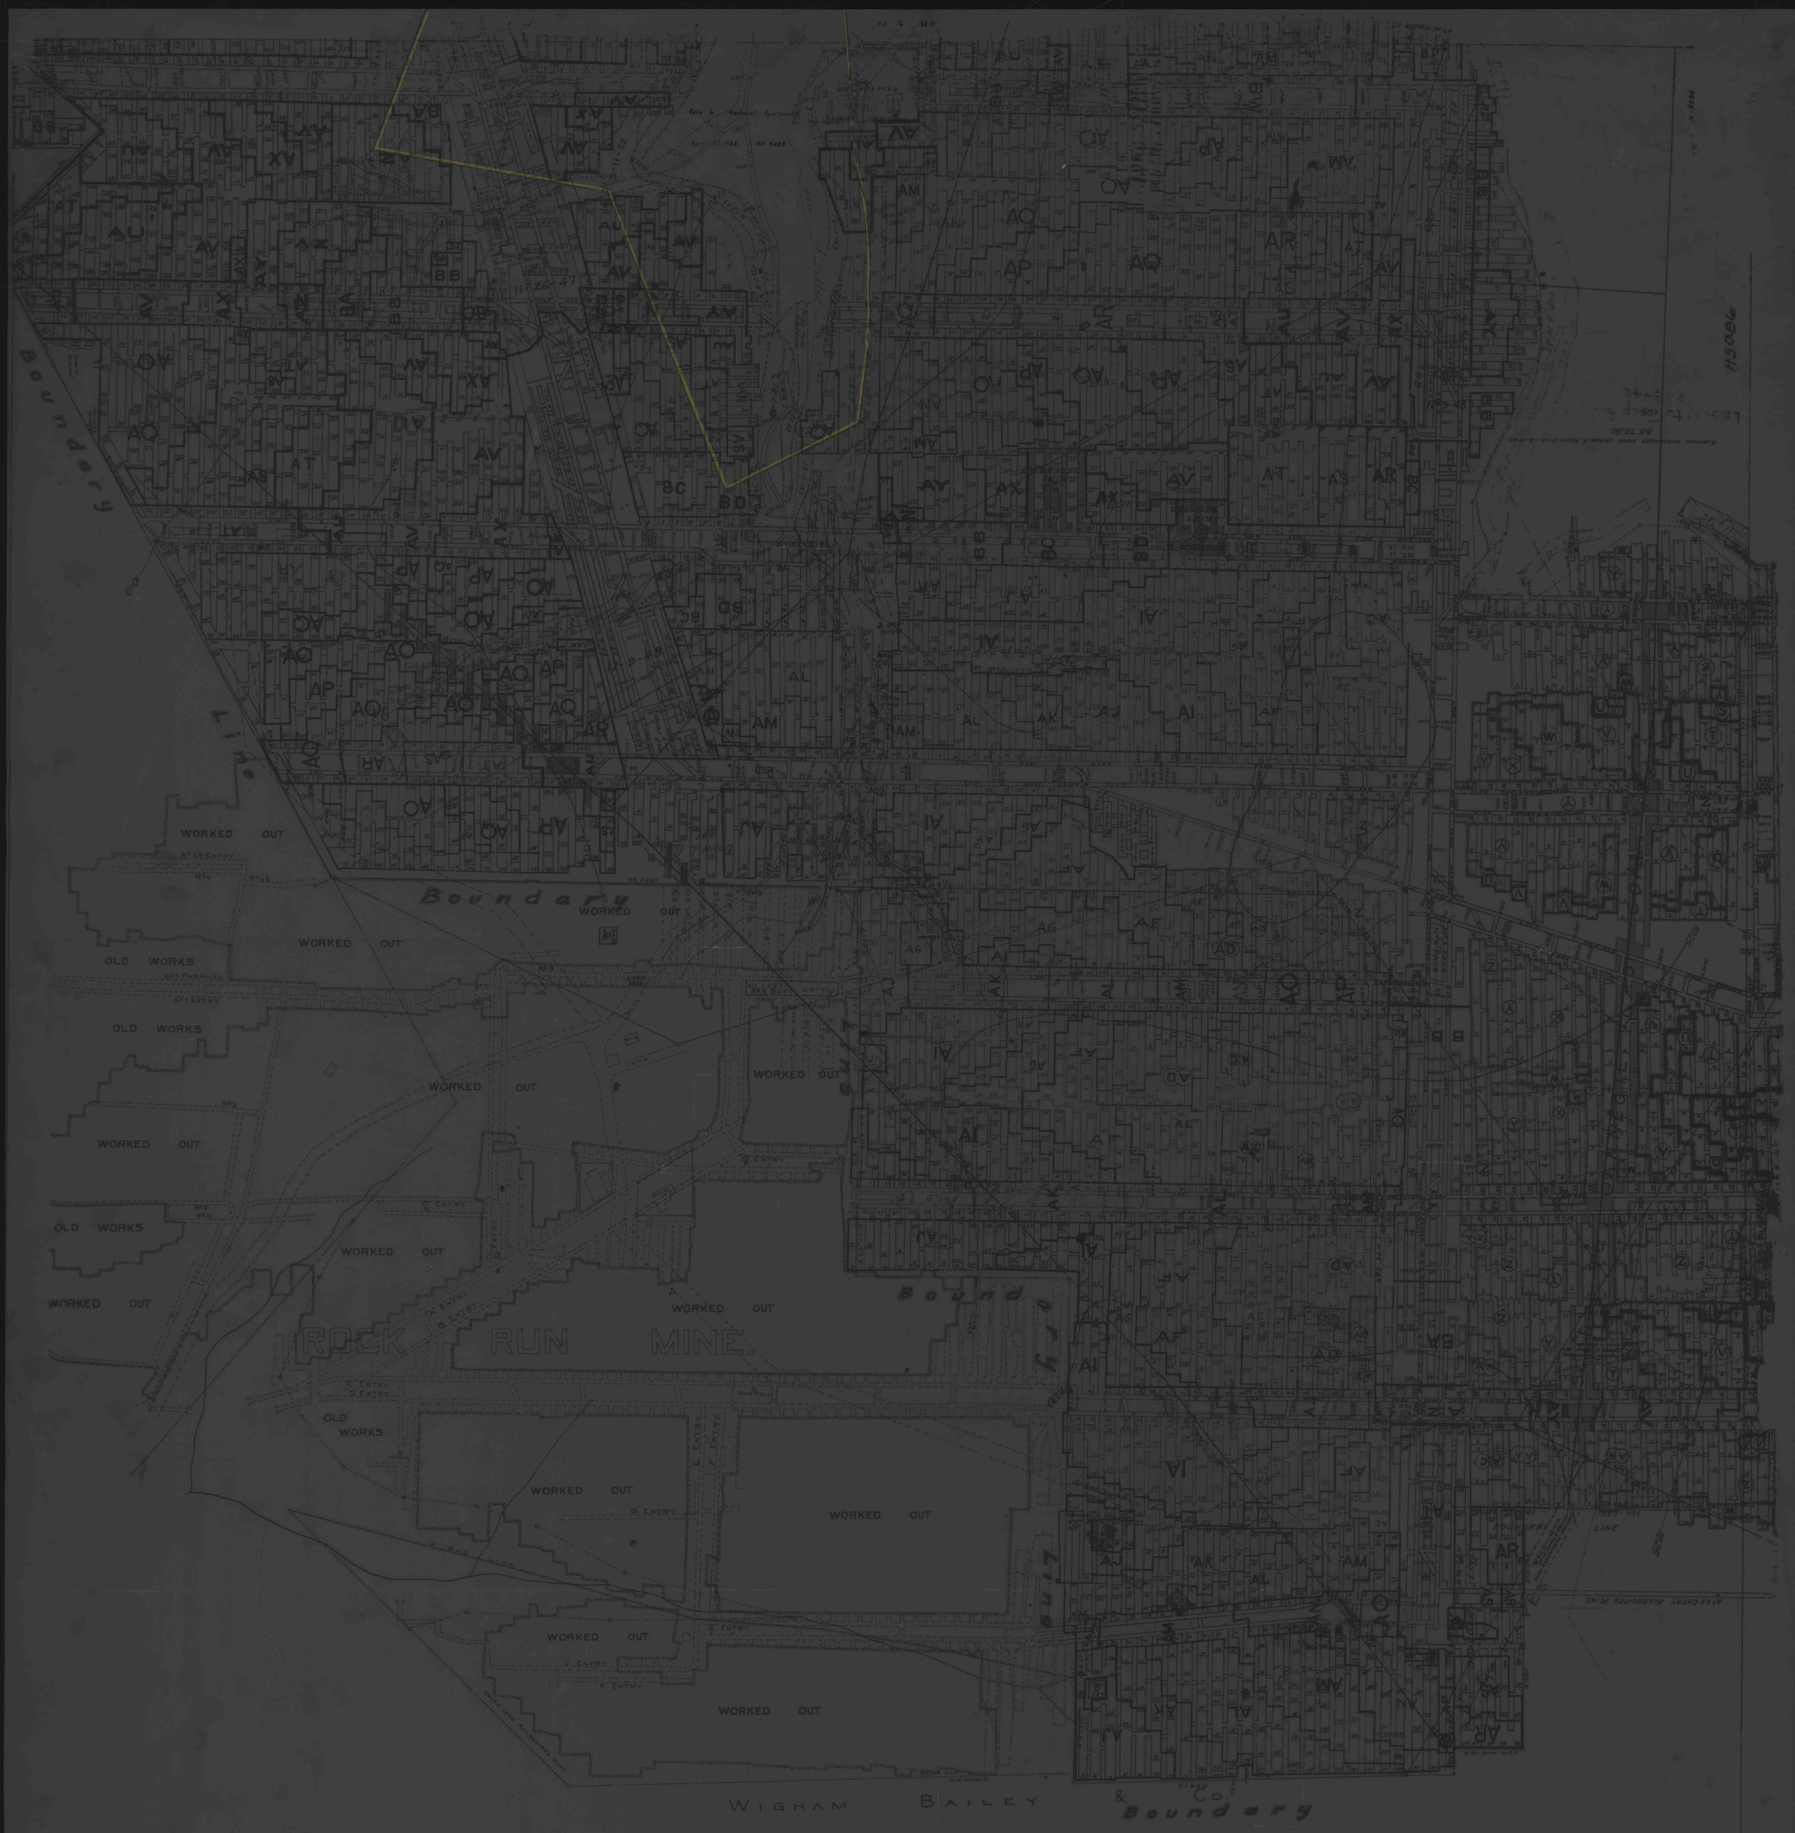
Boundary
Line
WORKED OUT
OLD WORKS
ROCK RUN MINE
WIGHAM BAILEY & Co.
Boundary