H 5094

FIRST POOL
Ammoden
Sheet #1

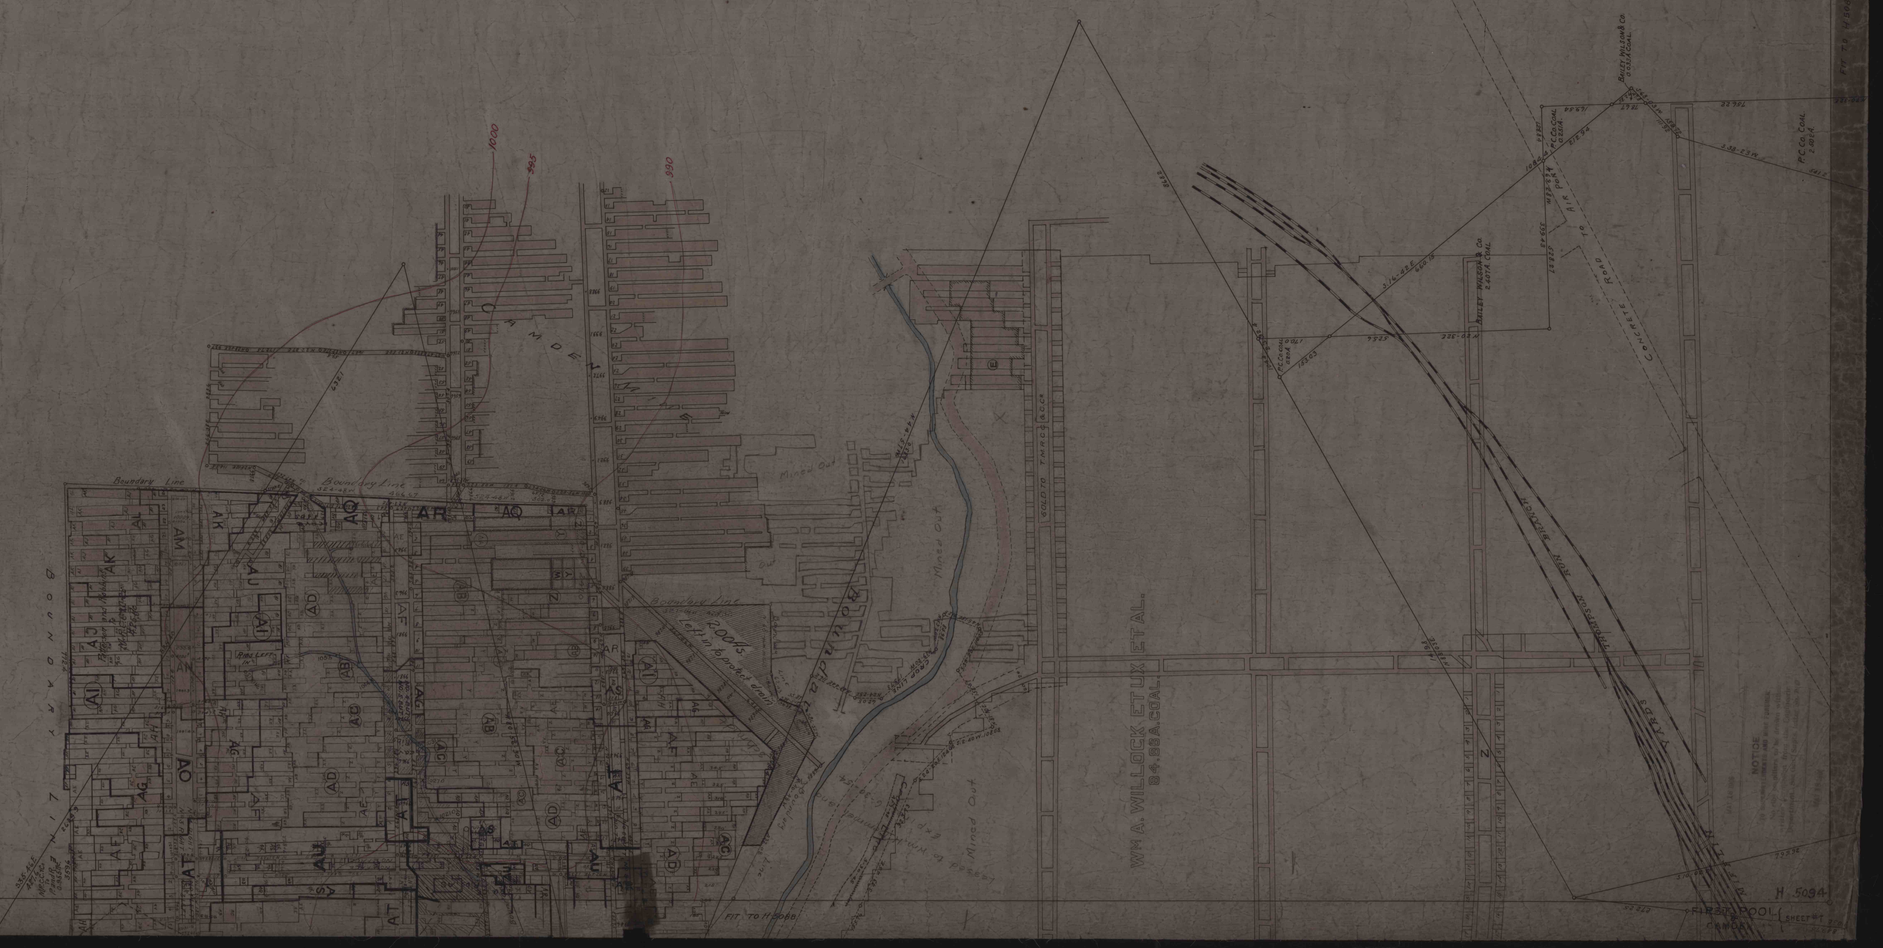
CAMDEN
BOUNDARY LINE
Boundary Line
Boundary Line
Boundary Line
1000
925
930
AR
AQ
AK
AM
AJ
AC
AD
AT
AF
AG
AB
AU
AE
AL
B
N
Z
Mined Out
Mined Out
Mined Out