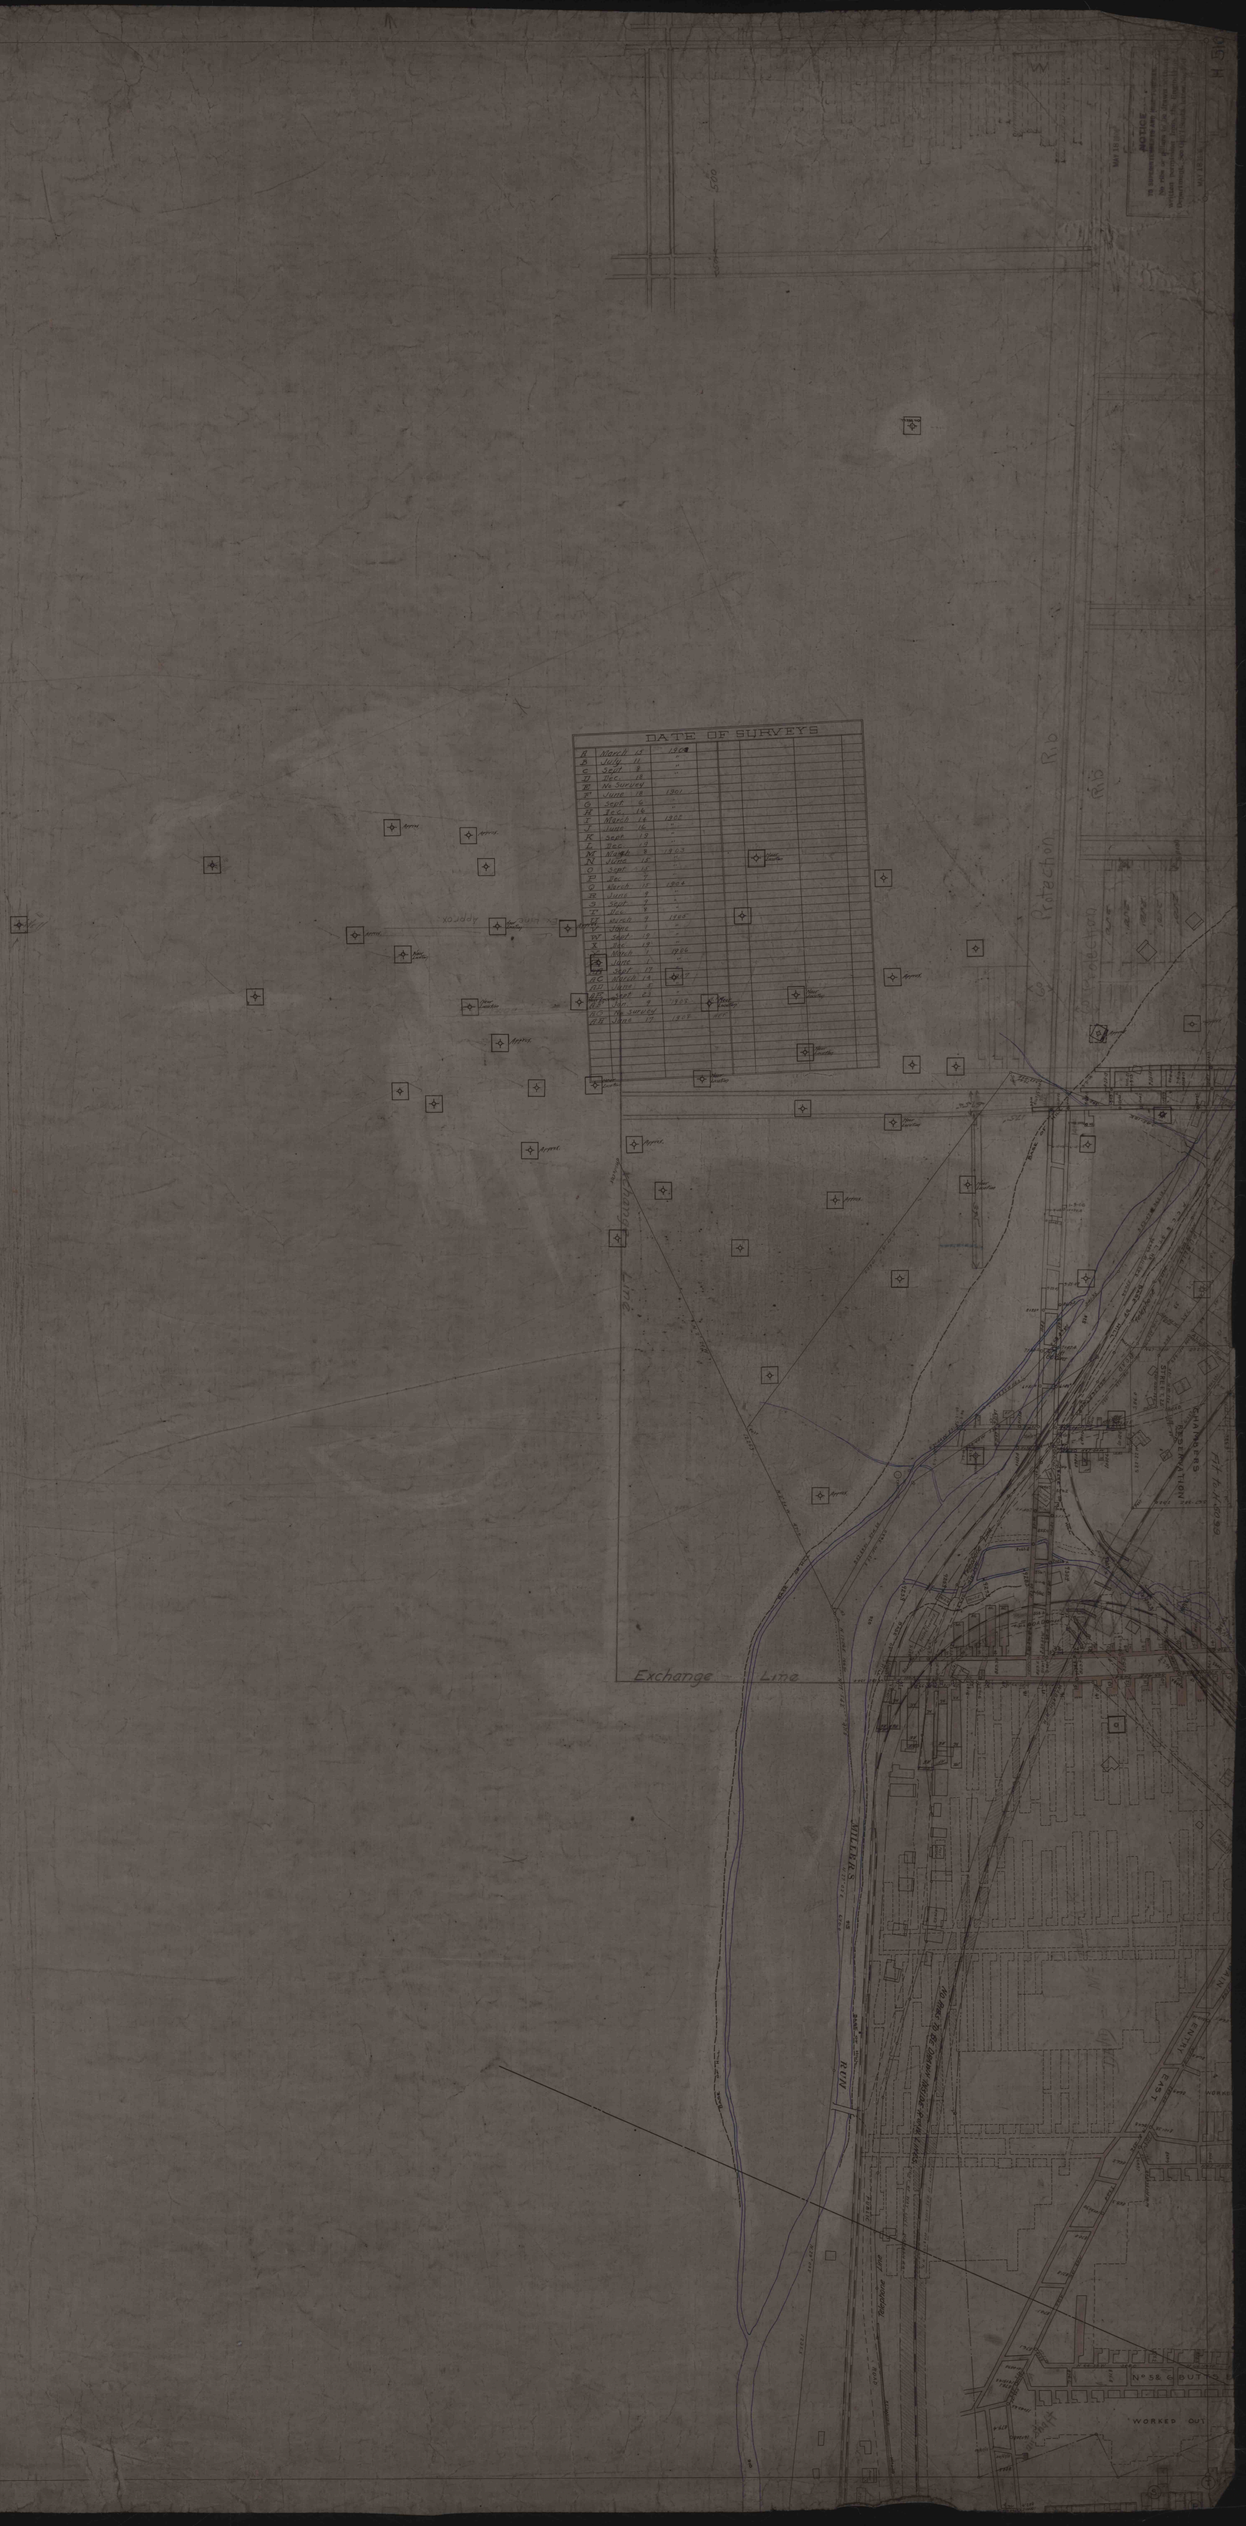
DATE OF SURVEYS
Exchange Line
Approx
Rotection
Rd
Rd
Rd