


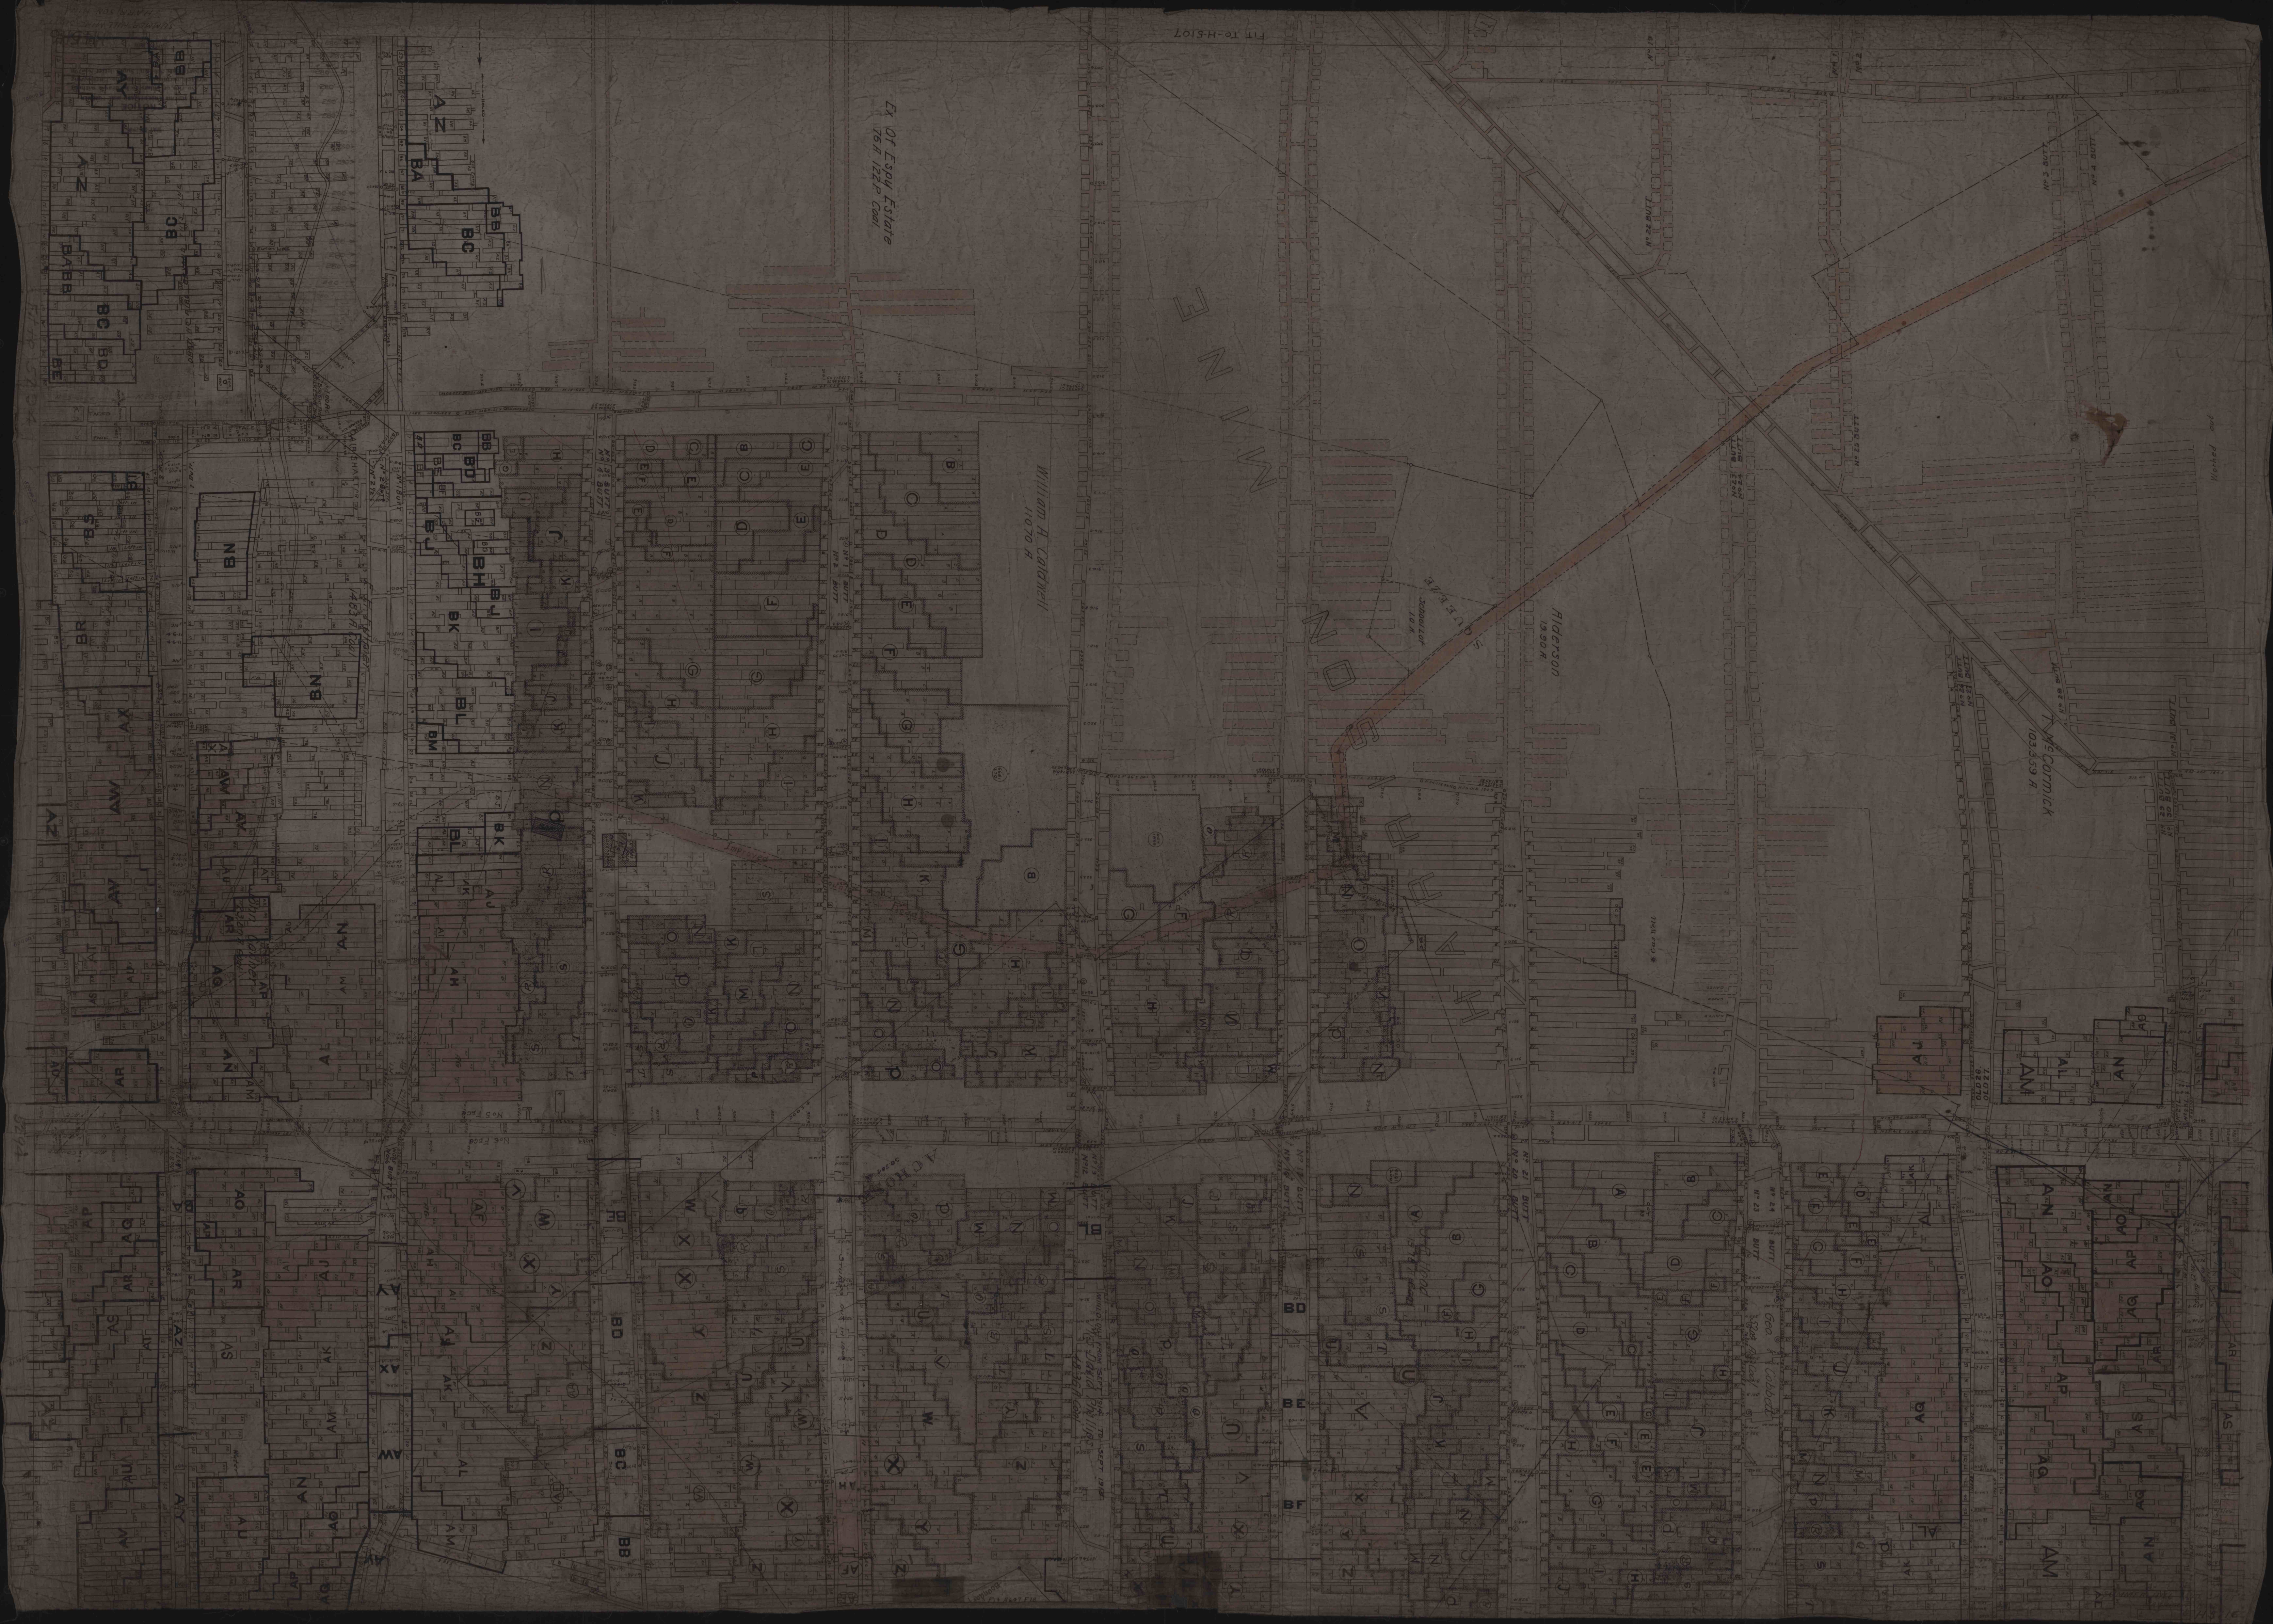

Lx Of Esou Estate
76.4 122.8 Coal

William H. Caldwell
11070 R

Hiderson
1350 R

McCormick
103.5 53 R

F N I M

School Lot
10 R

LINE 5.41







AZ

BA

BB

BC

BD

BE

BF

BG

BH

BI

BJ

BK

BL

BM

BN

BO

BP

BQ

BR

BS

BT

BU

BV


































































