


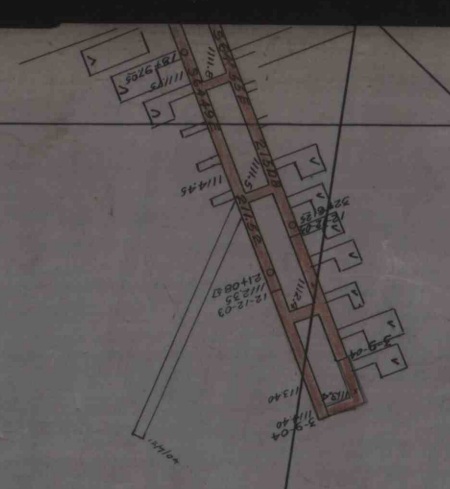

SADIE CROOKS.
SHAW COAL

JOS. PARTRIDGE.
P.M.CO.