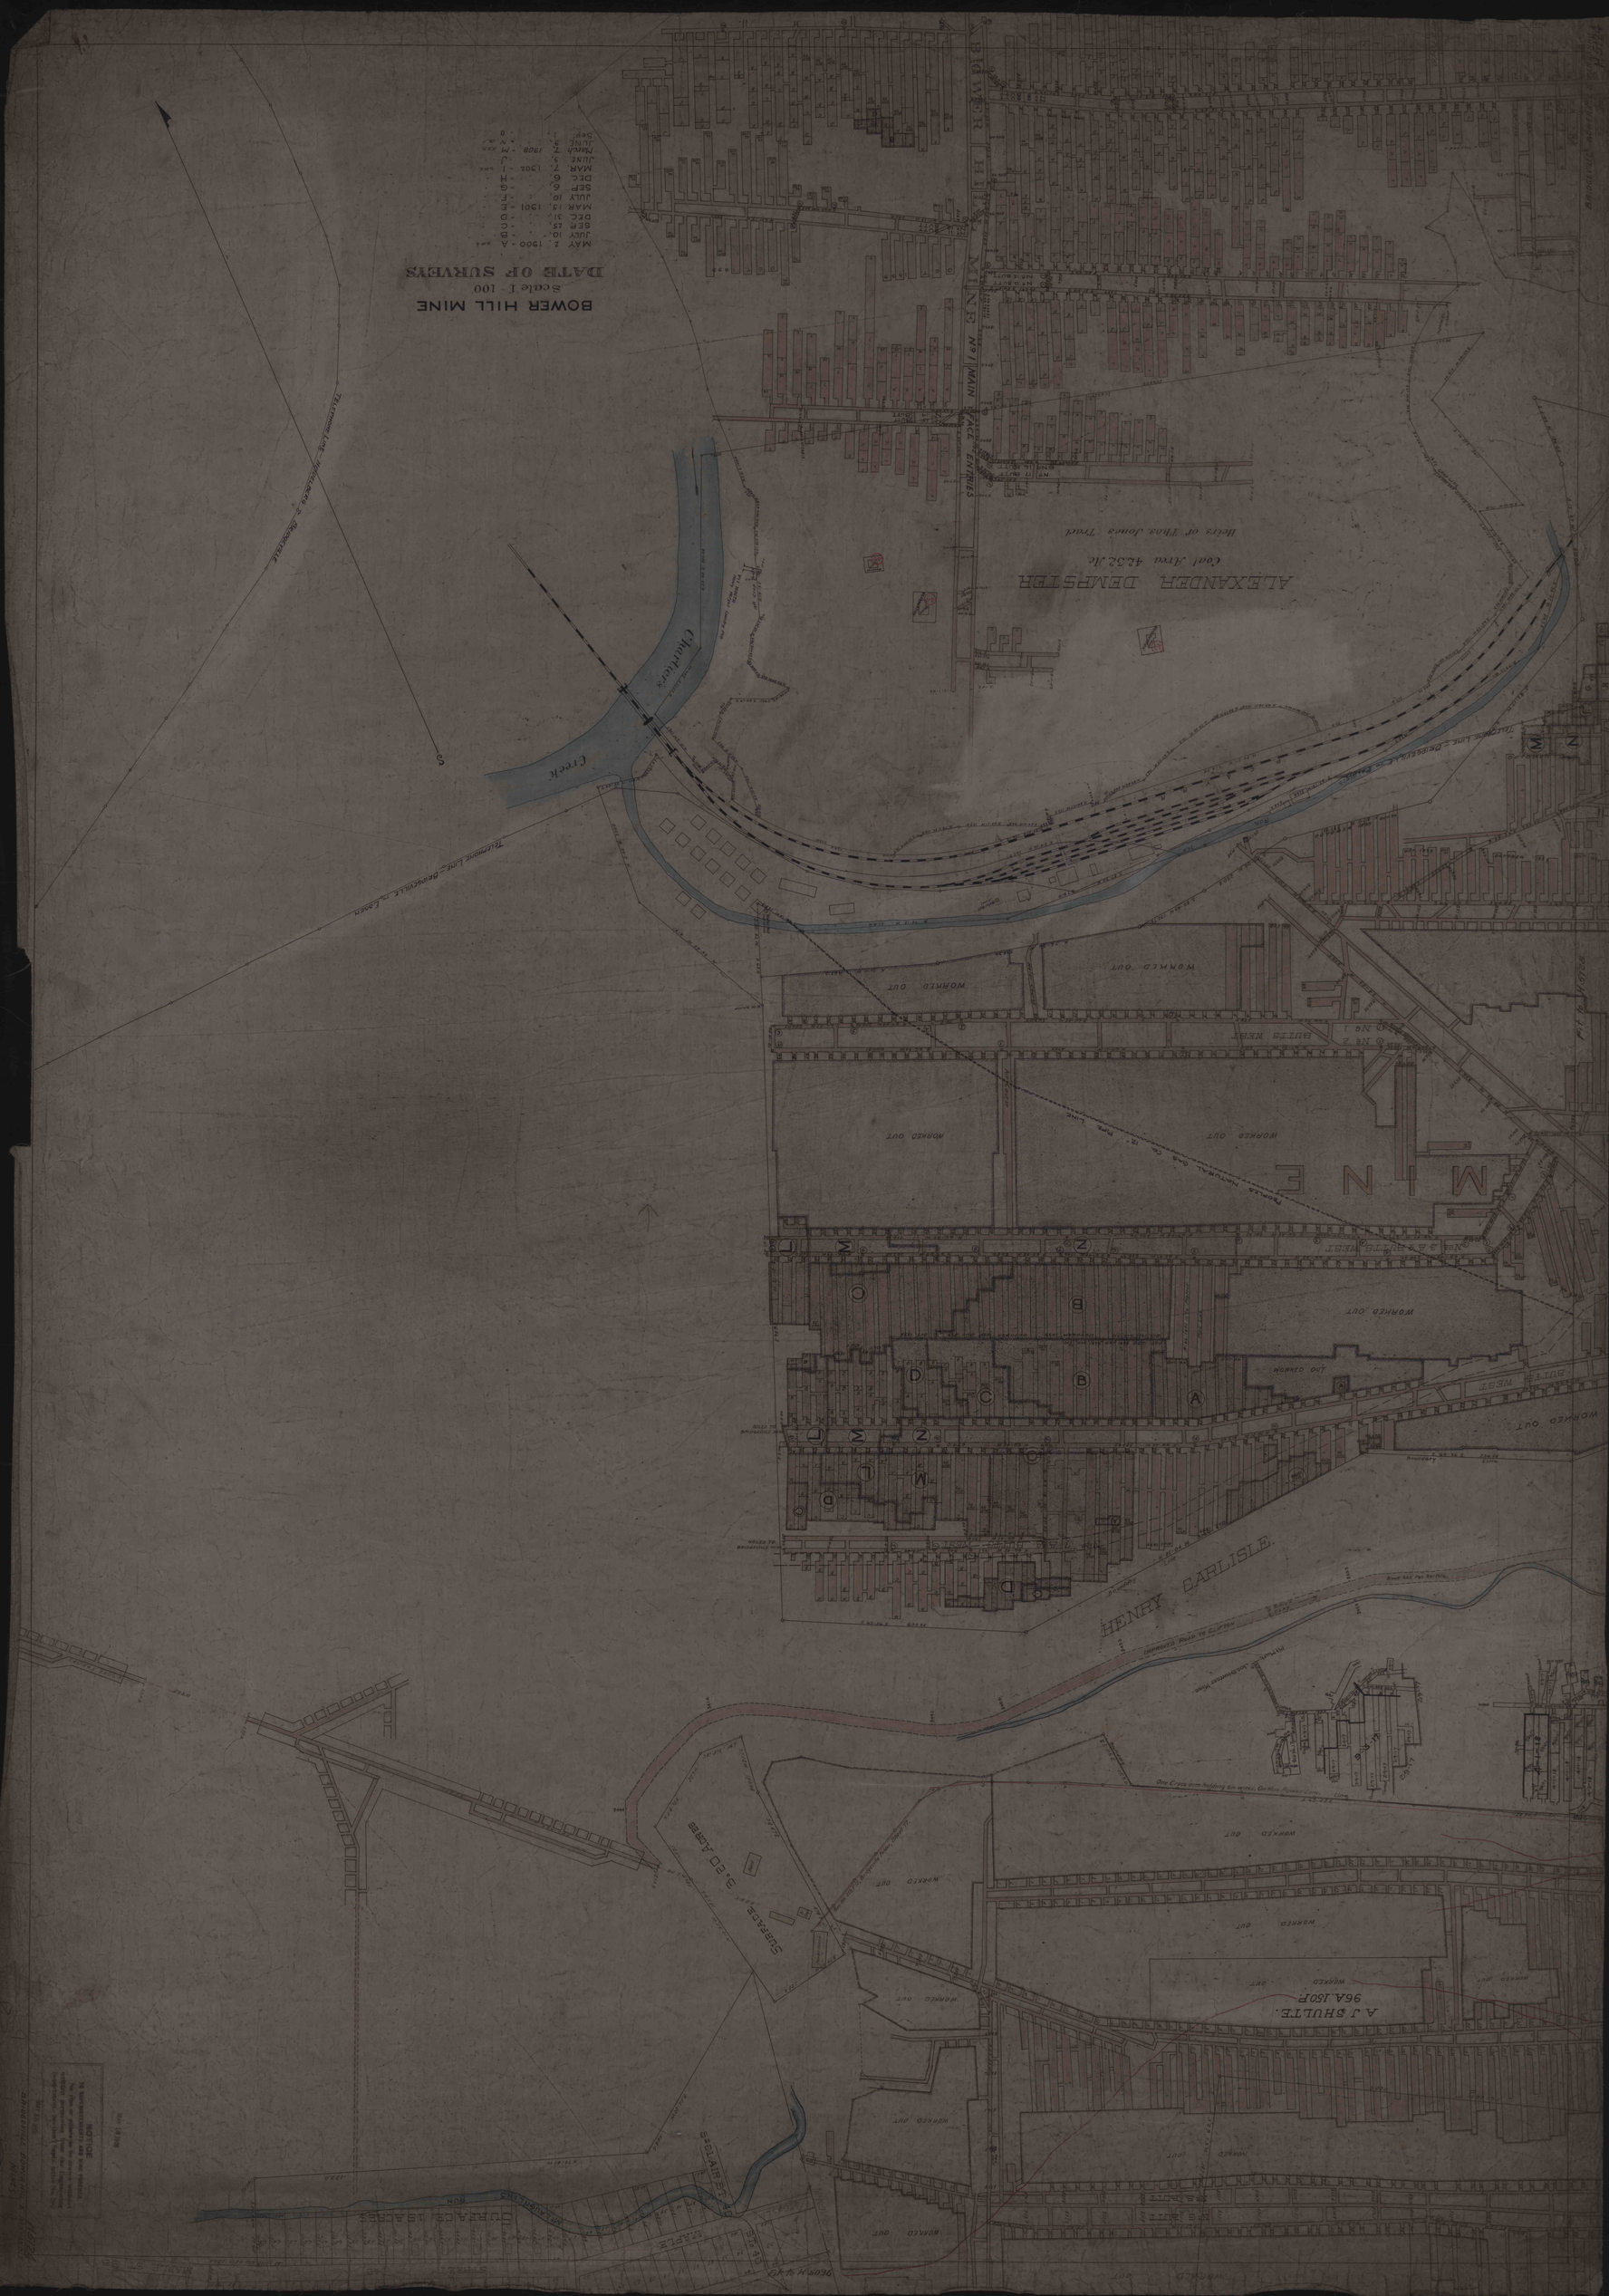
BOWER HILL MINE
Scale 1" 100
DATE OF SURVEYS
MAY 2. 1900 - A
JULY 10. - B
SEP 15. - C
DEC 31. - D
MAR 13. 1901 - E
JULY 10. - F
DEC 6. - H
SEP 6. - G
MAR 7. 1902 - I
JUNE 3. - J
MAY 7. 1908 - M
JUNE 3. - N
SEP 1. - O
ALEXANDER DEMPSTER
Coal Area 4.532 Ac
Heirs of Thos. Jones Tract
No 1 MAIN
FACE ENTRIES
Chatterie
Creek
Telephone Line - Beaverville to Lewis
Telephone Line - Beaverville to Bowerville
MINE
WORKED OUT
BUTTS WEST
HENRY CARLISLE
A J SHULTE
96A 150P
SURRAGE
3.20 ACRES
SCHLAIRS
CURRAN & ISAACS
EAGLE
Scale of Plan