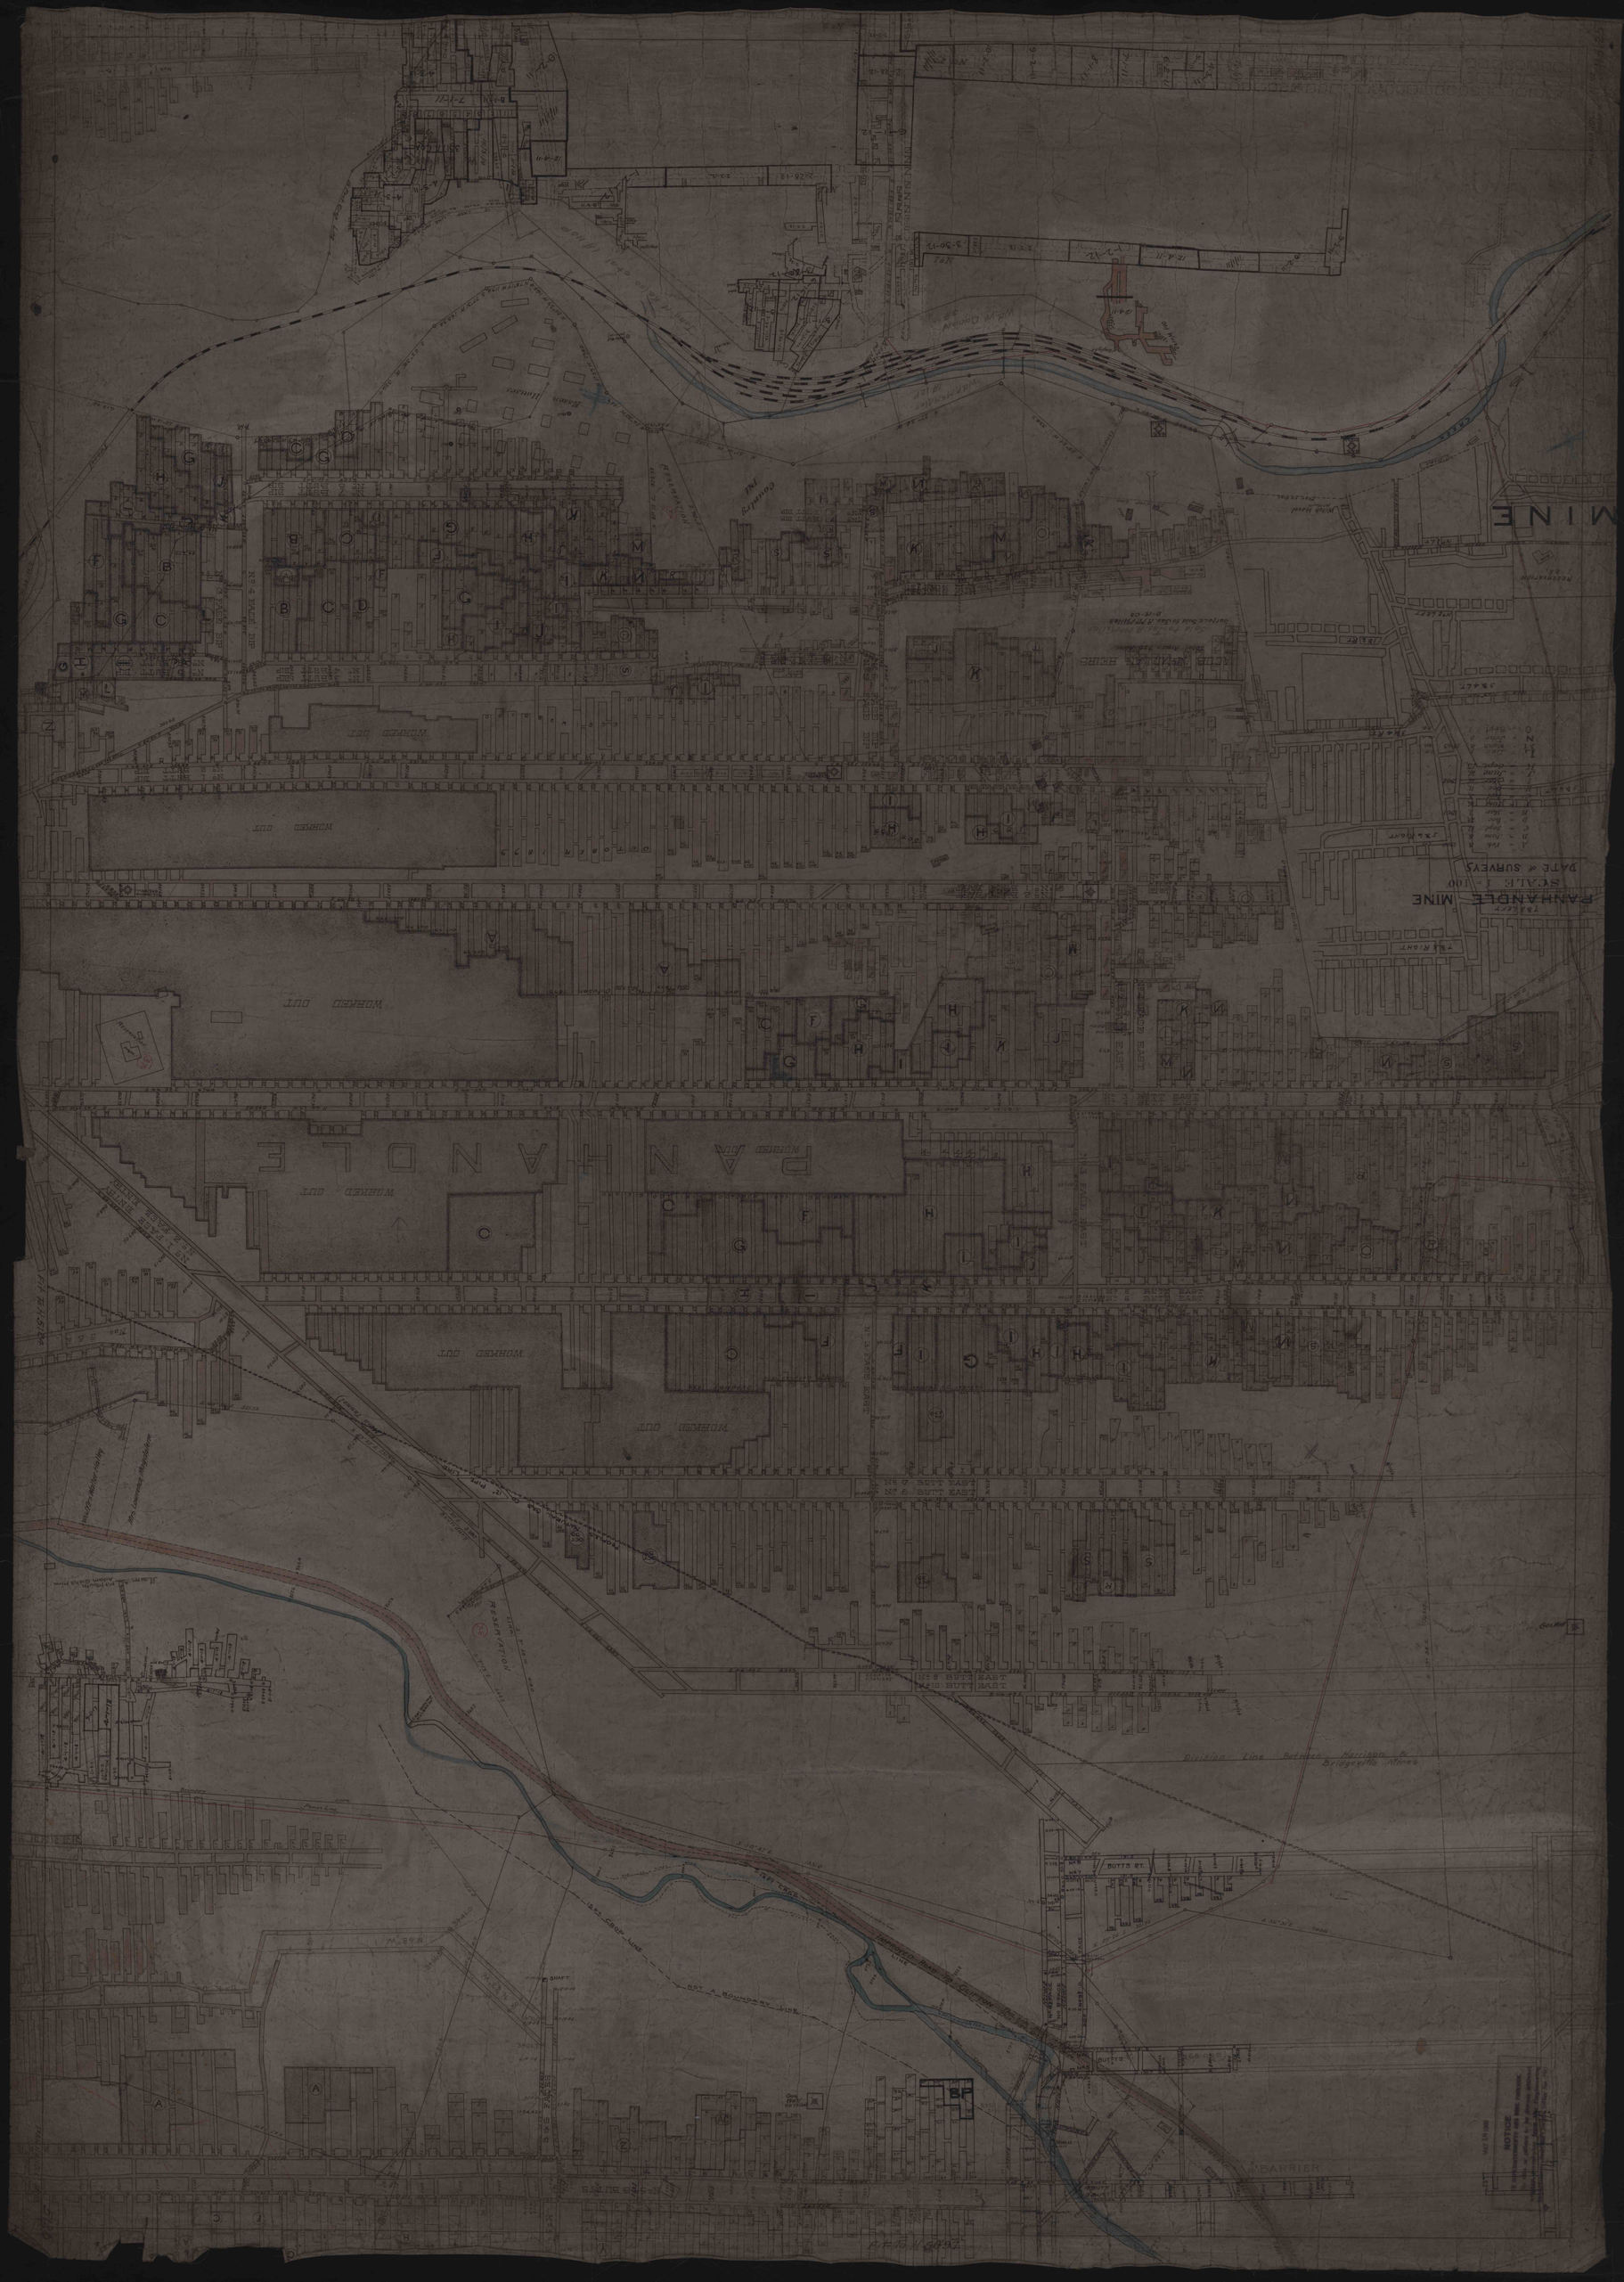
PANHANDLE MINE
SCALE 1:100
DATE of SURVEY
WORKED OUT
NO 7 BUTT EAST
NO 8 BUTT EAST
NO 9 BUTT EAST
NO 10 BUTT EAST
BUTTS RT.
BUTTS
Dividing Line between Harrison & Bridgeville Mines
NOT A BOUNDARY LINE
BARRIER
MINE