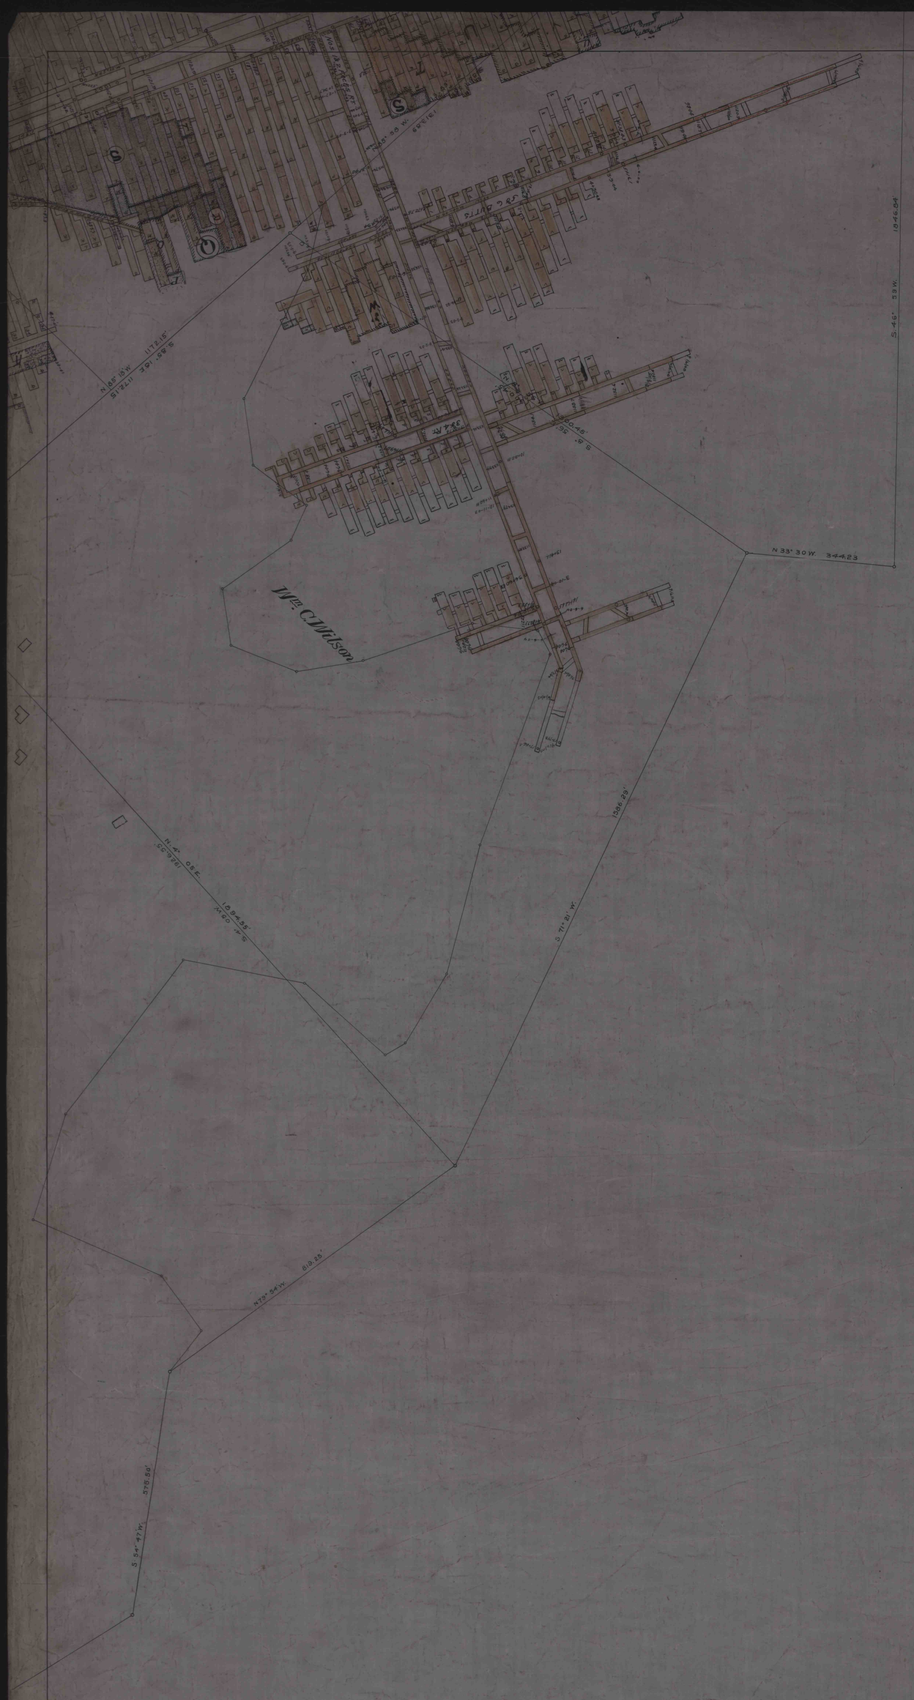
Wm. C. Wilson
N. 33° 30 W. 34423
S. 46° 30 W.
1544.64
S. 71° 31' W.
1386.20
S. 54° 47 W.
378.86'
N. 67° 30 W.
1172.16'
S. 4° 0 E.
COTTON
818.20