


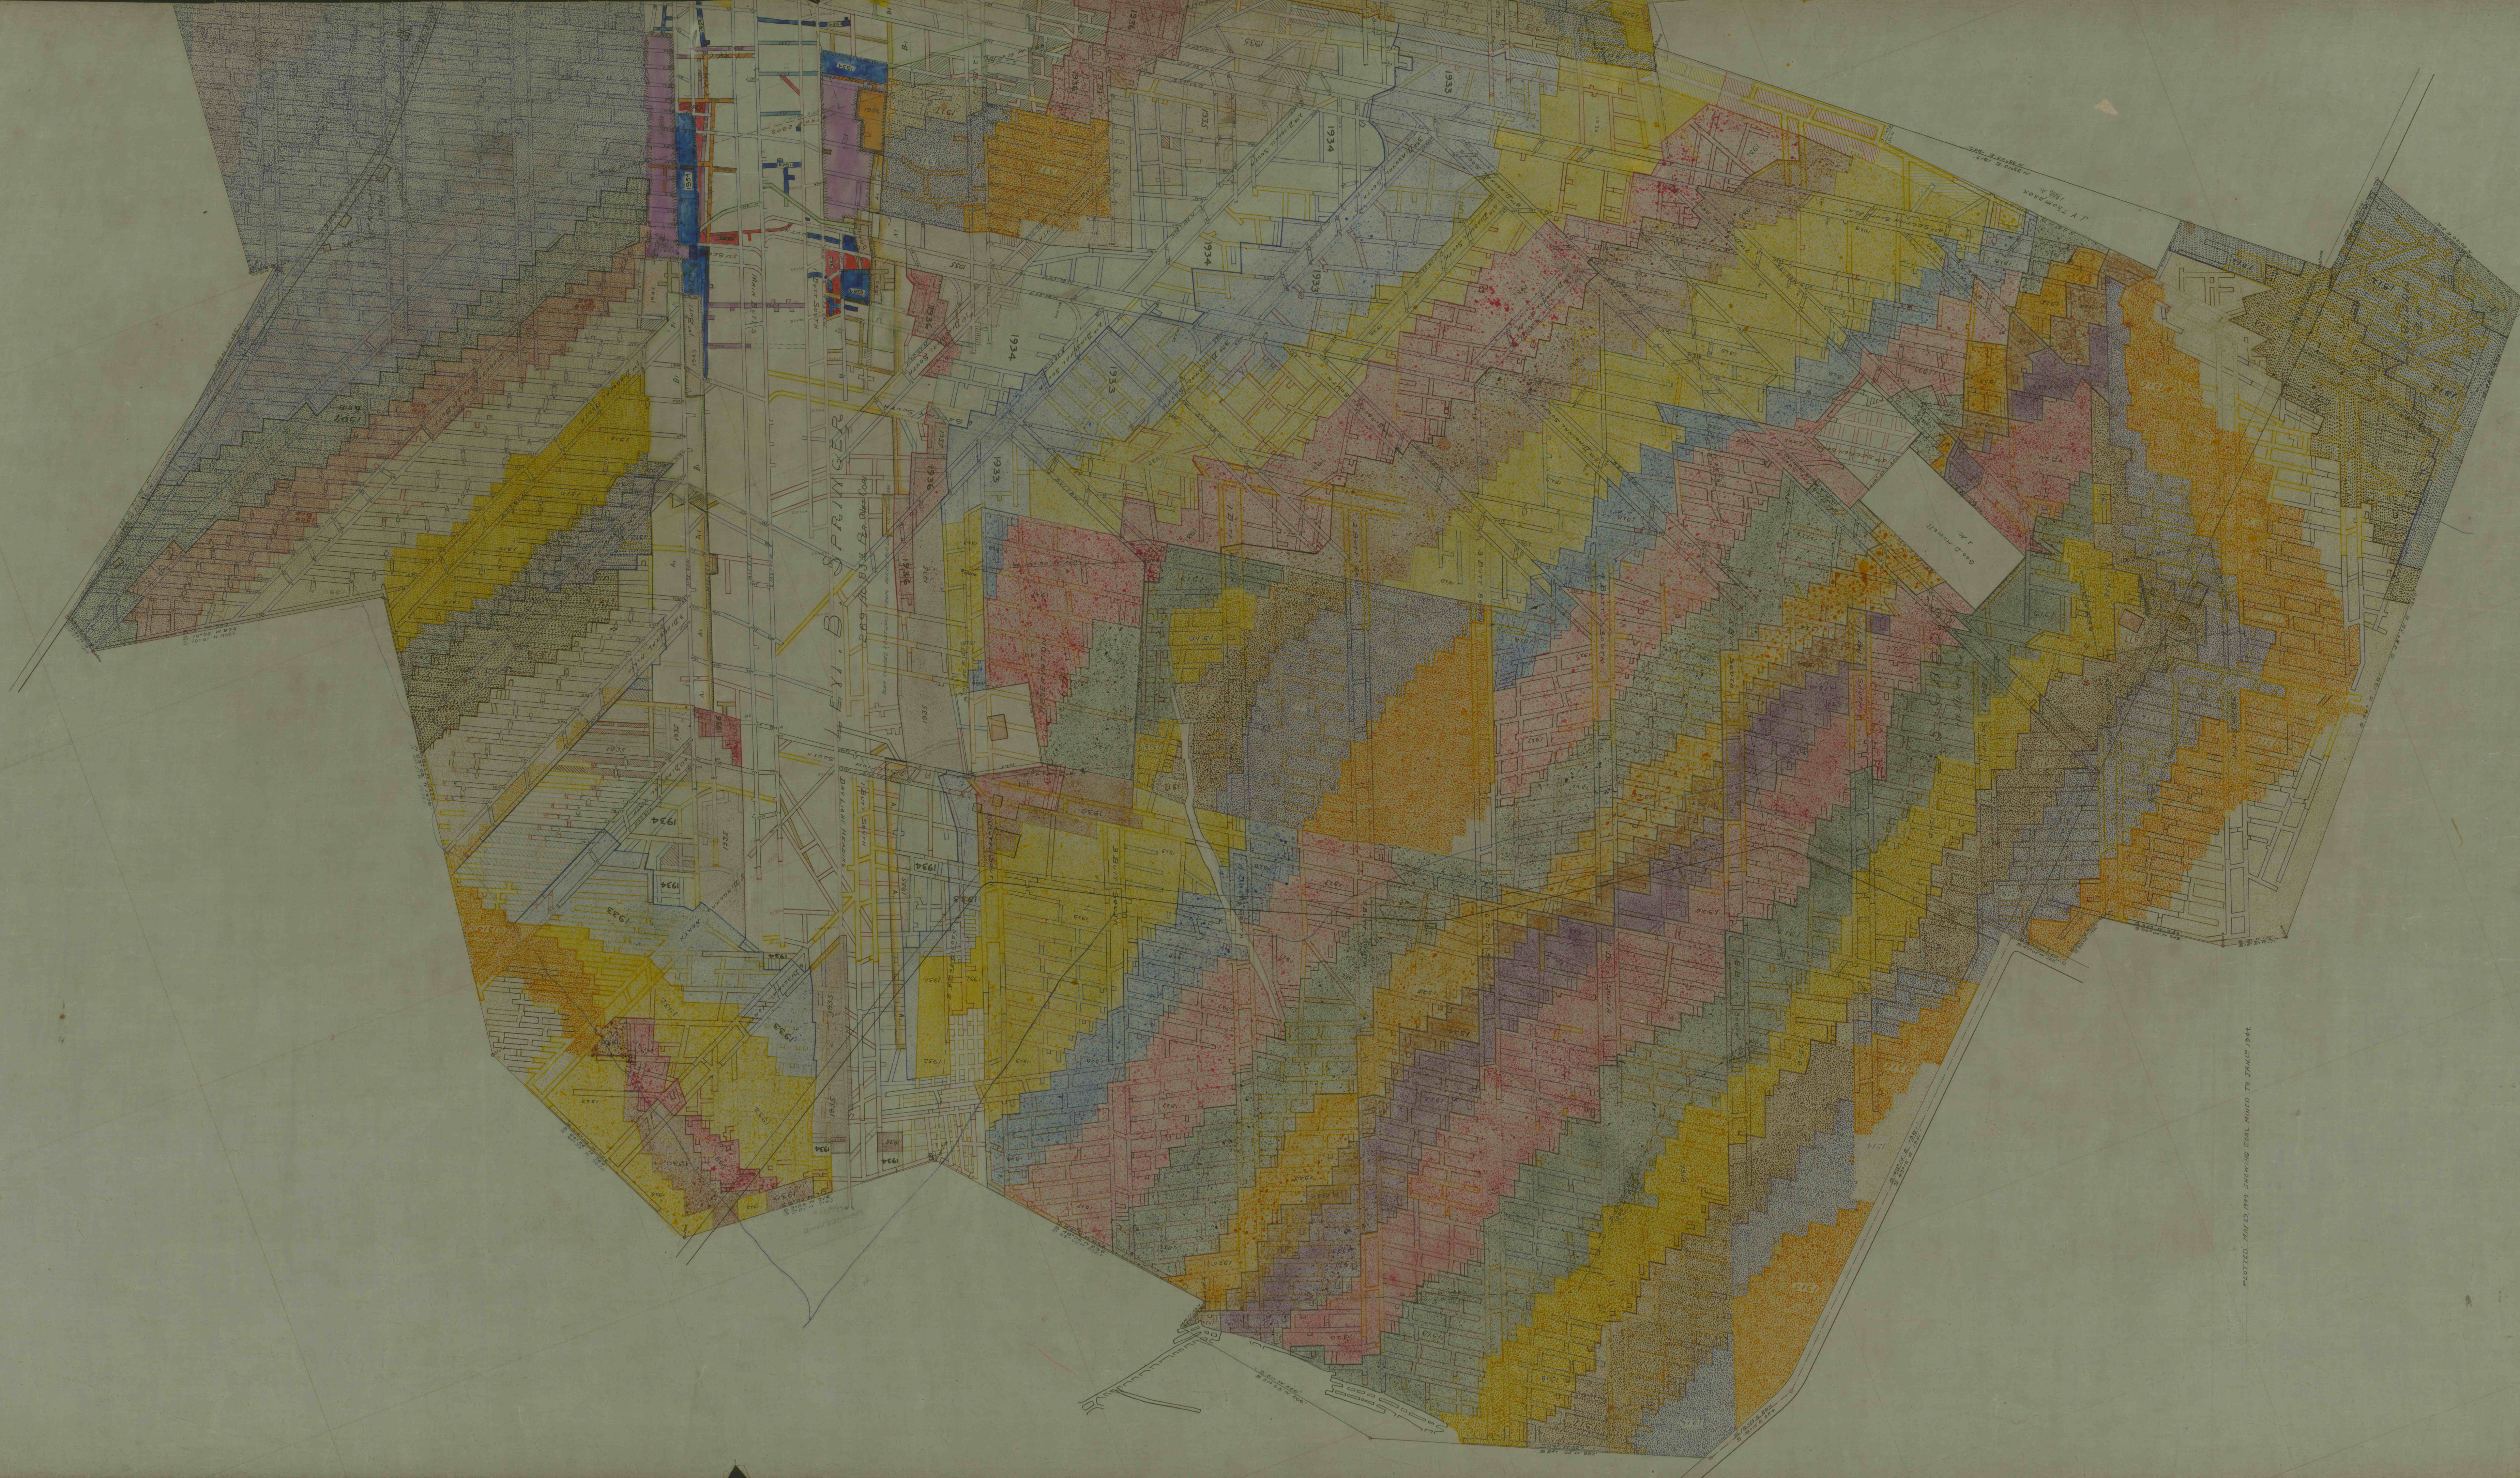

MAP OF THE
OLIVER MINES
NORTH UNION TWP
FAYETTE CO PA
SHEET - No. 4

Notes: Lines from actual measurements
in 1907 shown with black ink
1907 lines with black ink


