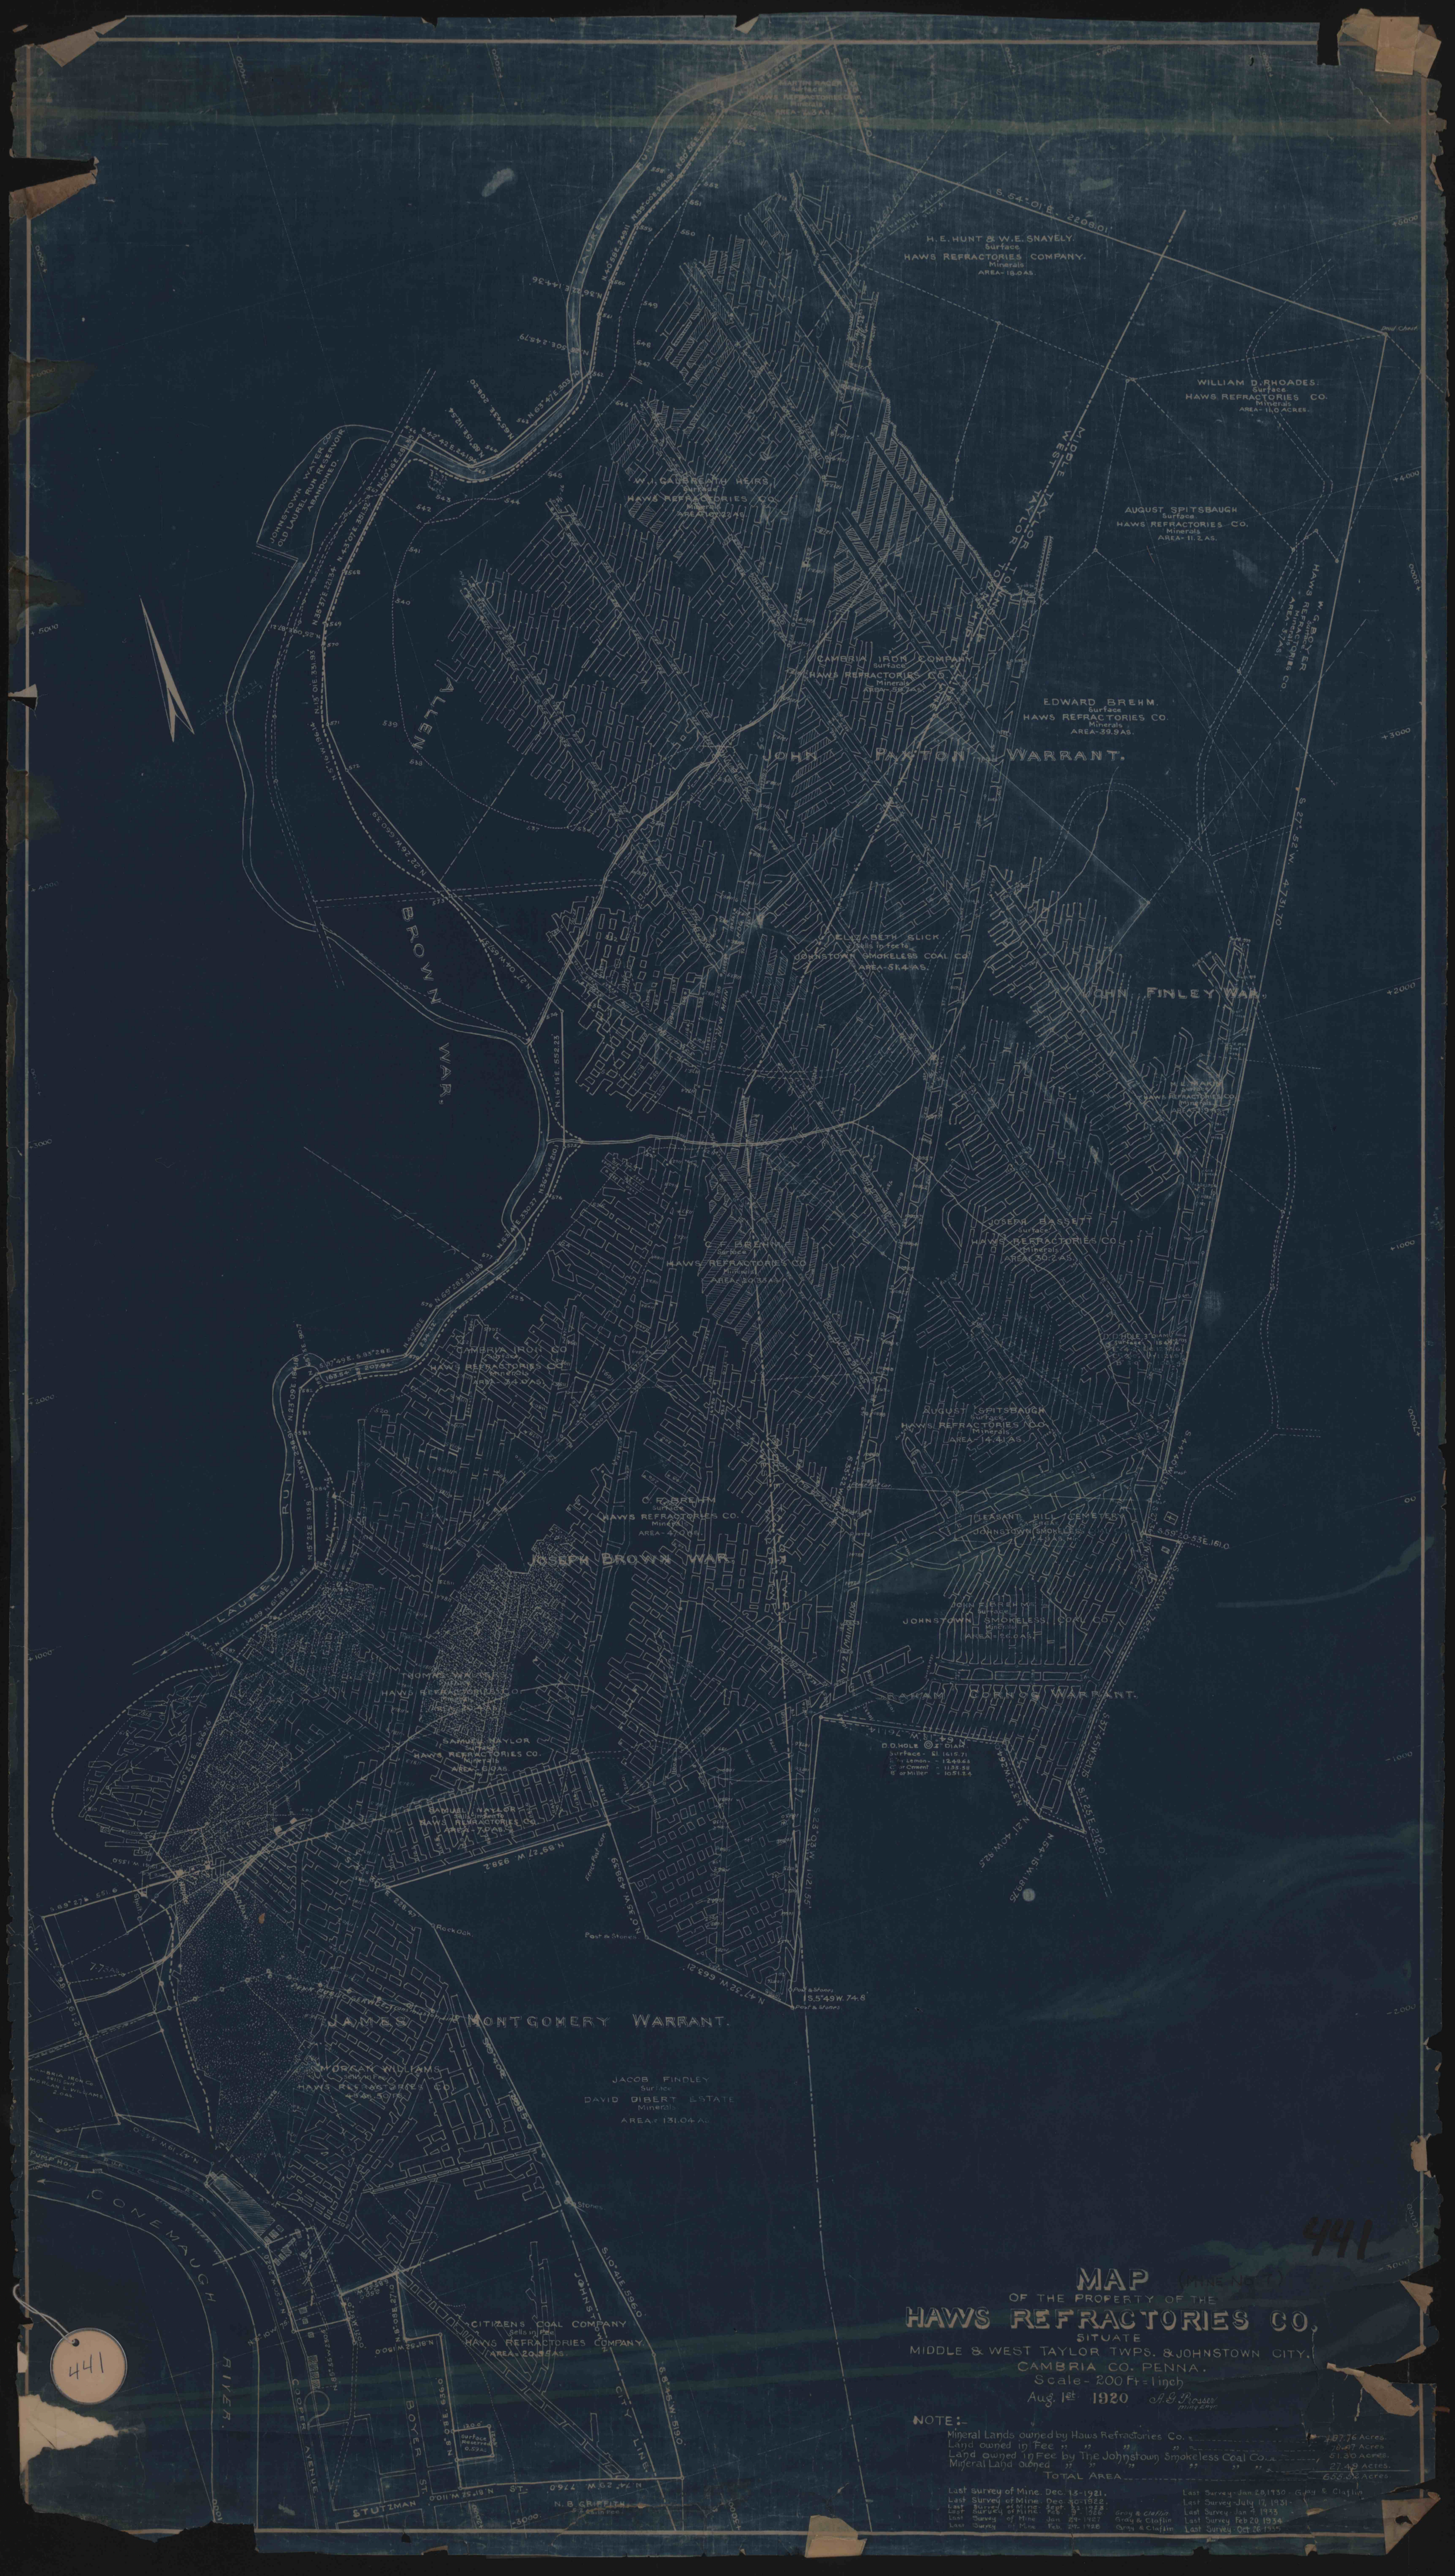
MAP
OF THE PROPERTY OF THE
HAWS REFRACTORIES CO.
SITUATE
MIDDLE & WEST TAYLOR TWPS. & JOHNSTOWN CITY.
CAMBRIA CO. PENNA.
Scale - 200 Ft = 1 inch
Aug. 1st 1920
A. G. Prosser
NOTE:-
Mineral Lands owned by Haws Refractories Co. = 187.76 Acres.
Land owned in Fee " " " " = 78.07 Acres
Land owned in Fee by The Johnstown Smokeless Coal Co. = 51.30 Acres.
Mineral Land owned " " " " " " = 27.49 Acres.
TOTAL AREA = 665.62 Acres.
Last survey of Mine. Dec. 13-1921.
Last Survey of Mine. Dec. 30-1922.
Last Survey of Mine. Sept. 22-1923.
Last Survey of Mine. Feb. 9-1926 Gray & Claflin
Last Survey of Mine Jan 24-1927 Gray & Claflin
Last Survey of Mine Feb. 29-1928 Gray & Claflin
Last Survey Jan 28, 1930 - Gray & Claflin
Last Survey July 17, 1931
Last Survey Jan 4 1933
Last Survey Feb 20 1934
Last Survey Oct 26 1935
LAUREL RUN
BROWN WAR.
ALLEN
JOHN PAXTON WARRANT.
JOHN FINLEY WAR.
JOSEPH BROWN WAR.
GRAHAM CORNOG WARRANT.
JAMES MONTGOMERY WARRANT.
CONEMAUGH RIVER
COOPER AVENUE
BOYER ST.
STUTZMAN
CITY LINE
H. E. HUNT & W. E. SNAYELY
Surface
HAWS REFRACTORIES COMPANY.
Minerals
AREA - 18.0 AS.
WILLIAM D. RHOADES.
Surface
HAWS REFRACTORIES CO.
Minerals
AREA - 11.0 ACRES.
AUGUST SPITSBAUGH
Surface
HAWS REFRACTORIES CO.
Minerals
AREA - 11.2 AS.
EDWARD BREHM.
Surface
HAWS REFRACTORIES CO.
Minerals
AREA - 39.9 AS.
CAMBRIA IRON COMPANY
Surface
HAWS REFRACTORIES CO.
Minerals
ELIZABETH SLICK
Sells in fee to
JOHNSTOWN SMOKELESS COAL CO.
AREA - 51.4 AS.
JOSEPH BASSETT
Surface
HAWS REFRACTORIES CO.
Minerals
AREA - 36.2 AS.
C. F. BREHM
Surface
HAWS REFRACTORIES CO.
Minerals
AREA - 20.35 AS.
CAMBRIA IRON CO.
Surface
HAWS REFRACTORIES CO.
Minerals
AREA - 34.0 AS.
AUGUST SPITSBAUGH
Surface
HAWS REFRACTORIES CO.
Minerals
AREA - 14.41 AS.
C. F. BREHM
Surface
HAWS REFRACTORIES CO.
Minerals
AREA - 47.0 AS.
PLEASANT HILL CEMETERY
JOHN FIREHM
Surface
JOHNSTOWN SMOKELESS COAL CO.
Minerals
AREA - 66.0 AS.
THOMAS NAYLOR
Surface
HAWS REFRACTORIES CO.
Minerals
AREA - 20.4 AS.
SAMUEL NAYLOR
Surface
HAWS REFRACTORIES CO.
Minerals
AREA - 6.0 AS.
SAMUEL NAYLOR
Sells in fee to
HAWS REFRACTORIES CO.
AREA - 7.0 AS.
MORGAN WILLIAMS
Sells in Fee
HAWS REFRACTORIES CO.
AREA - 4.0 AS.
JACOB FINDLEY
Surface
DAVID GIBERT ESTATE
Minerals
AREA = 131.04 AS.
CITIZENS COAL COMPANY
Sells in Fee
HAWS REFRACTORIES COMPANY.
AREA = 20.35 AS.
N. B. GRIFFITH
Sells in fee
441