


03046 288 36X 316609

PVMS

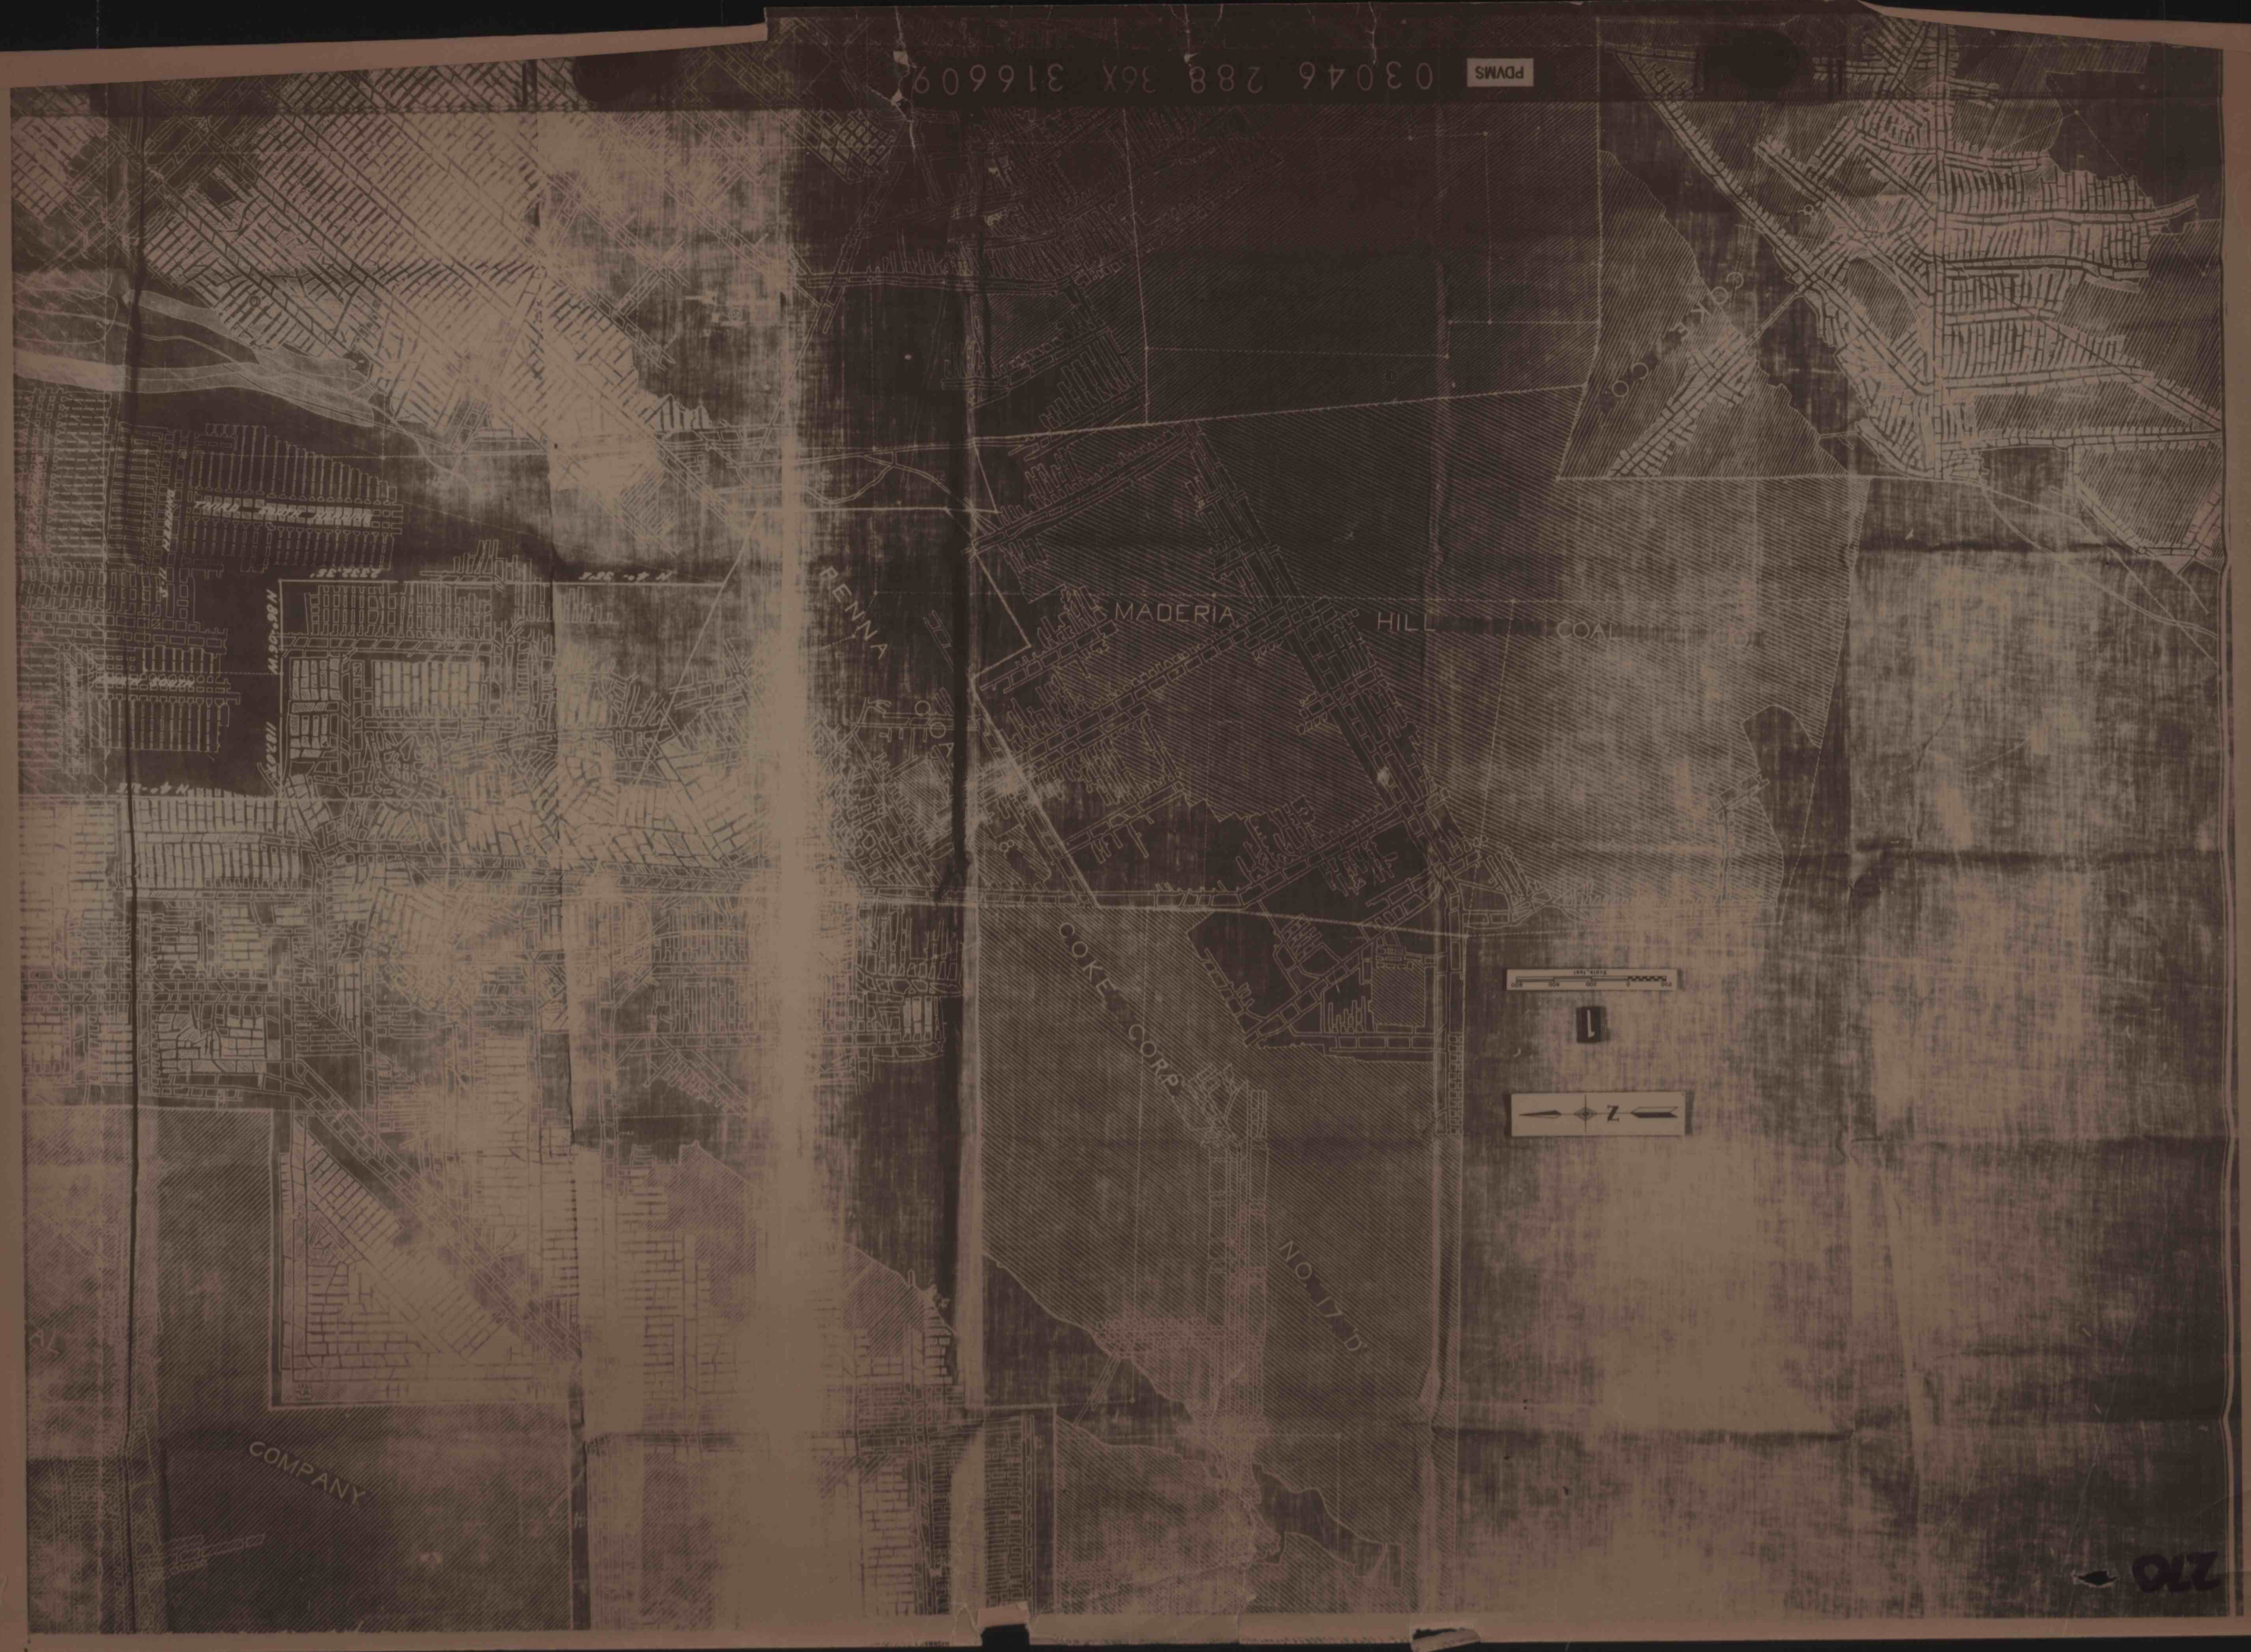

COMPANY

COKE CO.

NO. 17 D

MADERIA

HILL

COAL

1/2 MILE

N

270