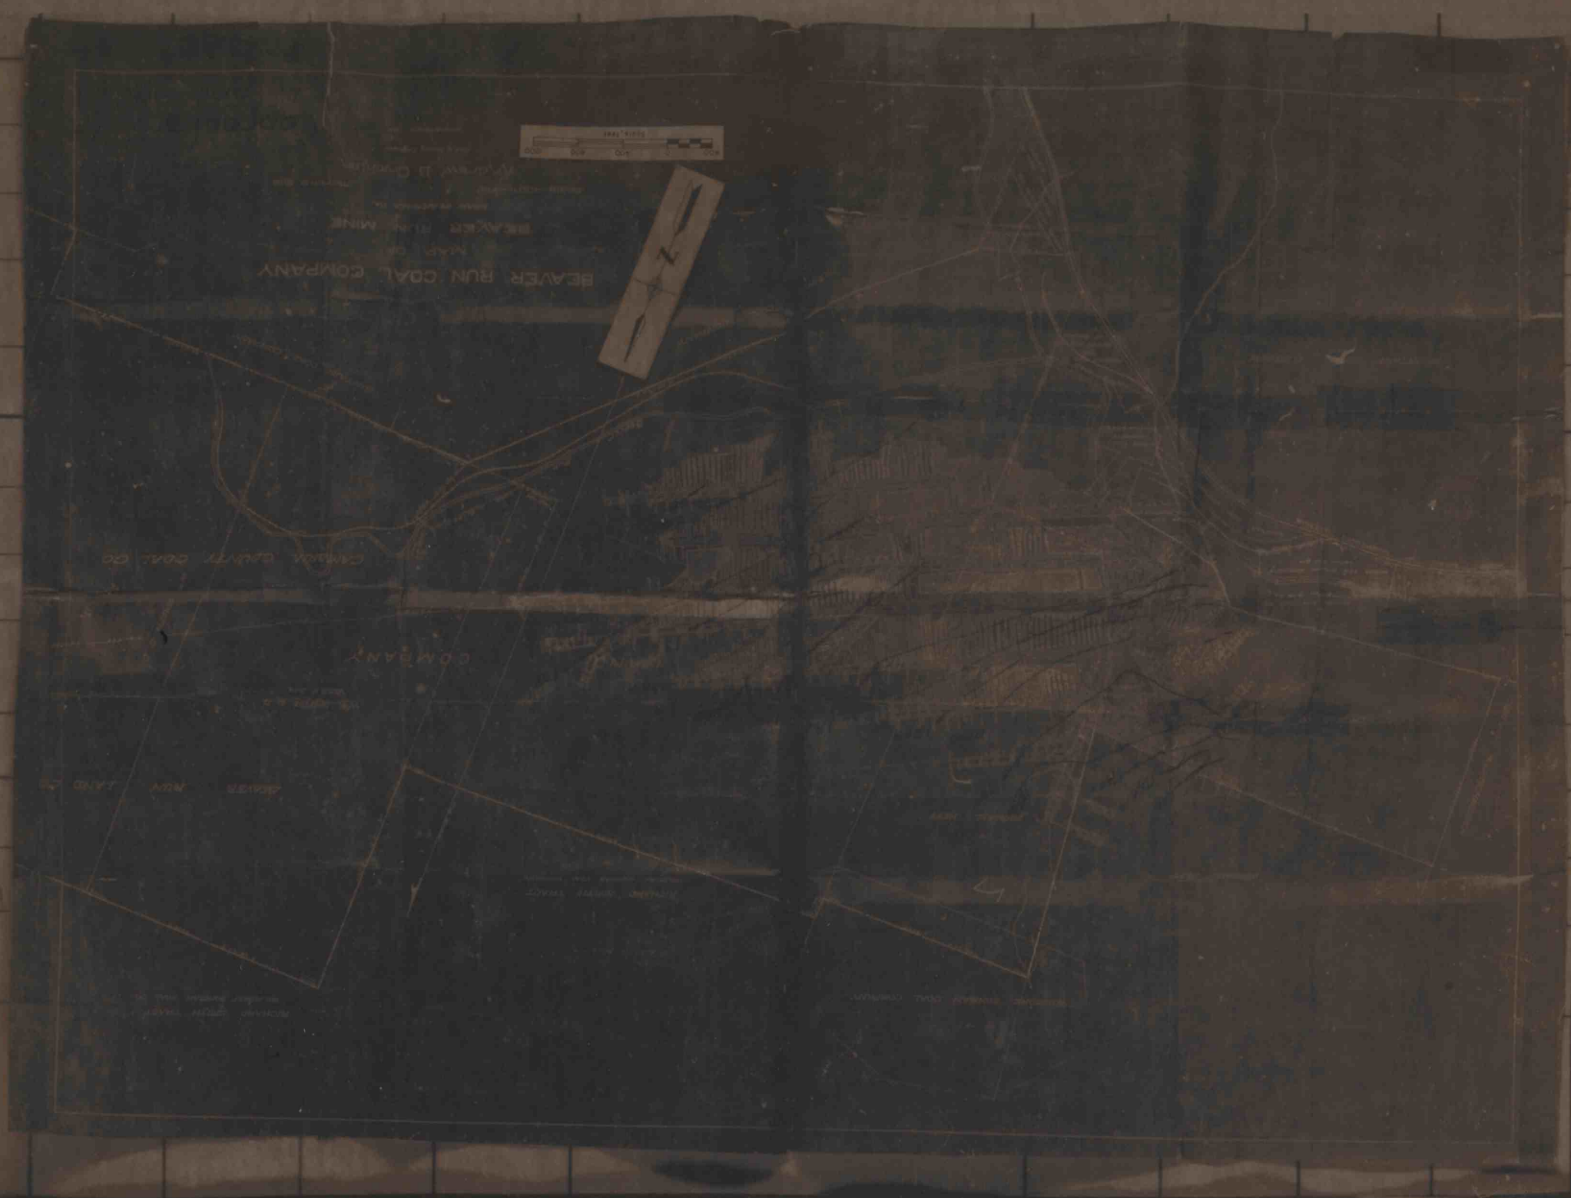

Beaver Run Coal Co
Property Map
Showing
DEVELOPMENT OF BEAVER RUN MINE
SCHEMATIC
Scale
LEGEND
COMPANY COAL COMPANY
