


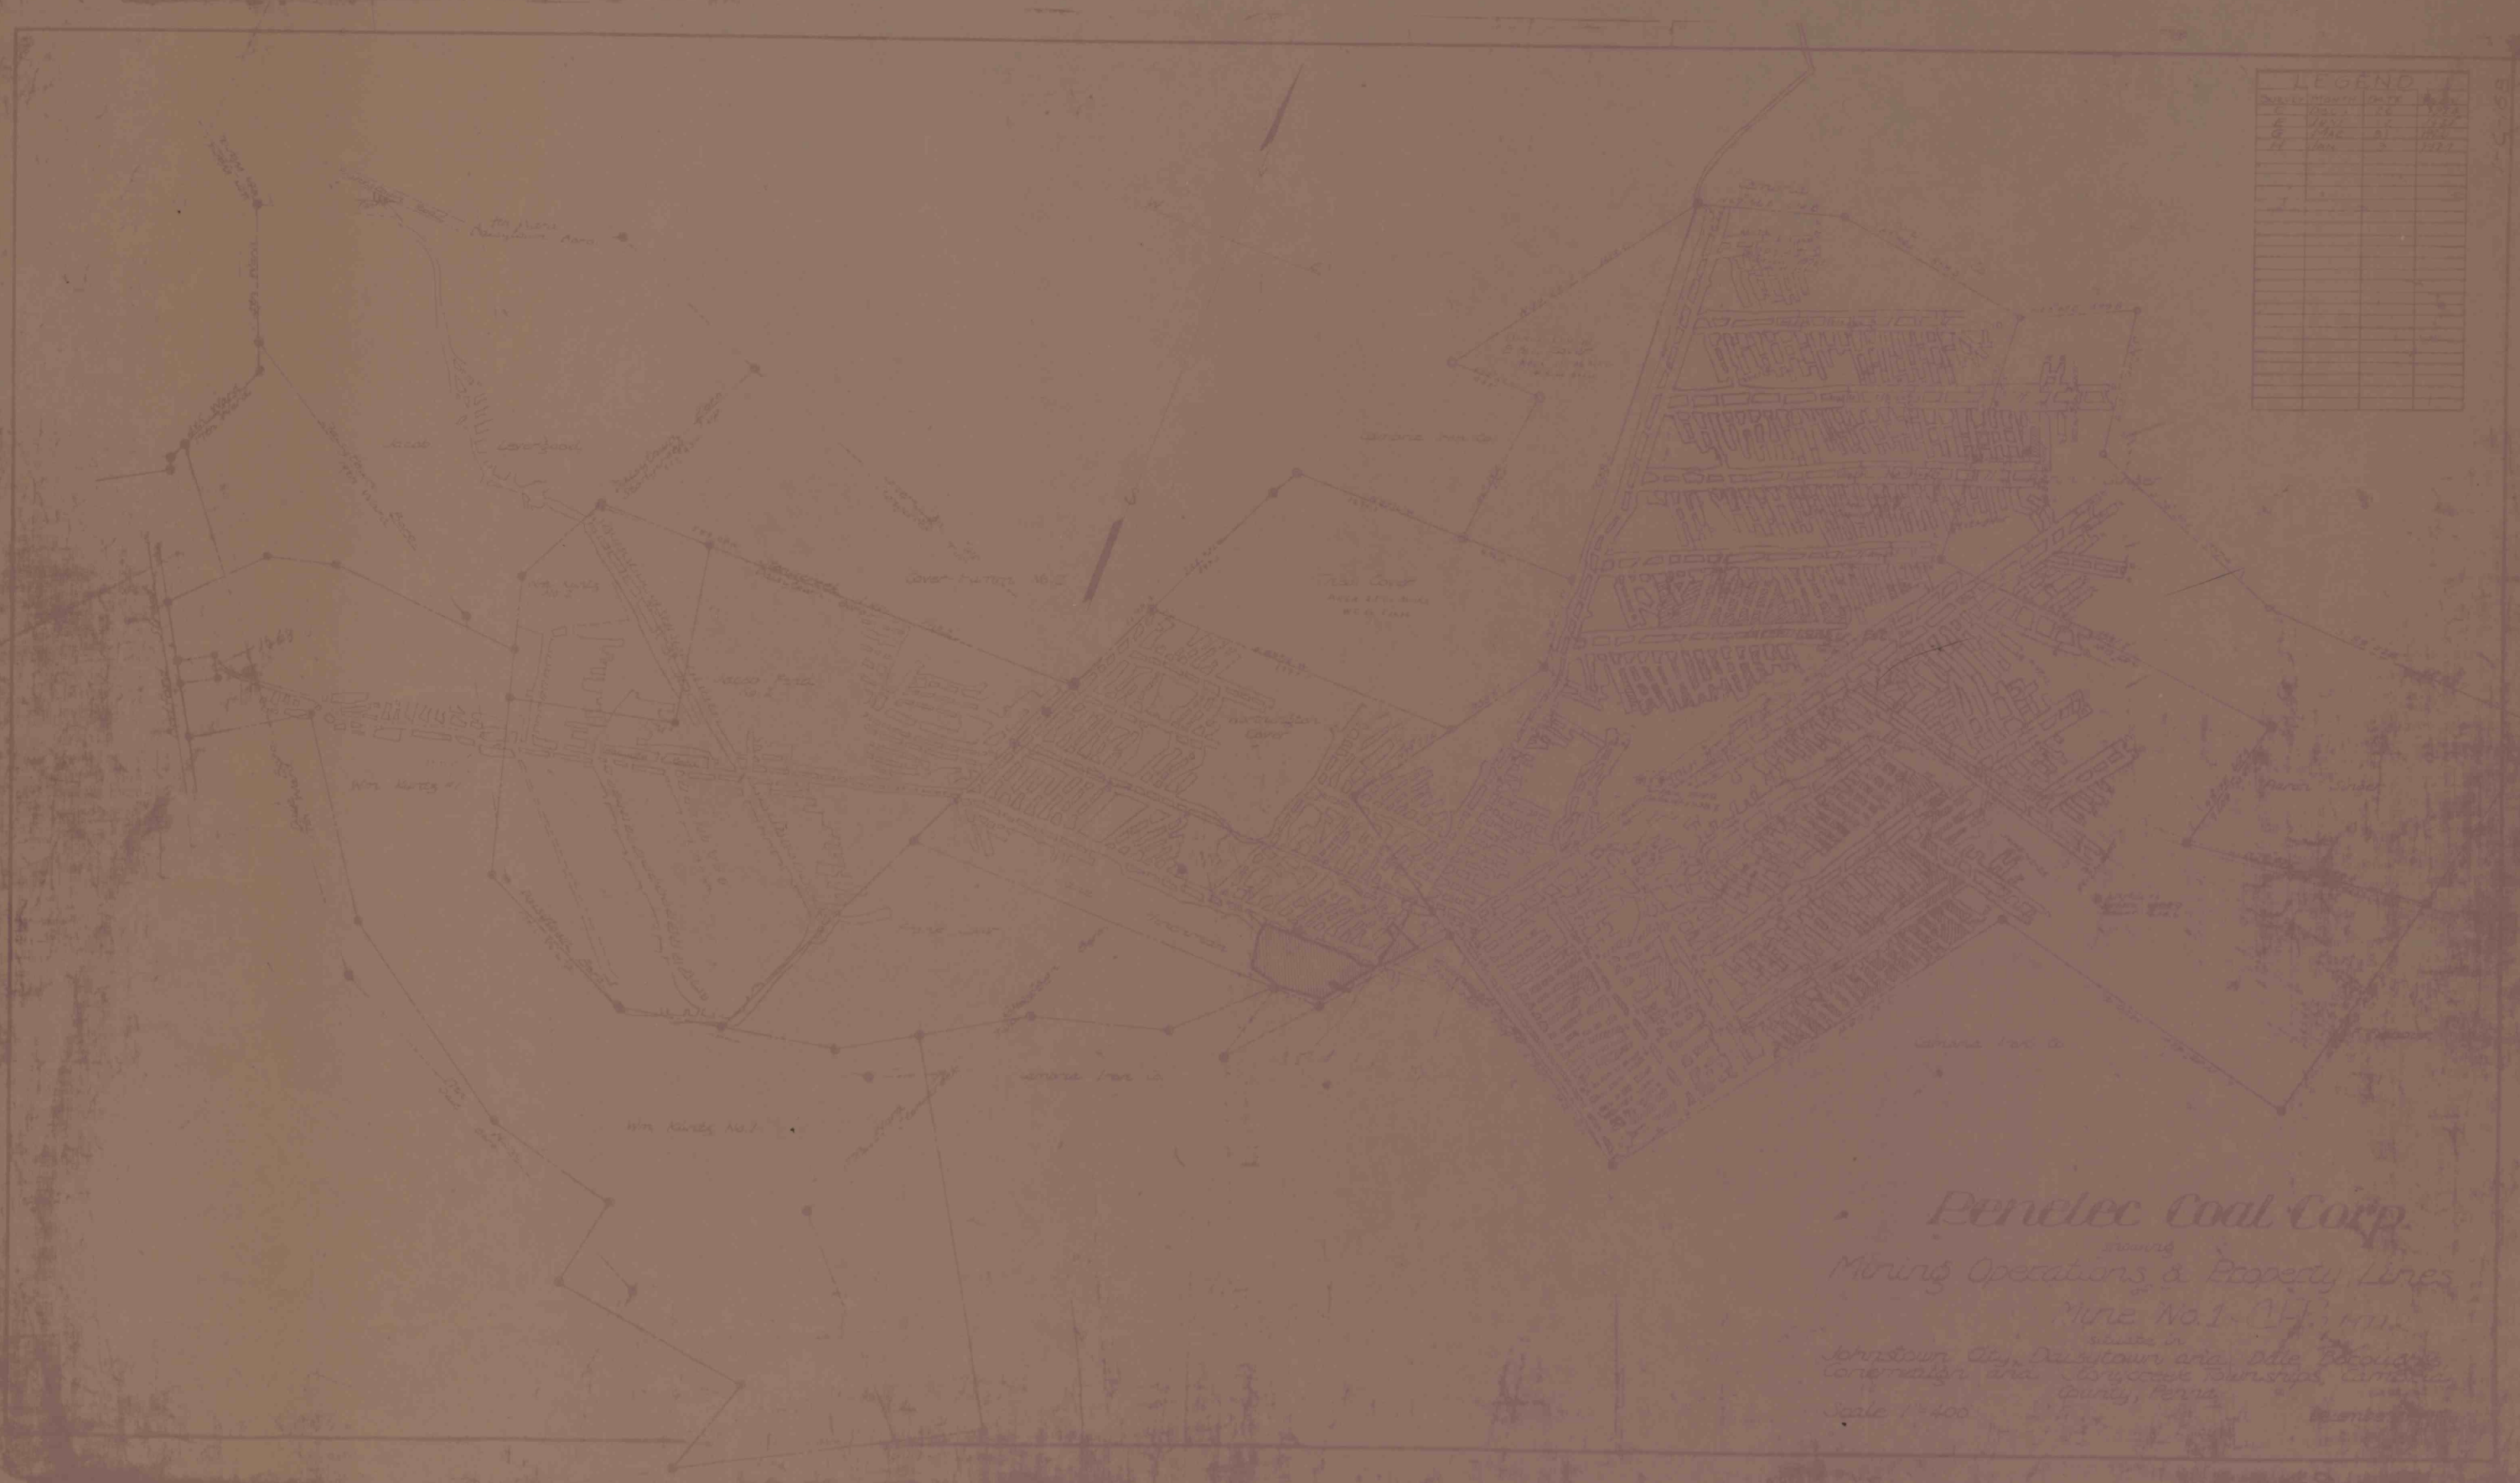

LEGEND	

Penelec Coal Corp.
Mining Operations & Property Lines
Mine No. 1 - CH. 1111
Situated in
County, Pennsylvania
Scale 1" = 400'

457

457