PLAN SHOWING LOCATIONS
SCALE 1"=20'

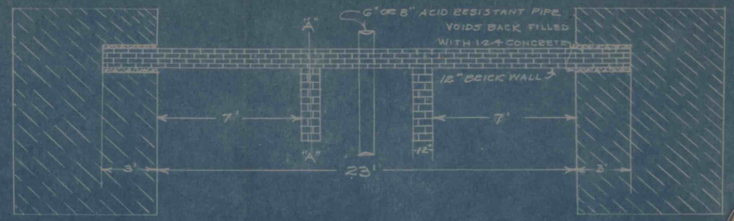

HORIZONTAL VIEW
SCALE 1"=4'

VERTICAL VIEW
SCALE 1"=4'

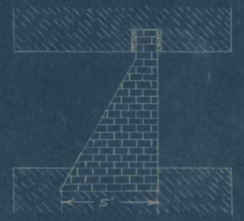

SECTION "A"-"A"
SCALE 1"=4'

MORTAR WILL CONSIST OF 1 PART CEMENT 2 PARTS CLEAN SAND
PRESSURE NO. 2 DAM 582 LBS. PER SQ. FT.
CRUSHING STRENTH OF DAM 691,200 LBS PER SQ. FT BRICK @ 400 LBS SQ. IN.

PLAN OF PROPOSED DAMS
"D" 4 HEADING OFF D" MAIN HEADING IN
STERLING COAL CO. NO. 1 MINE
BAKERTON, CAMBRIA CO., PENNA.
OCTOBER 7, 1957 SCALE AS SHOWN
WILLIAM R. KELLY REG. ENGR.

COMMONWEALTH OF PENNSYLVANIA }
COUNTY OF CAMBRIA }

PERSONALLY APPEARED BEFORE ME, A NOTARY PUBLIC IN AND FOR SAID COUNTY AND STATE JOSEPH GOLGOSKY MINE FOREMAN OF SAID MINE WHO ACKNOWLEDGES, THAT HE PERSONALLY SUPERVISED THE CONSTRUCTION OF DAMS AS SHOWN ON THIS DRAWING AND CONFIRMS THAT SAID DAMS WERE CONSTRUCTED ACCORDING TO THIS PLAN AND SPECIFICATIONS.

SWORN AND SUBSCRIBED BEFORE ME.
THIS 11th DAY OF JULY, 1958
Irene M. Keegan
Notary Public
My Comm. Expires 1/15/59

Joseph Golgosky
MINE FOREMAN

APPROVED FOR PENNSYLVANIA DEPARTMENT OF MINES & MINERAL INDUSTRIES

Geo. S. Rock
Edward R. Conner
Lawrence Jones
MEMBERS OF COMMISSION

435

435