


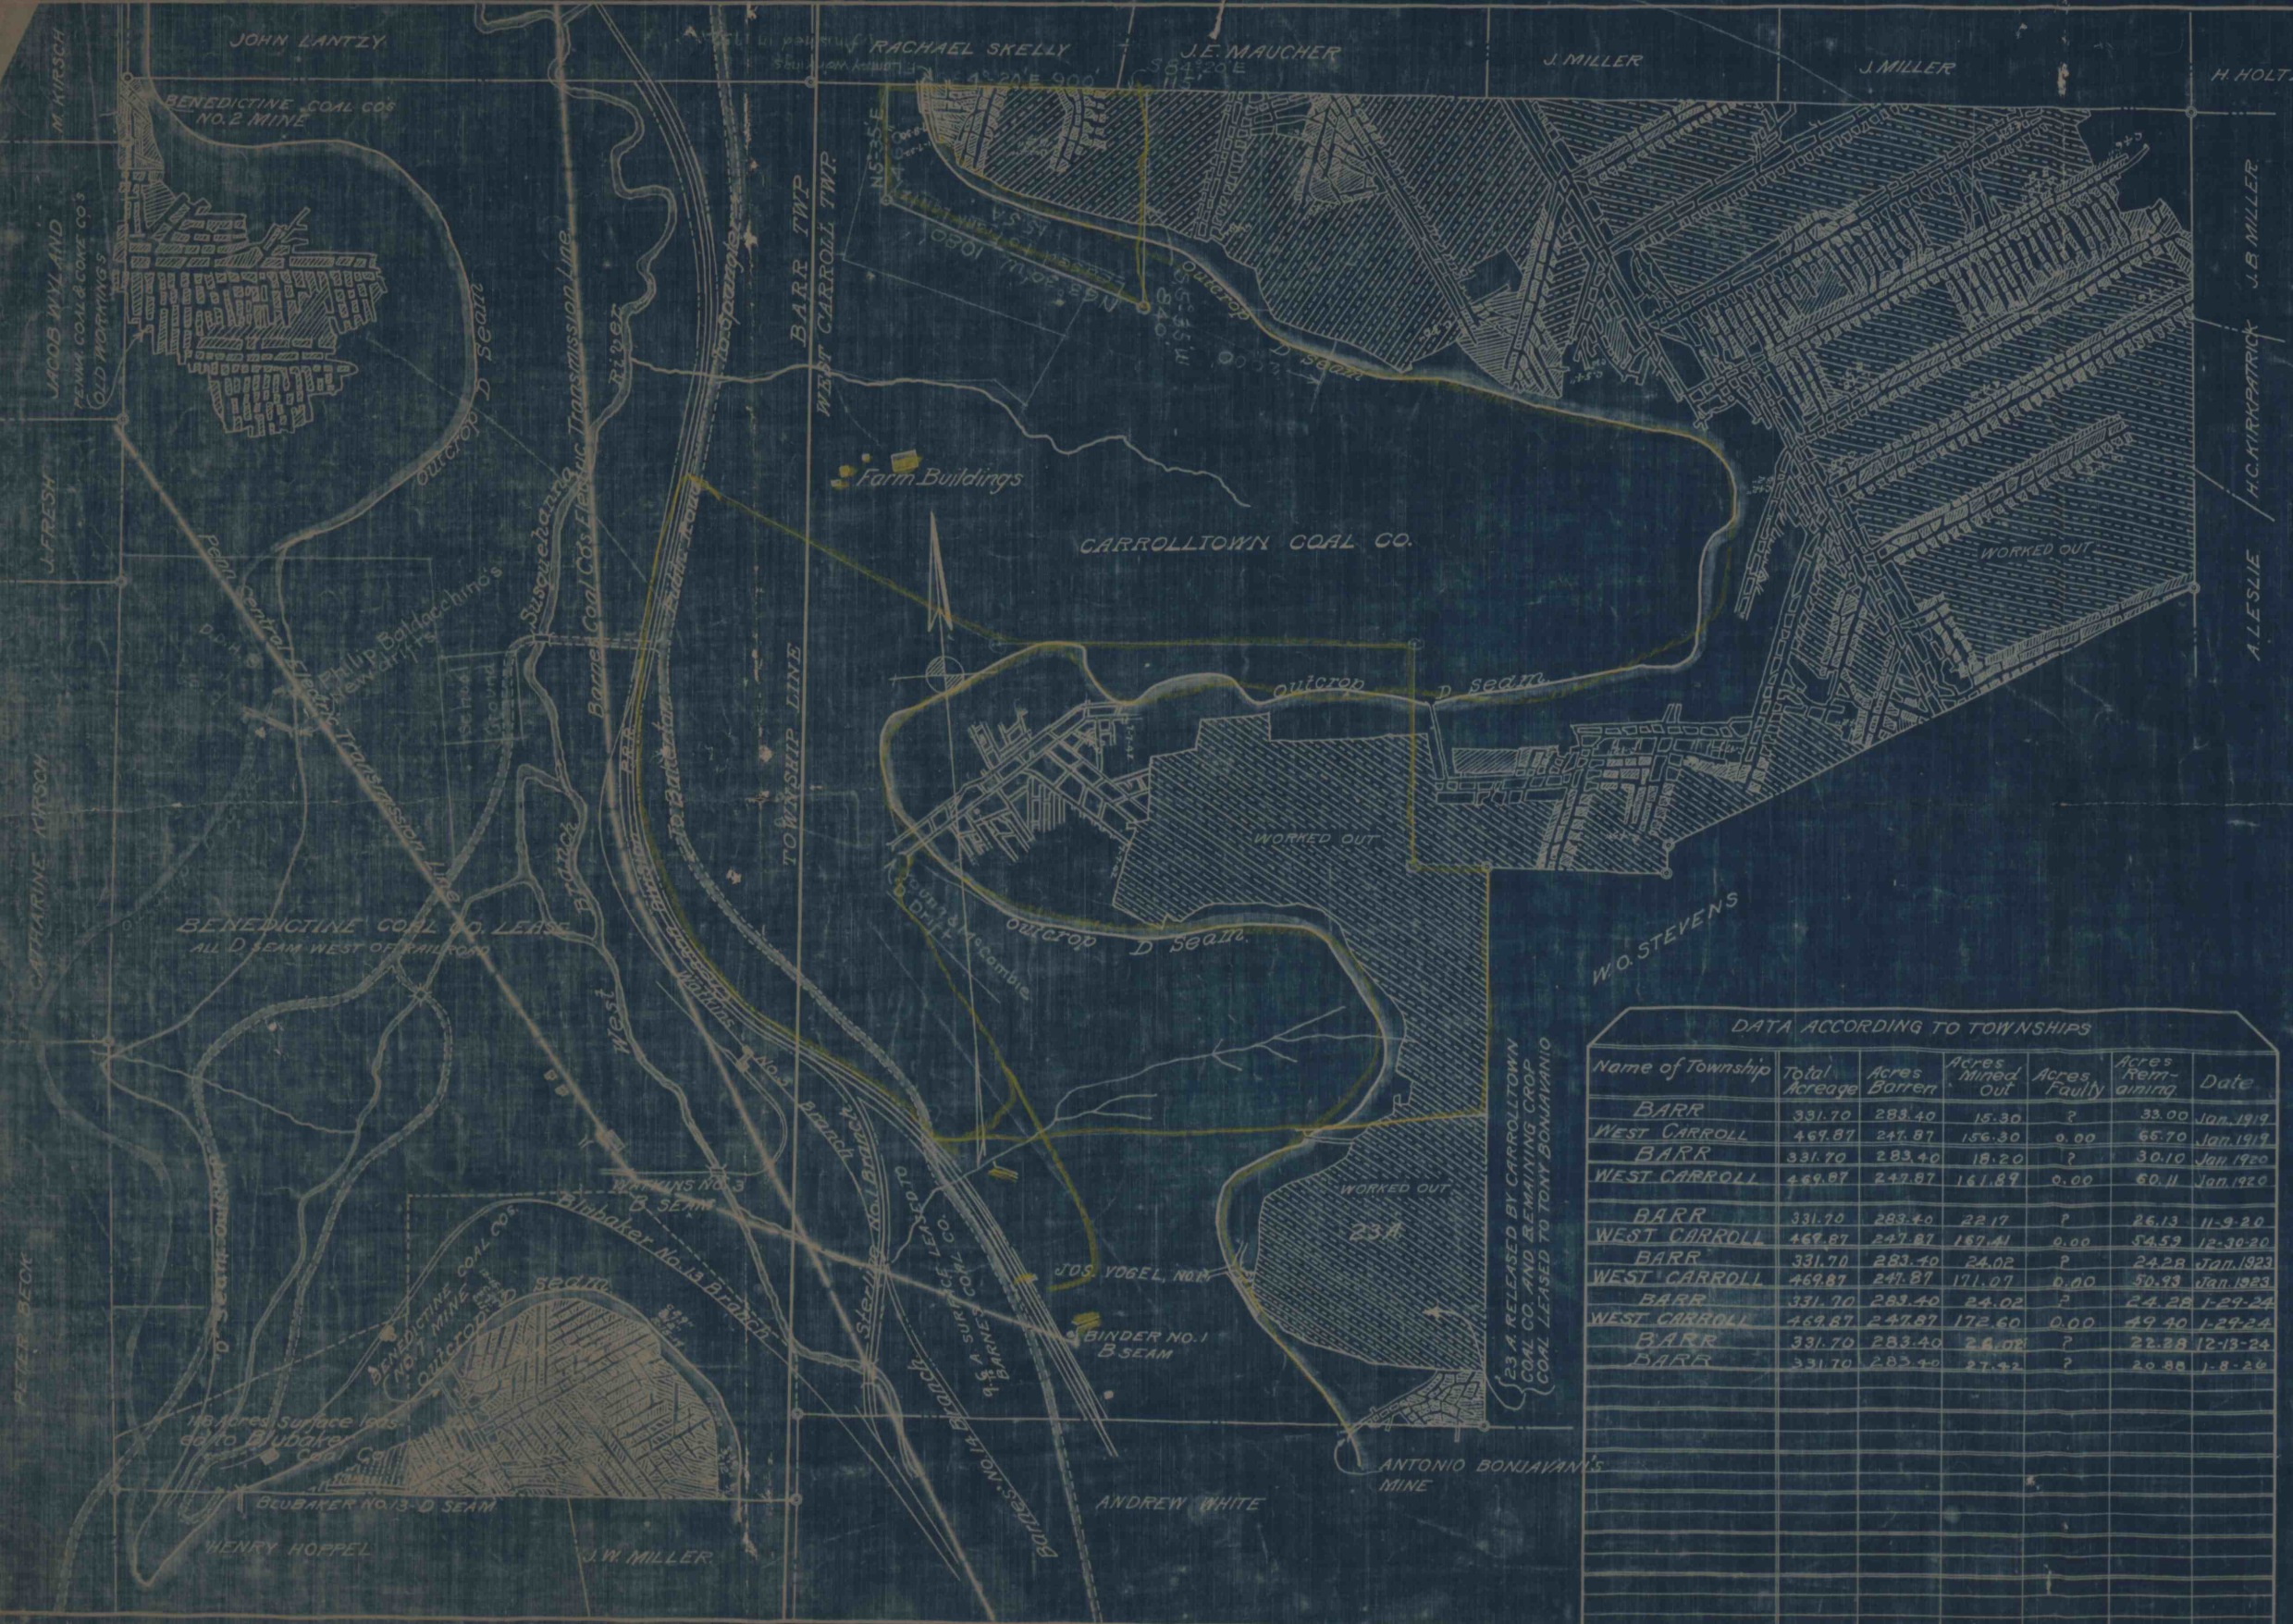

DATA ACCORDING TO LEASES								
NAME OF LESSEE	Total Acreage	Acres Barren	Acres Mined out	Acres Faulty	Acres Rem-aining	Rate Per Ton	Annual Minum-ing	Date
CARROLLTOWN COAL CO.	446.87	244.47	137.70	0.00	66.70	10.8152	100,000	1-1-1919
BENEDICTINE COAL CO.	331.70	283.40	15.30	?	33.00	10.8152	100,000	Jan 1919
BONJAVANI	23.00	3.40	16.60	0.00	3.00			Jan 1919
CARROLLTOWN COAL CO.	446.87	244.47	143.28	0.00	59.12			7-10-19
BENEDICTINE COAL CO.	331.70	283.40	16.93	0.00	31.37			7-10-19
CARROLLTOWN COAL CO.	446.87	244.47	145.29	0.00	57.11			7-10-19
Benedictine coal Co.	331.70	283.40	18.20	?	30.10	15.2	2,000	12-15-20
Carrolltown Coal Co.	446.87	244.47	150.81	0.00	51.59	15.2	2,000	12-15-20
Benedictine Coal Co.	331.70	283.40	22.17	?	26.13	15.2	2,000	12-15-20
CARROLLTOWN COAL CO.	446.87	244.47	154.47	0.00	47.93	15.2	15,000	Jan 1923
BENEDICTINE COAL CO.	331.70	283.40	24.02	?	24.28	15.2	15,000	Jan 1923
CARROLLTOWN COAL CO.	446.87	244.47	156.00	0.00	46.40	15.2	15,000	1-2-24
EMILY ELIZA "	331.70	283.40	26.02	?	22.28	15.2	2,000	12-15-24
" "	331.70	283.40	27.42	?	20.88	15.2	2,000	1-8-24

DATA ACCORDING TO TOWNSHIPS						
Name of Township	Total Acreage	Acres Barren	Acres Mined Out	Acres Faulty	Acres Rem-aining	Date
BARR	331.70	283.40	15.30	?	33.00	Jan 1919
WEST CARROLL	446.87	244.47	156.30	0.00	66.70	Jan 1919
BARR	331.70	283.40	18.20	?	30.10	Jan 1920
WEST CARROLL	446.87	244.47	161.89	0.00	60.11	Jan 1920
BARR	331.70	283.40	22.17	?	26.13	11-9-20
WEST CARROLL	446.87	244.47	167.41	0.00	54.59	12-30-20
BARR	331.70	283.40	24.02	?	24.28	Jan 1923
WEST CARROLL	446.87	244.47	171.07	0.00	50.93	Jan 1923
BARR	331.70	283.40	24.02	?	24.28	1-29-24
WEST CARROLL	446.87	244.47	172.60	0.00	49.40	1-29-24
BARR	331.70	283.40	26.02	?	22.28	12-15-24
BARR	331.70	283.40	27.42	?	20.88	1-8-24

31105.2.504

MAP SHOWING
SURFACE & D SEAM ONLY
OF COAL LANDS
BELONGING TO
BENEDICTINE SOCIETY
IN BARR & WEST CARROLL TOWNSHIPS
CAMBRIA CO., PA.

JAN. 19, 1919. SCALE 1" = 400'

J. J. Pfeister, Engr.
Bangor, Pa.