




FORGE COAL MINING CO.
MAP OF
NO. 1 SLOPE
PURITAN, PA.
Scale 1" = 100'

PDVMS 03053 205 26X 318721

MAIN LEFT HEADING

PDVMS 03053 206 26X 318721

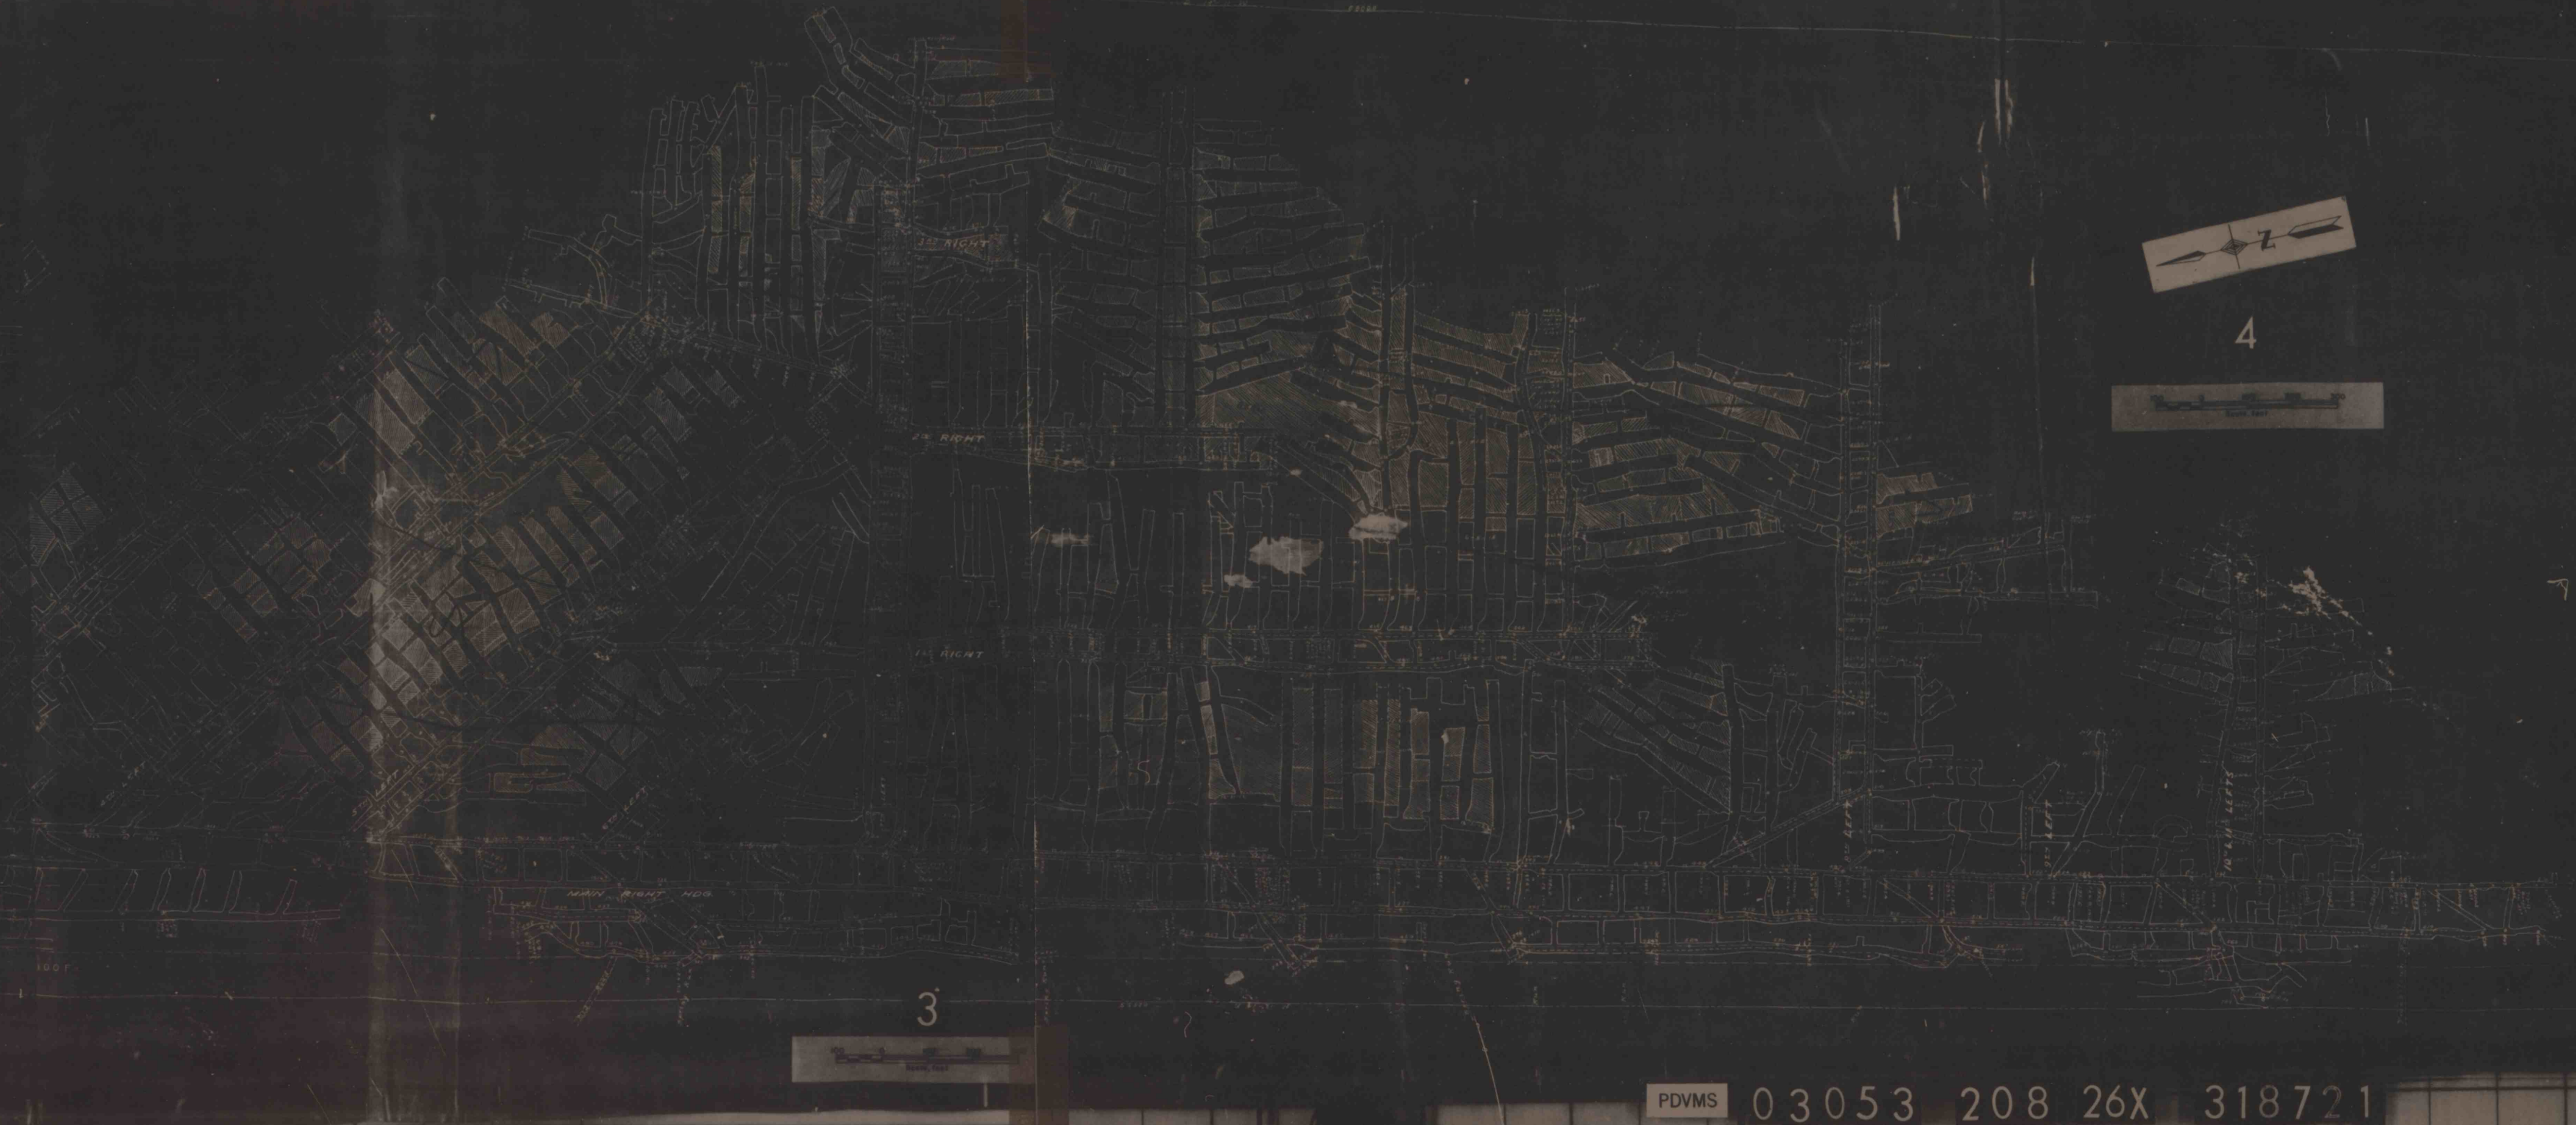

3

PDVMS 03053 207 26X 3



4

PDVMS 03053 208 26X 318721