


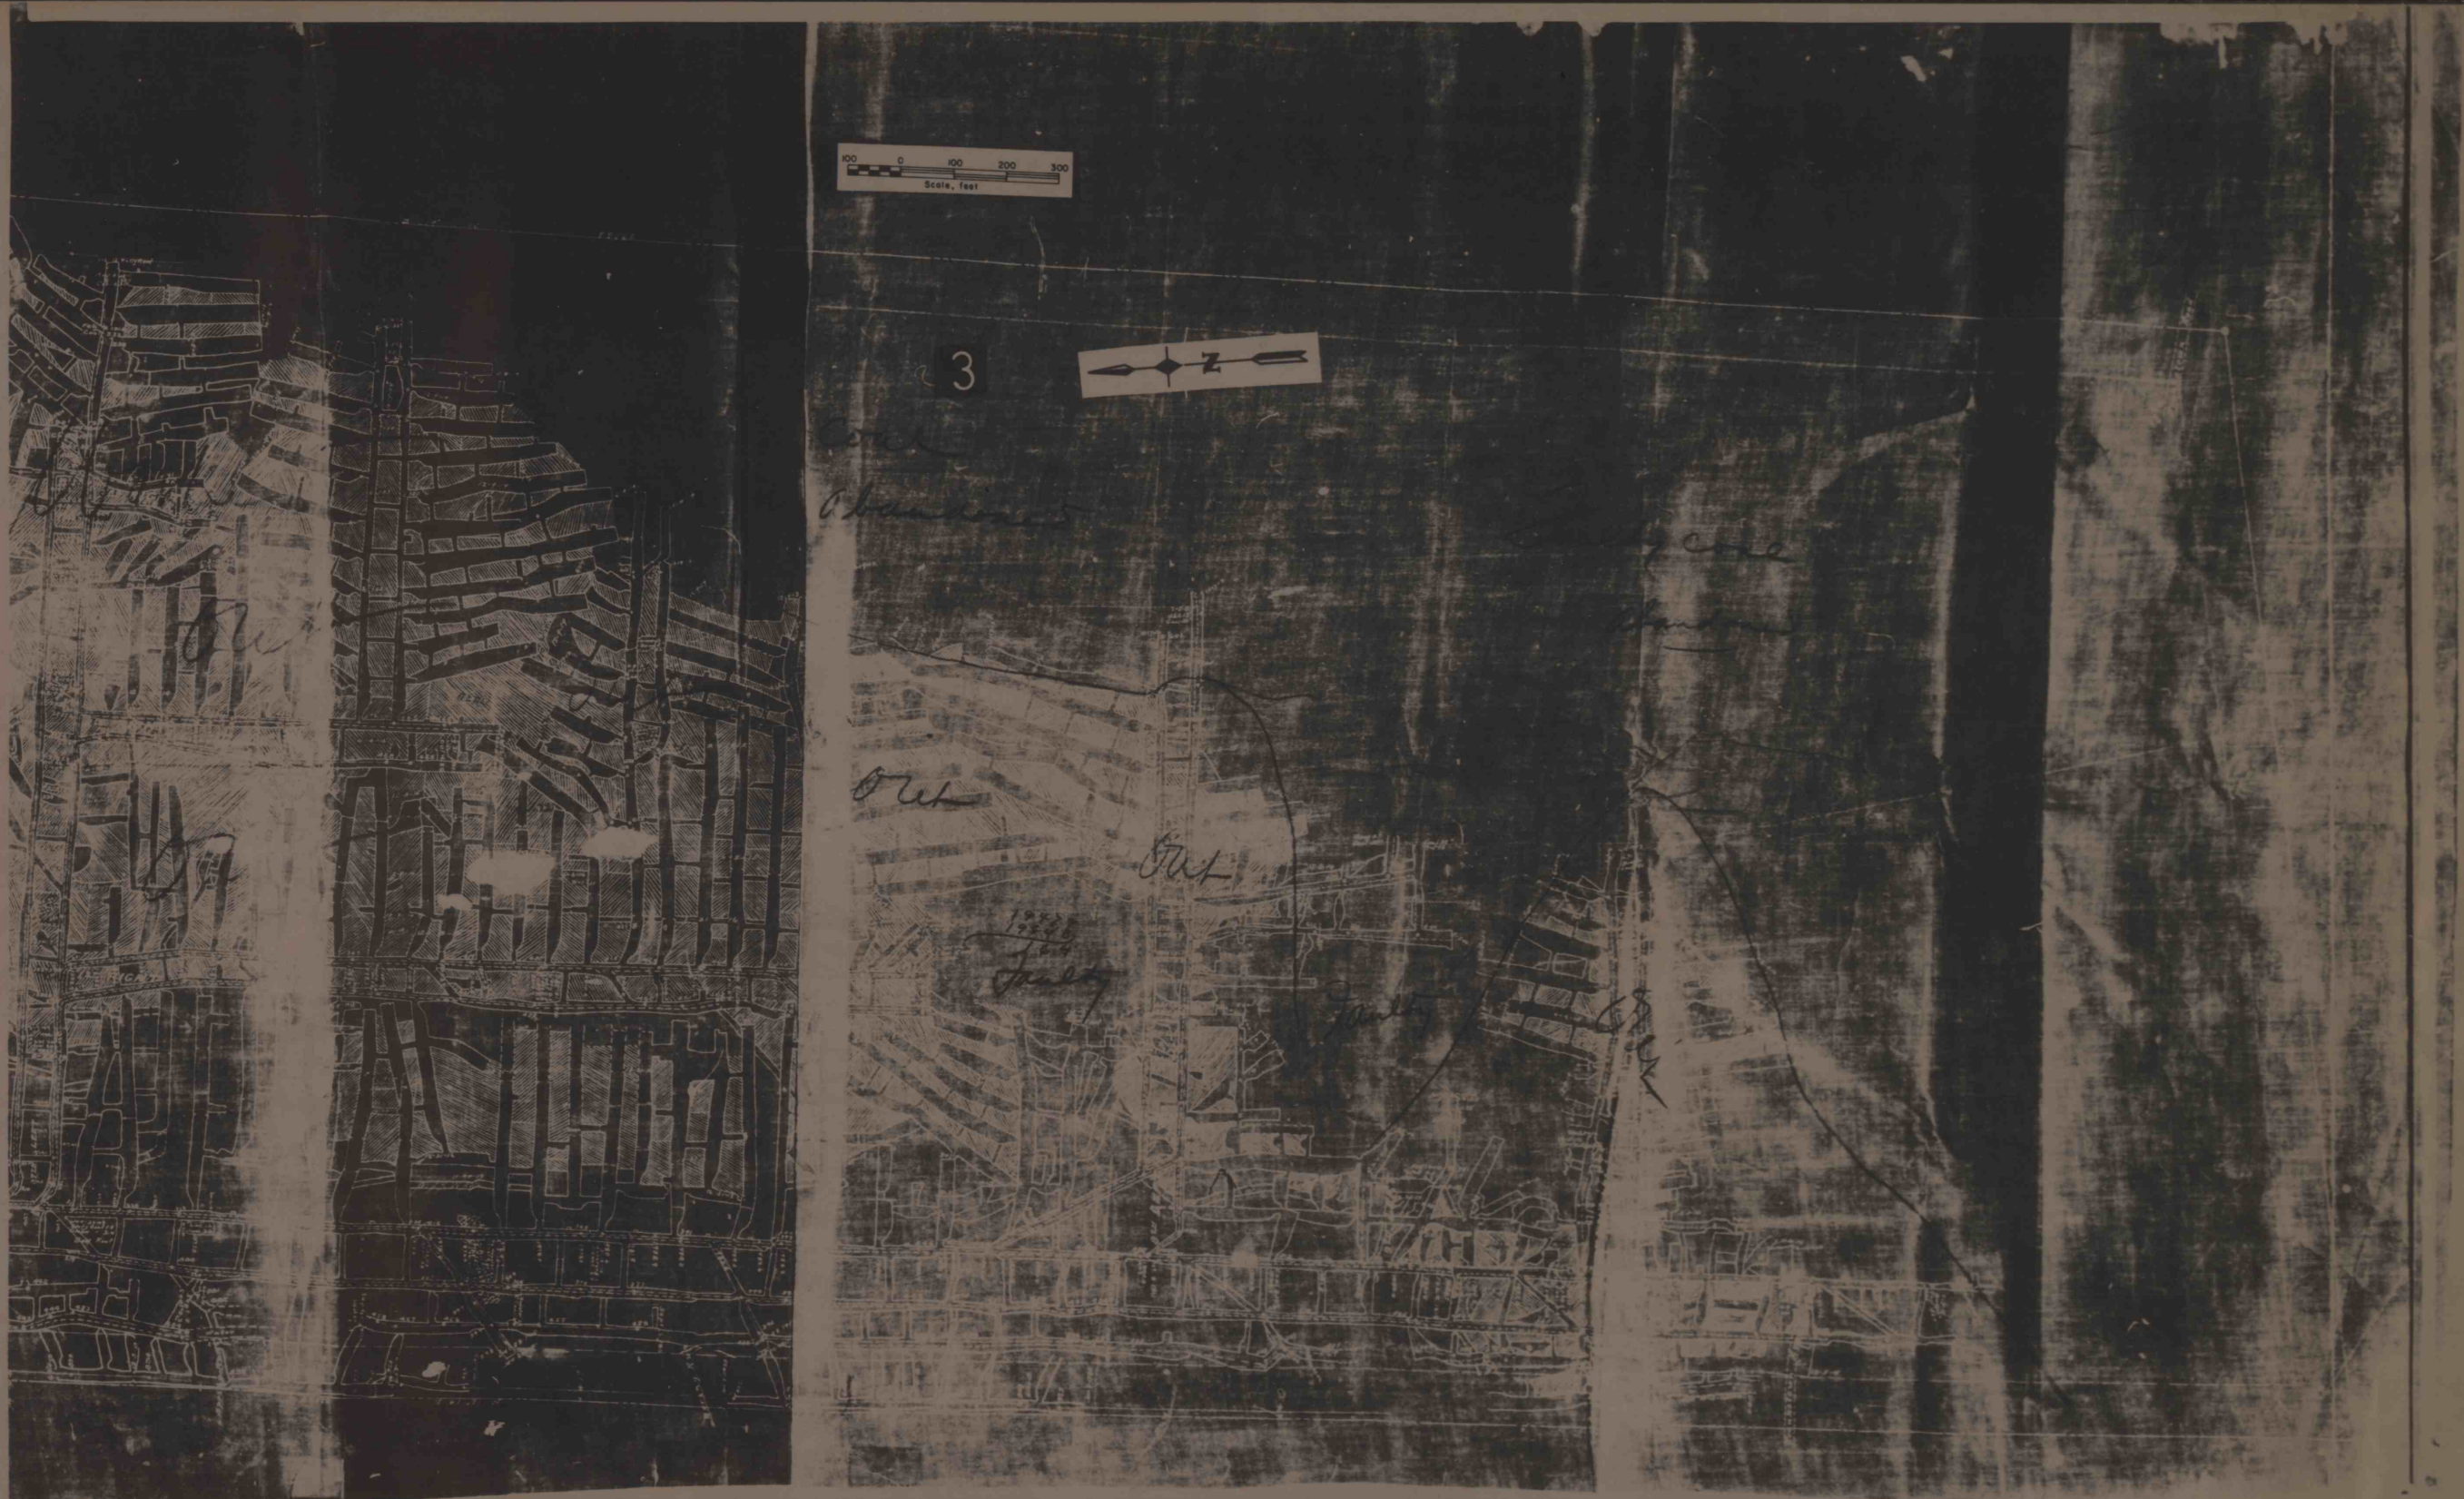

03009

14

28X

302874