


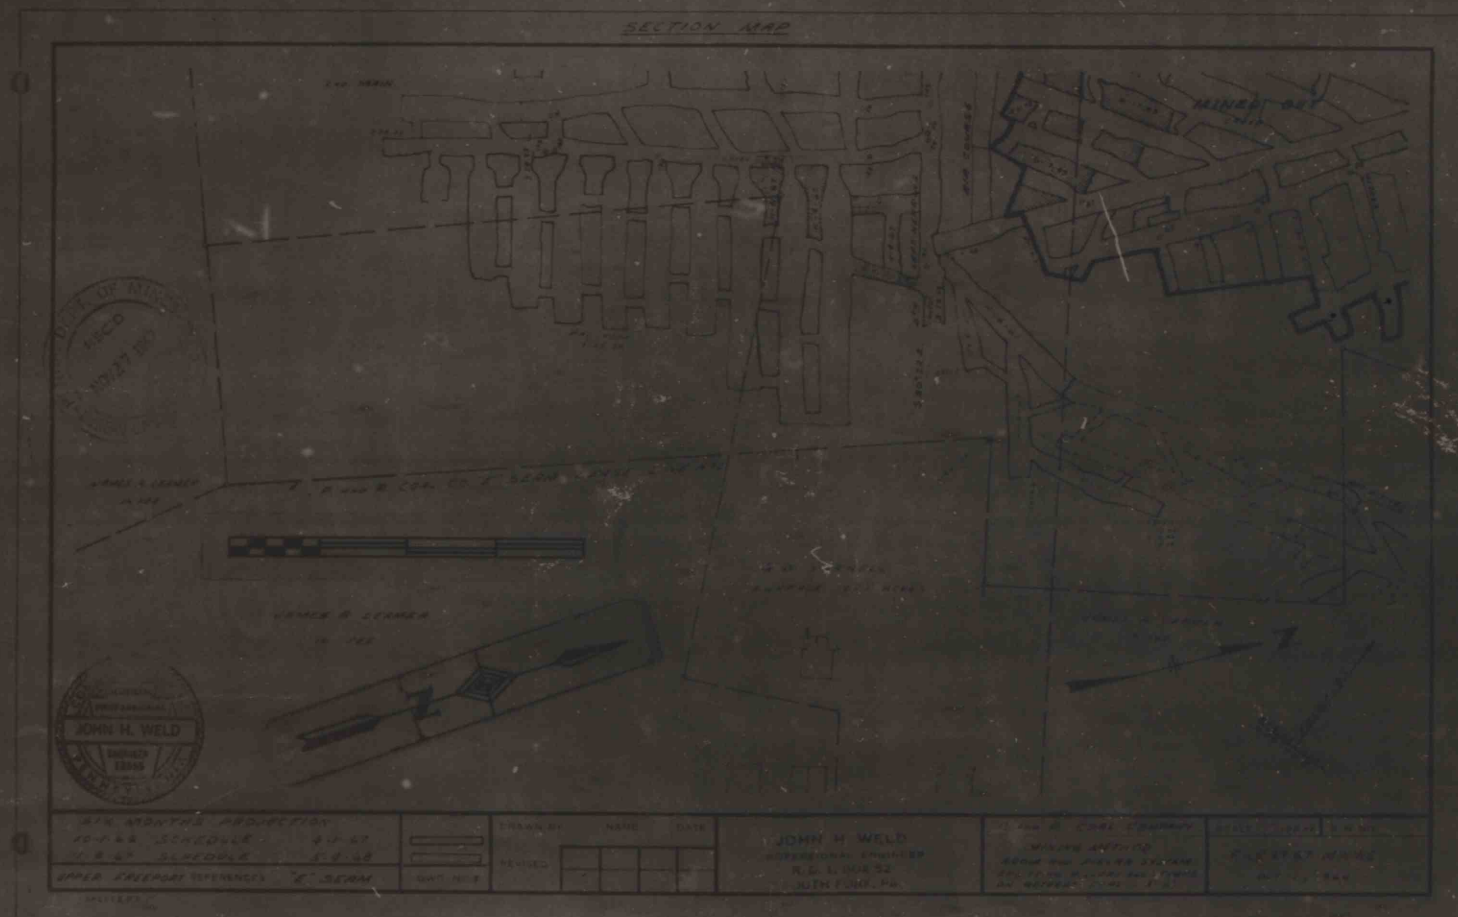








PDVMS 03128 474 18X 349306

458

458