

RECORD MAP
of the
MANOR REAL ESTATE & TRUST CO'S.
ELK CREEK COAL PROPERTY

CAMARIA AND INDIANA COUNTIES, PA

Scale: One inch = 2000 Feet

Compiled from Manor land maps, mine and property maps of adjoining owners and stadia surveys of the divvillers Eng. Co.


To accompany report of

Edward Volinviere Engineering Co.
Geologists & Mining Engineers
Philadelphia, Penna.

FEBRUARY 1927

LEGEND

- Manor coal holdings before exchange
- Berwind
- Manor after
- surface ownership
- Mine entries - pillars
- Area mined out
- 50' contours on bed B
- Roads

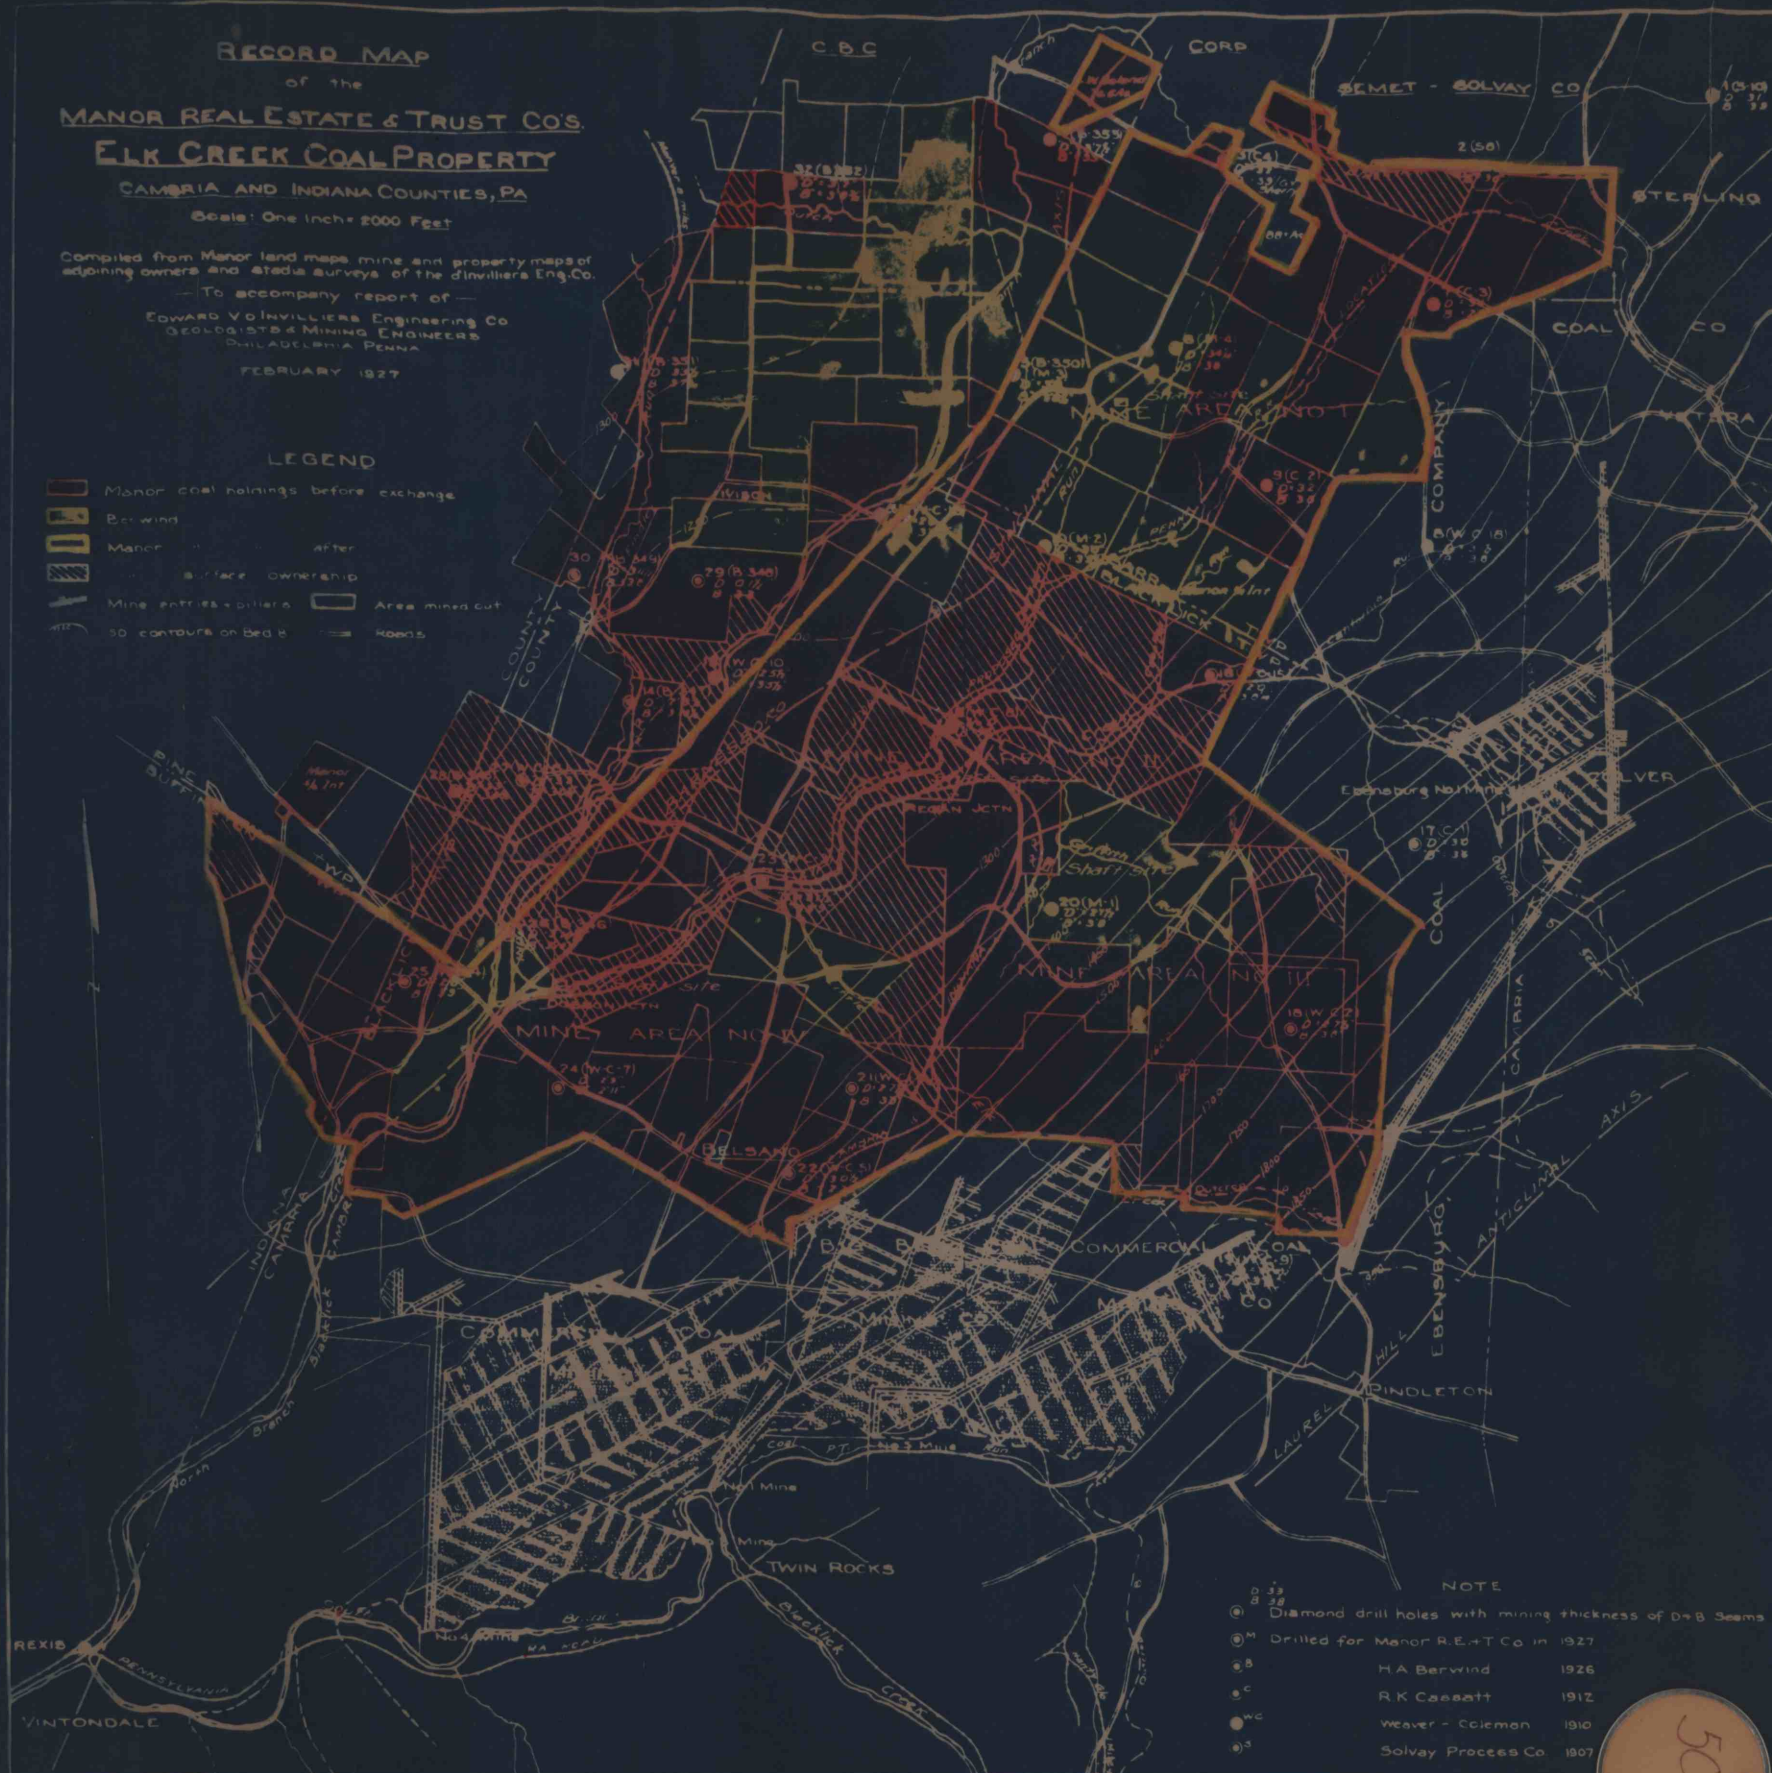

NOTE

- ① Diamond drill holes with mining thickness of D+B Seams
- ② M. Drilled for Manor R.E. & T. Co. in 1927
- ③ H.A. Berwind 1926
- ④ R.K. Cassatt 1912
- ⑤ W.C. Weaver - Coleman 1910
- ⑥ S. Solvay Process Co. 1907

500