


503

J.C. Stinemman, Est
"B" Seam.

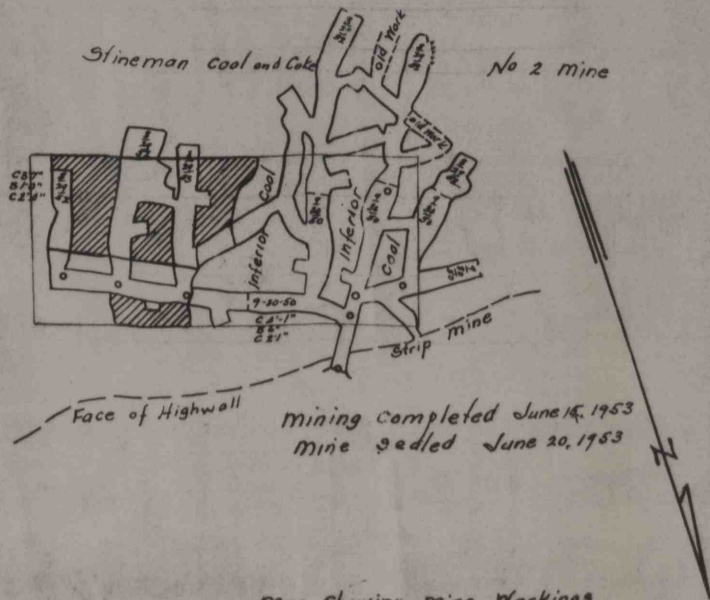

I, Hereby certify that
this blue print is a true
and correct of the original
map of the H. C. Horner mine
and that the original map
is a true complete and correct
map and survey of all the
excavations made in said mine.

Oliver Lee Hoffmann
R.E. 12667

Map showing Mine Workings
of
H. C. Horner
Mine, "B" Seam.
Conemaugh Twp. Cambria Co; Pa
Sept 30, 1950
Scale 1" = 100'

503