
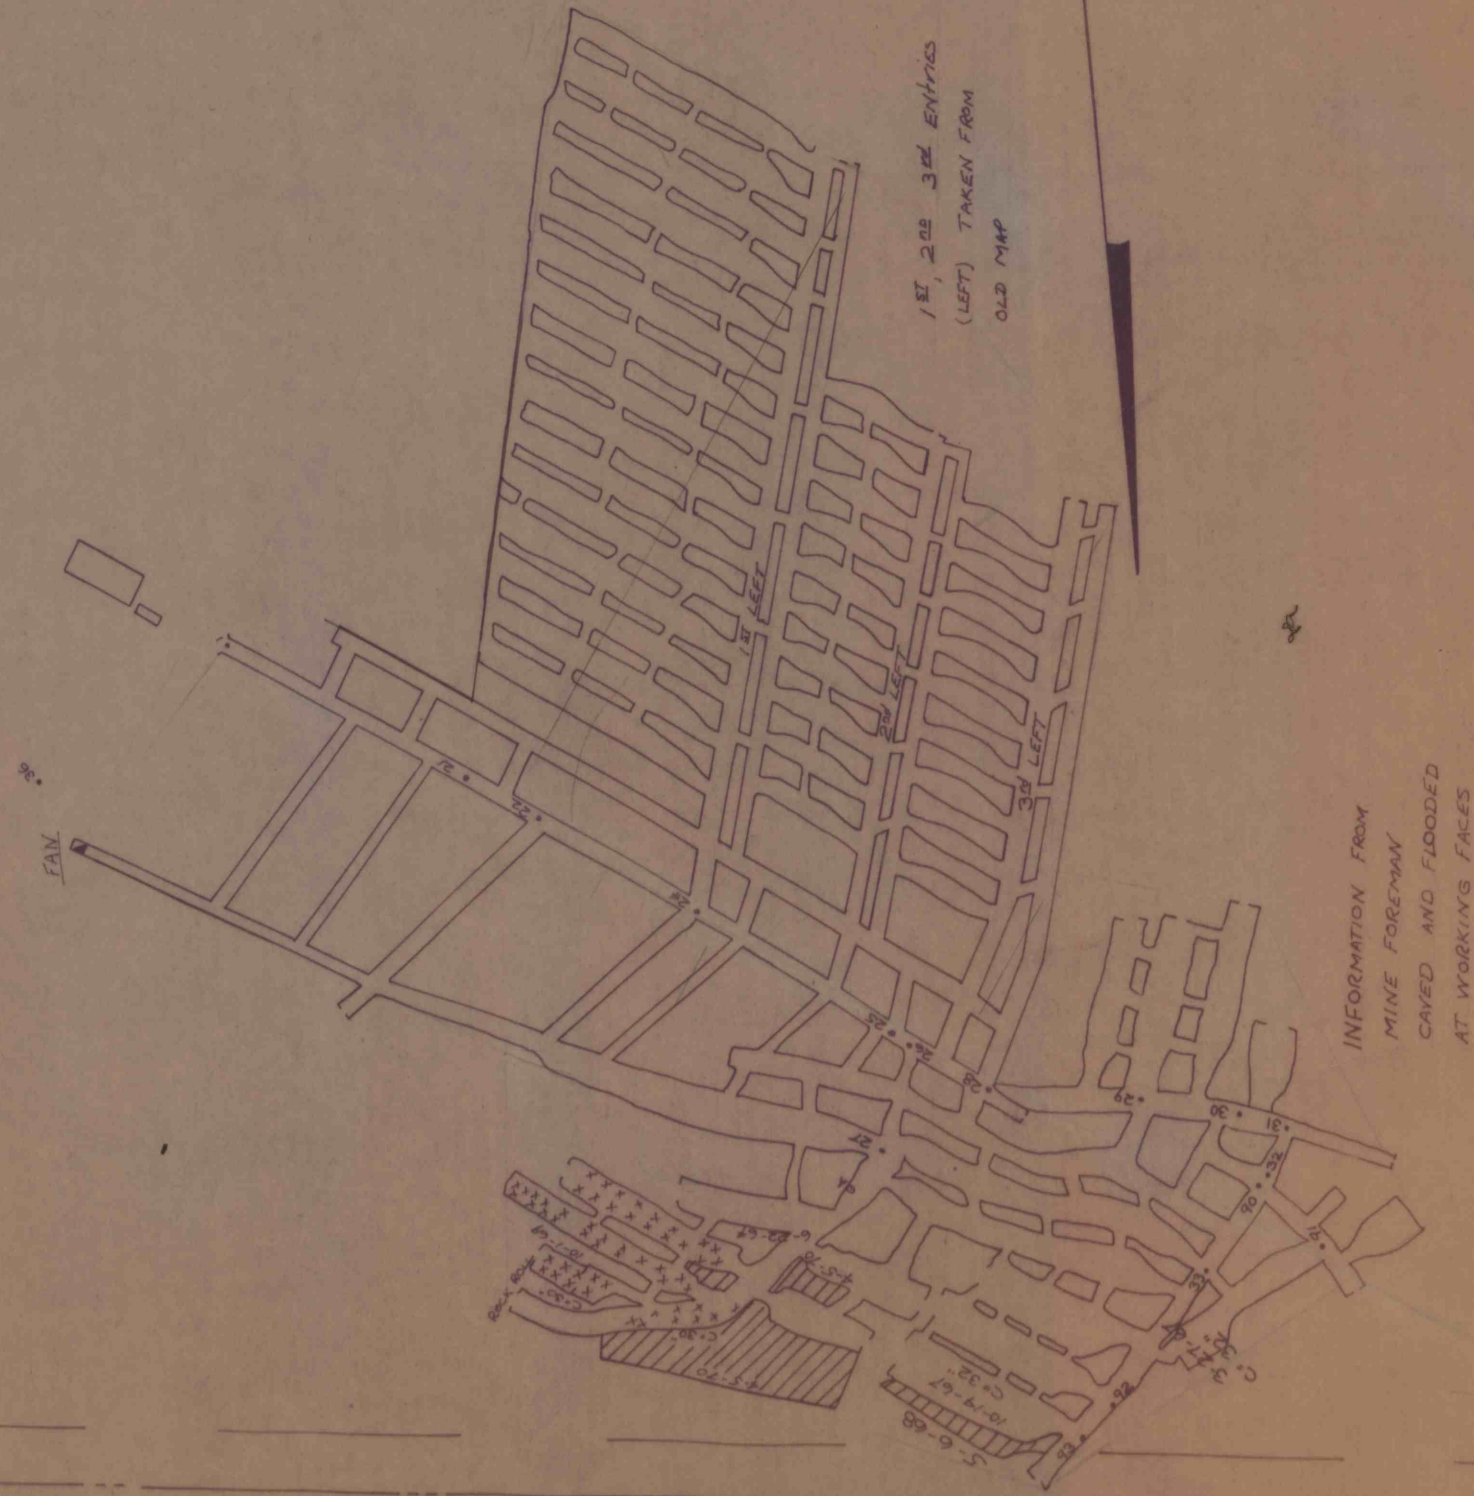


MAP
SHOWING
SERIES WORKINGS OF
HERTZOG COAL CO. NO. 1 MINE
CLEARFIELD TWP., CAMBRIA CO., PA.
SCALE - 1" = 100' 9-9-69
J. L. BAUFELD RES. ENG.

J. C. MCGOUGH SURF.
REGIS. HERTZOG COAL
189.0 AS.

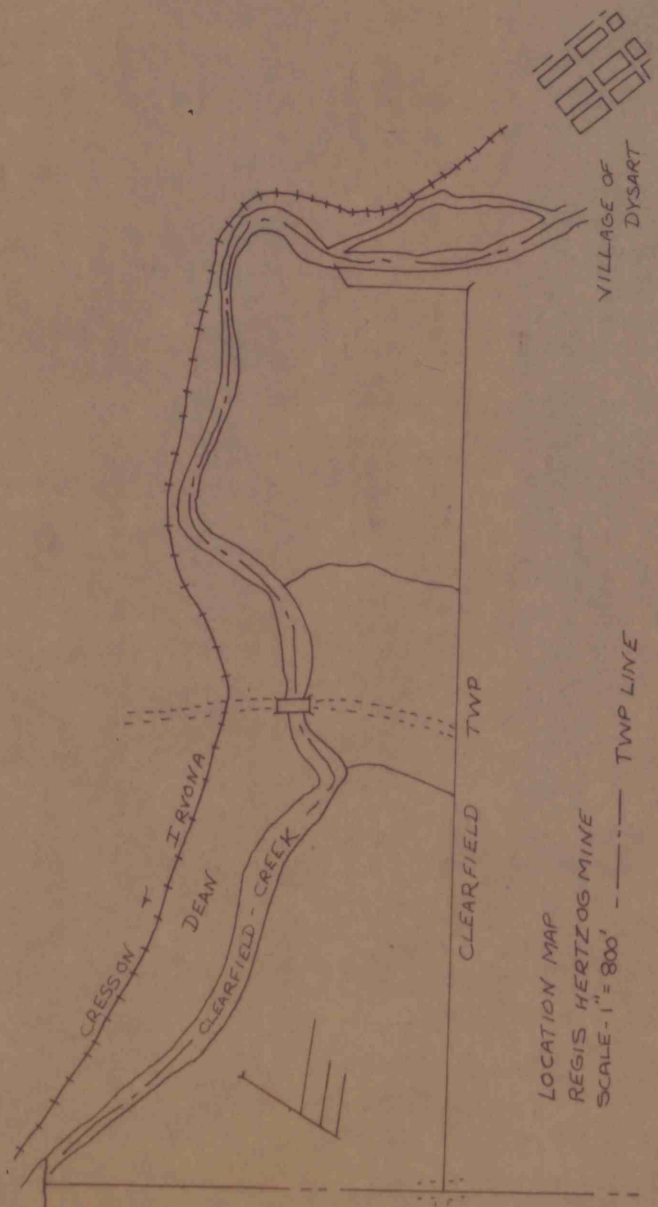

430

EASTERN GAS AND FUEL ASSOCIATES
COAL DIVISION
PITTSBURGH, PA.

430