

424

MAP

SHOWING

P. AND P. COAL CO.


LEASING FROM

LEAMER COAL CO.DUNLOADAMS TOWNSHIP, CAMBRIA COUNTY,PENNSYLVANIA."E" SEAM

SCALE 1" = 200 FT. SEPT. 3, 1966

JOHN H. WELD P.E.

ENGINEERING COMPANY

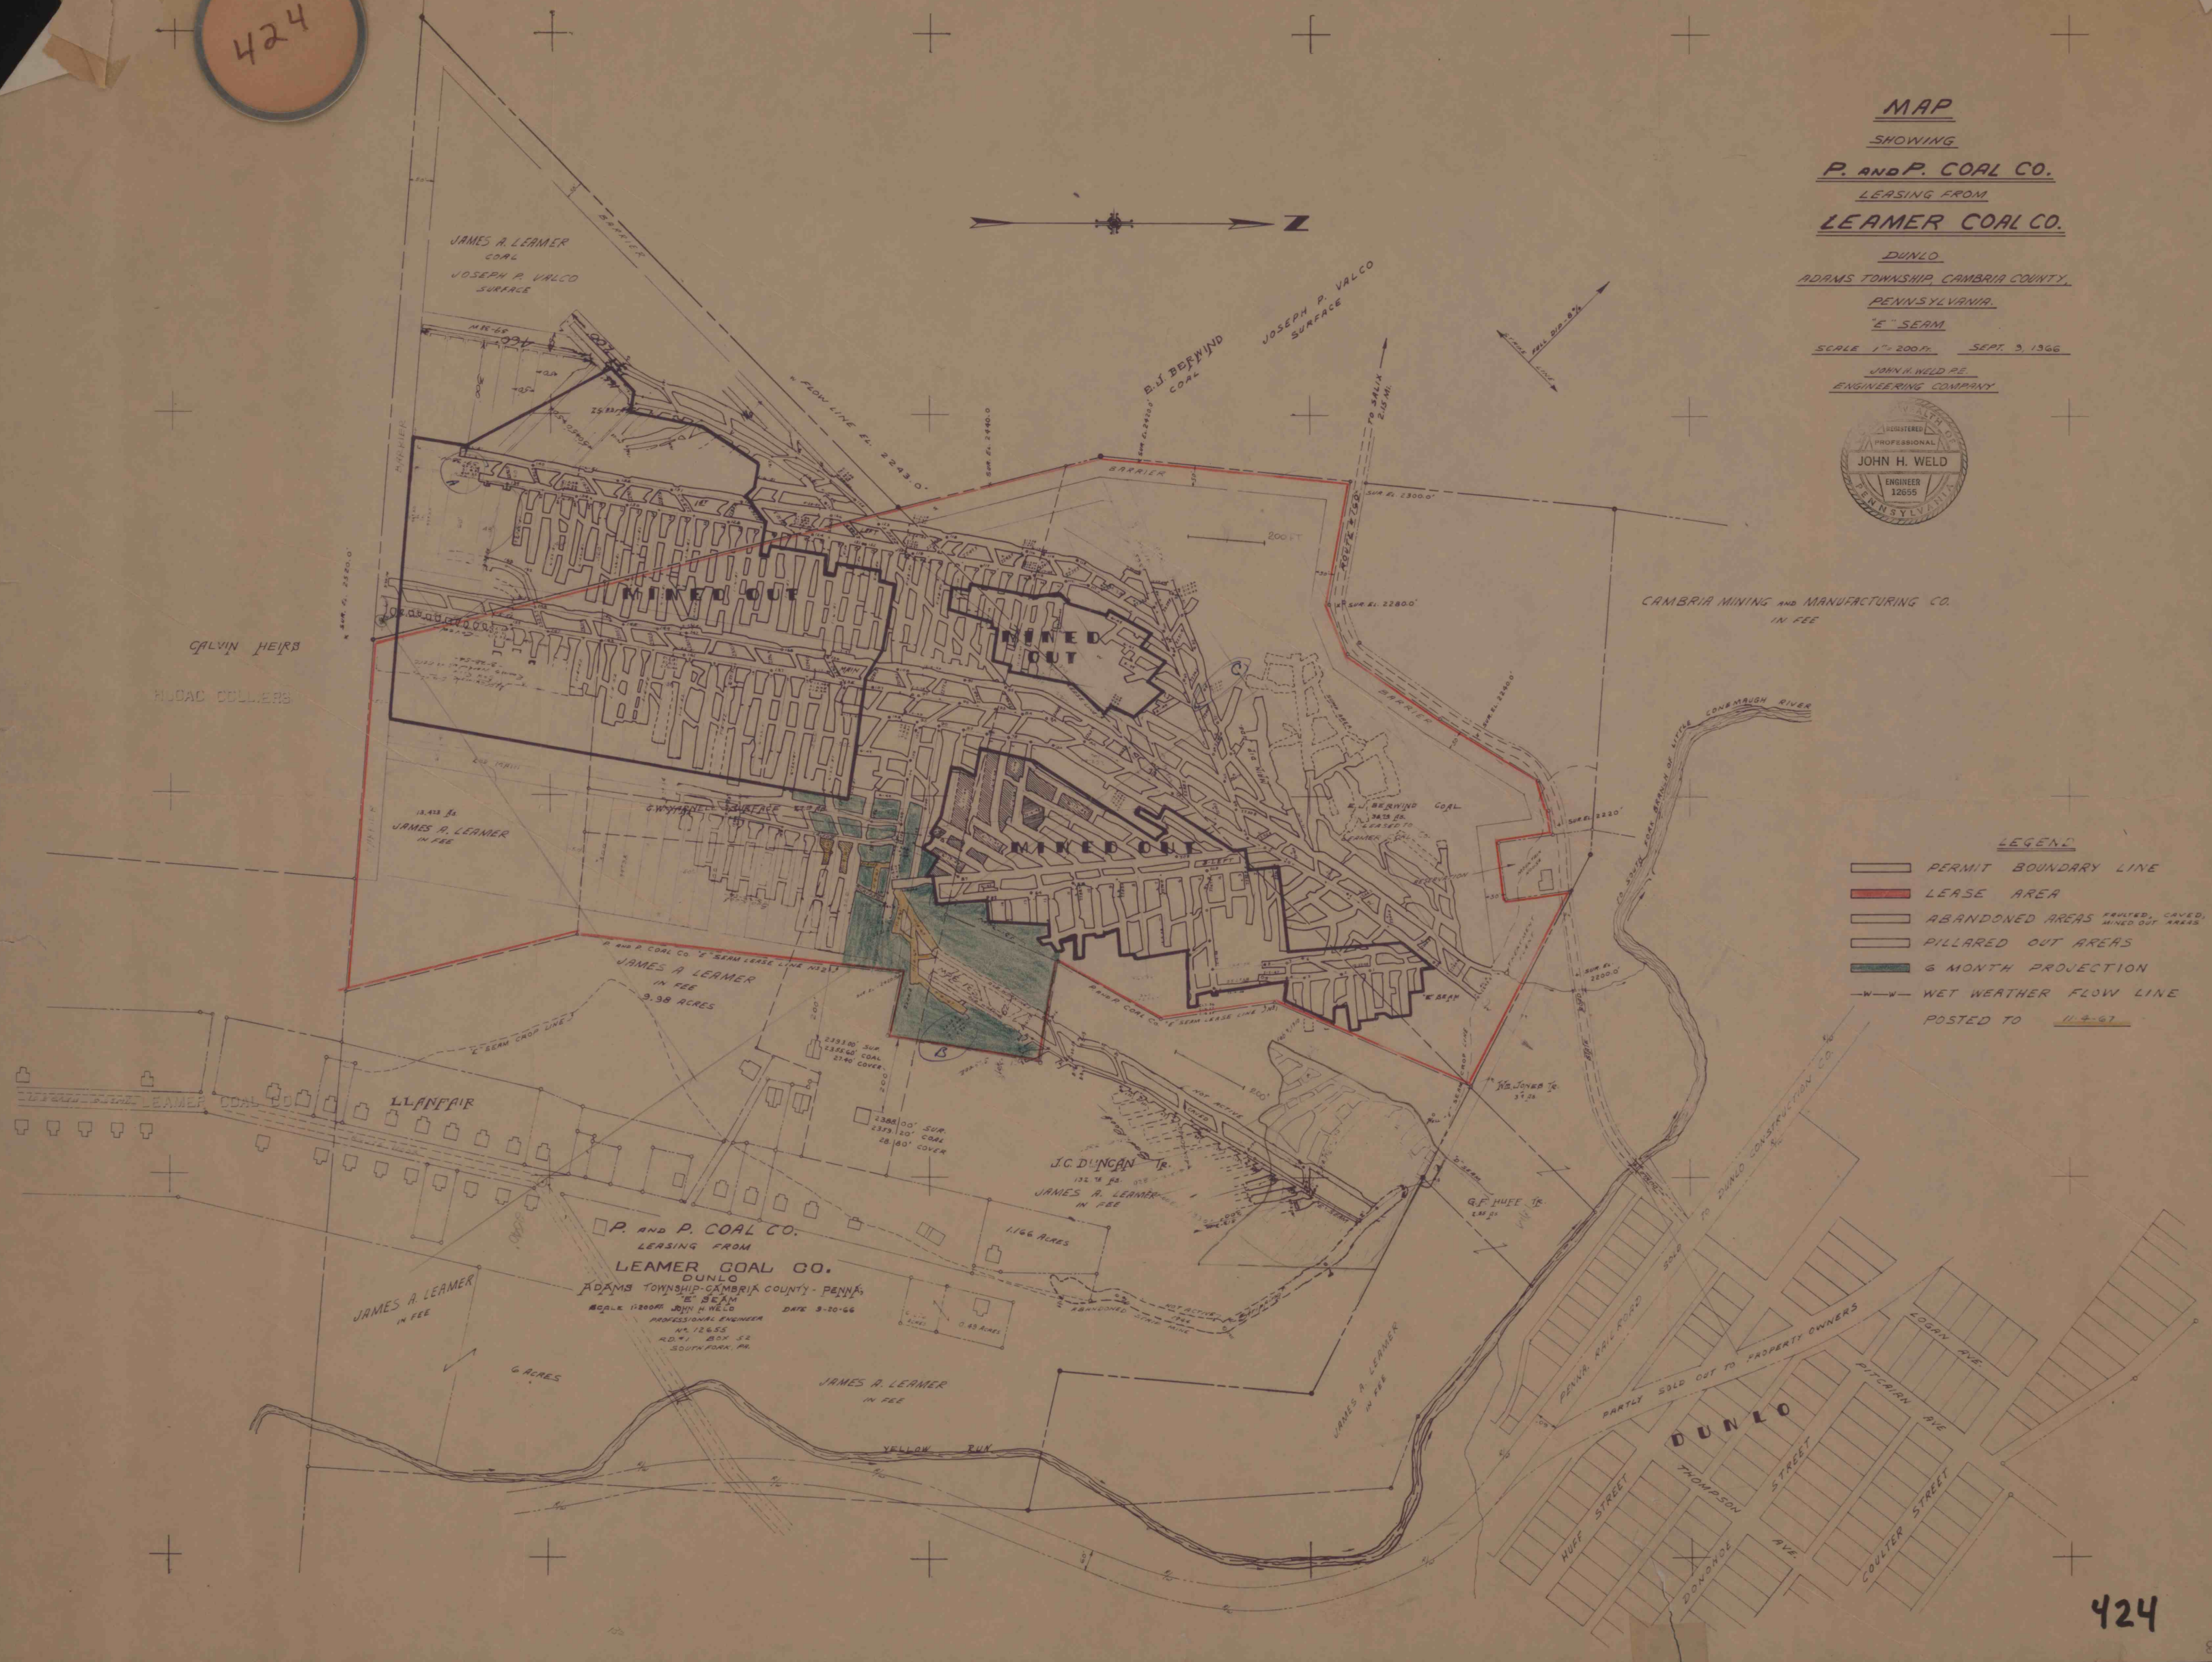

424