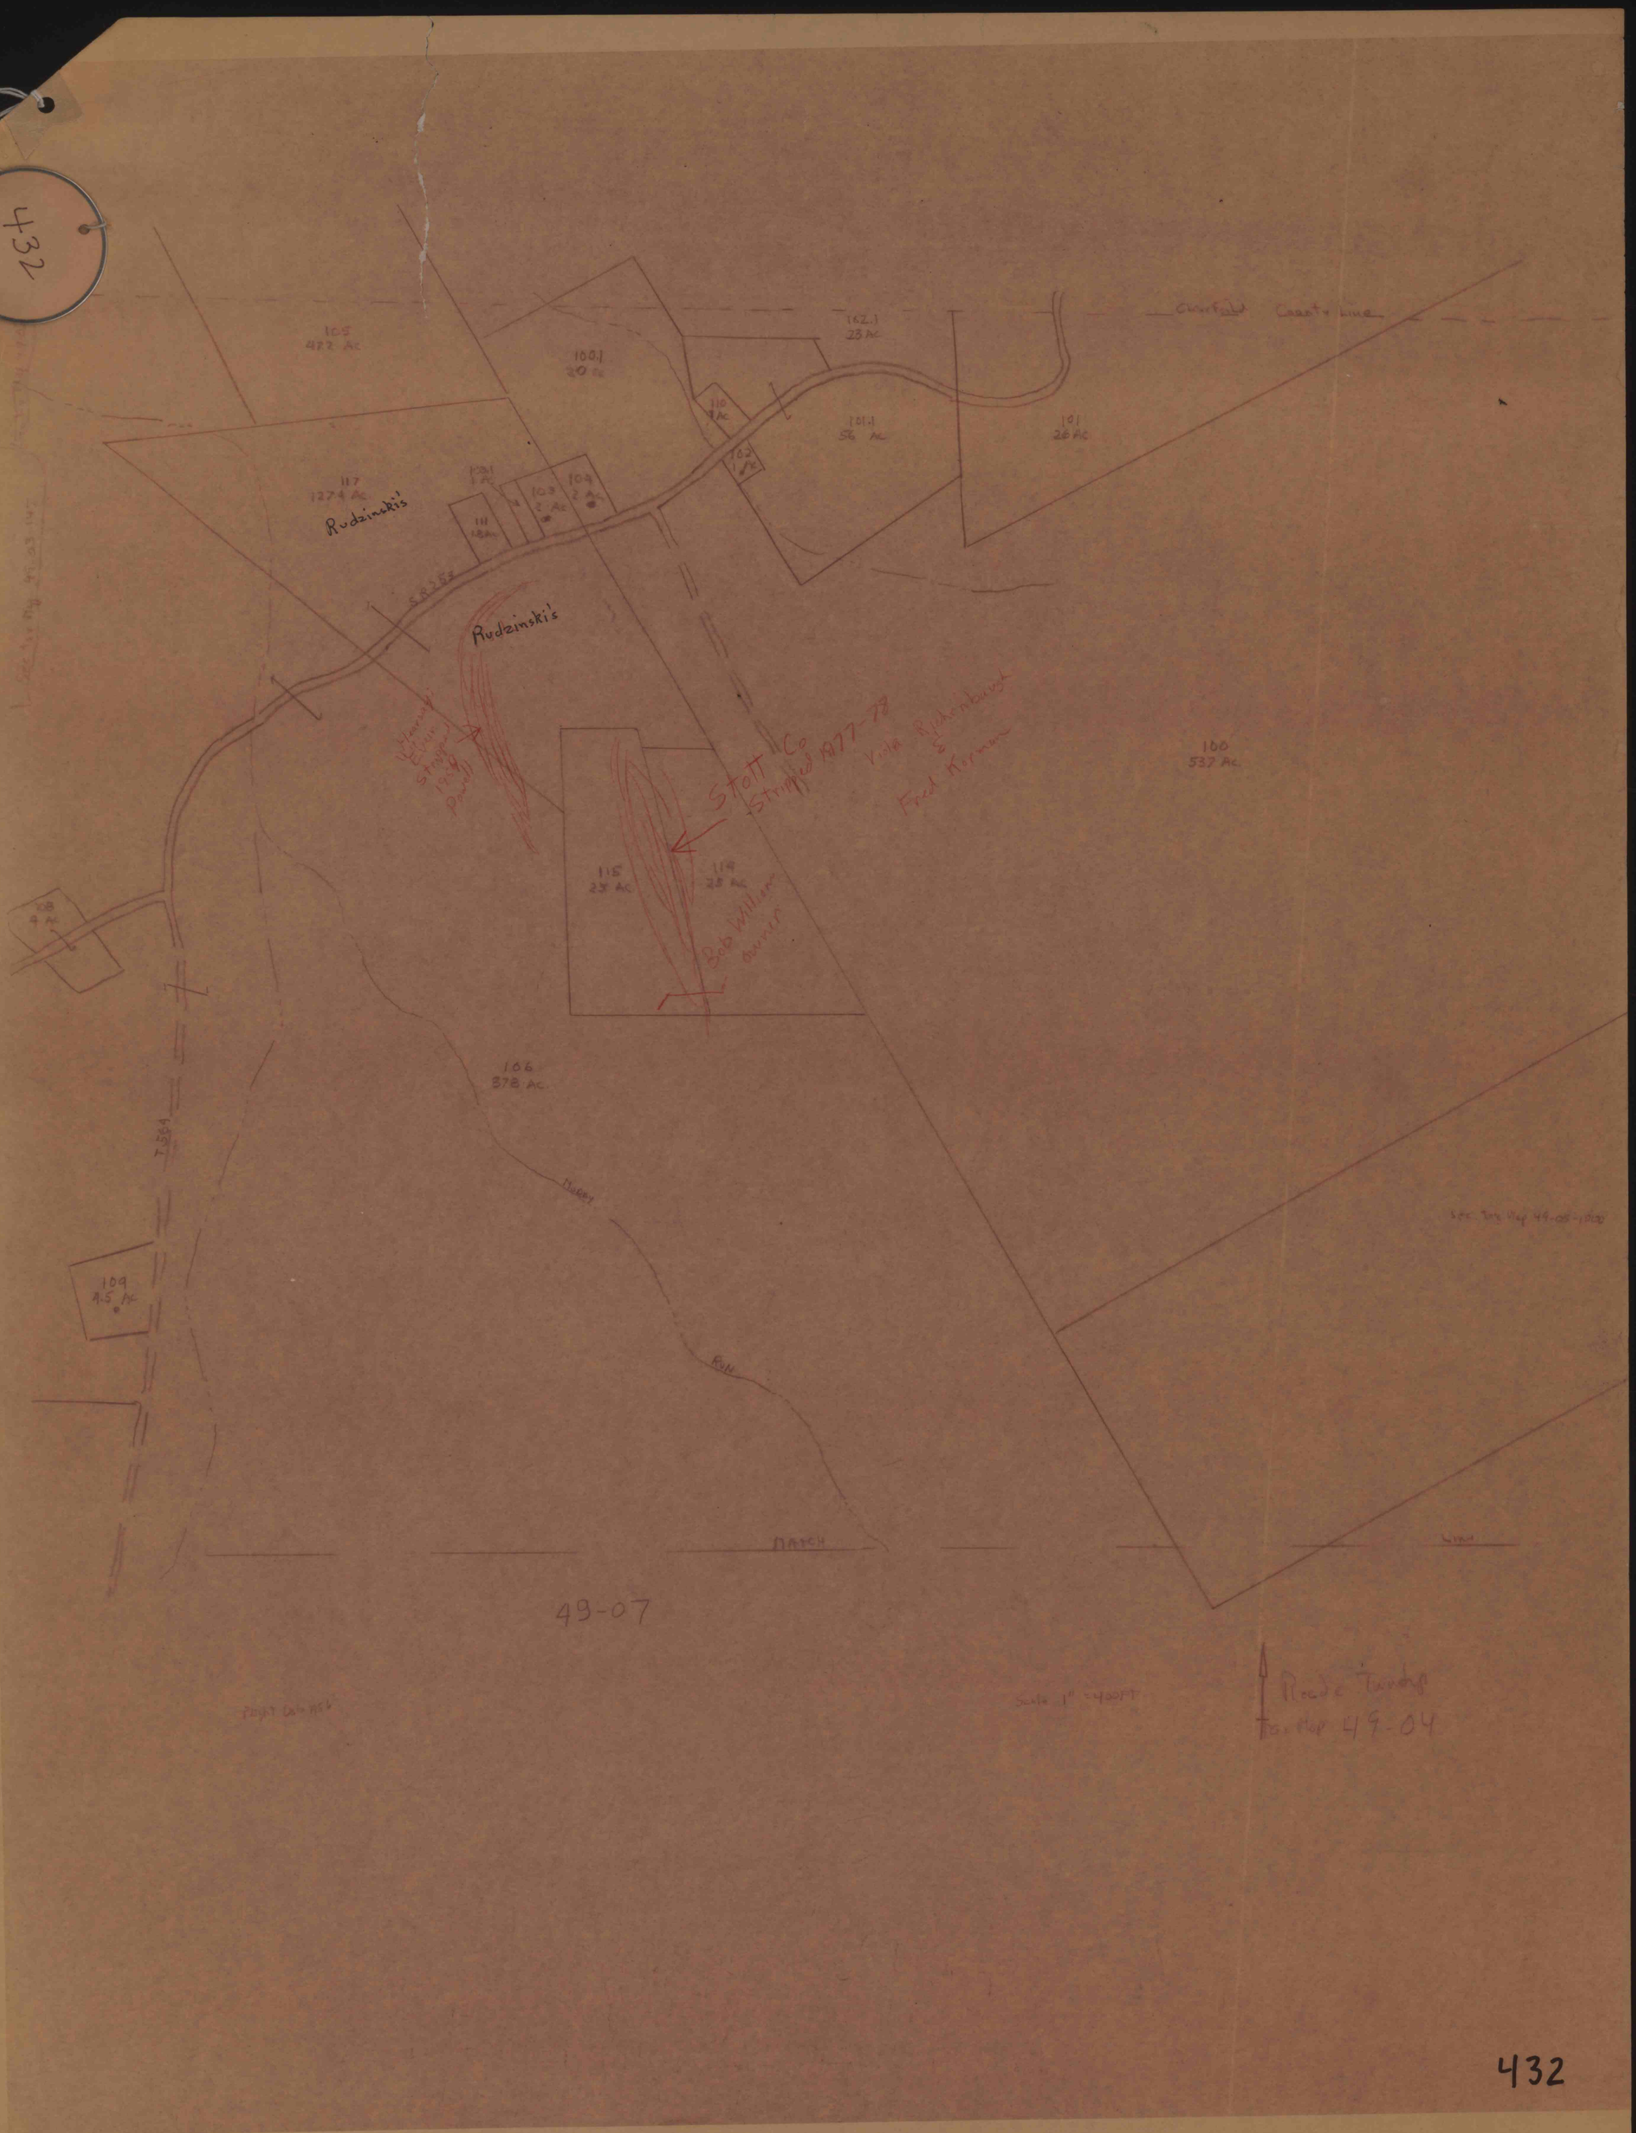
432
Rudzinski's
Rudzinski's
Stott Co
Stripped A77-78
Title Rutherford
Fred Kerman
Bob Williams
owner
115
23 Ac
119
28 Ac
106
378 Ac
100
537 Ac
49-07
Route Taxlot
Tax Map 49-04
432