



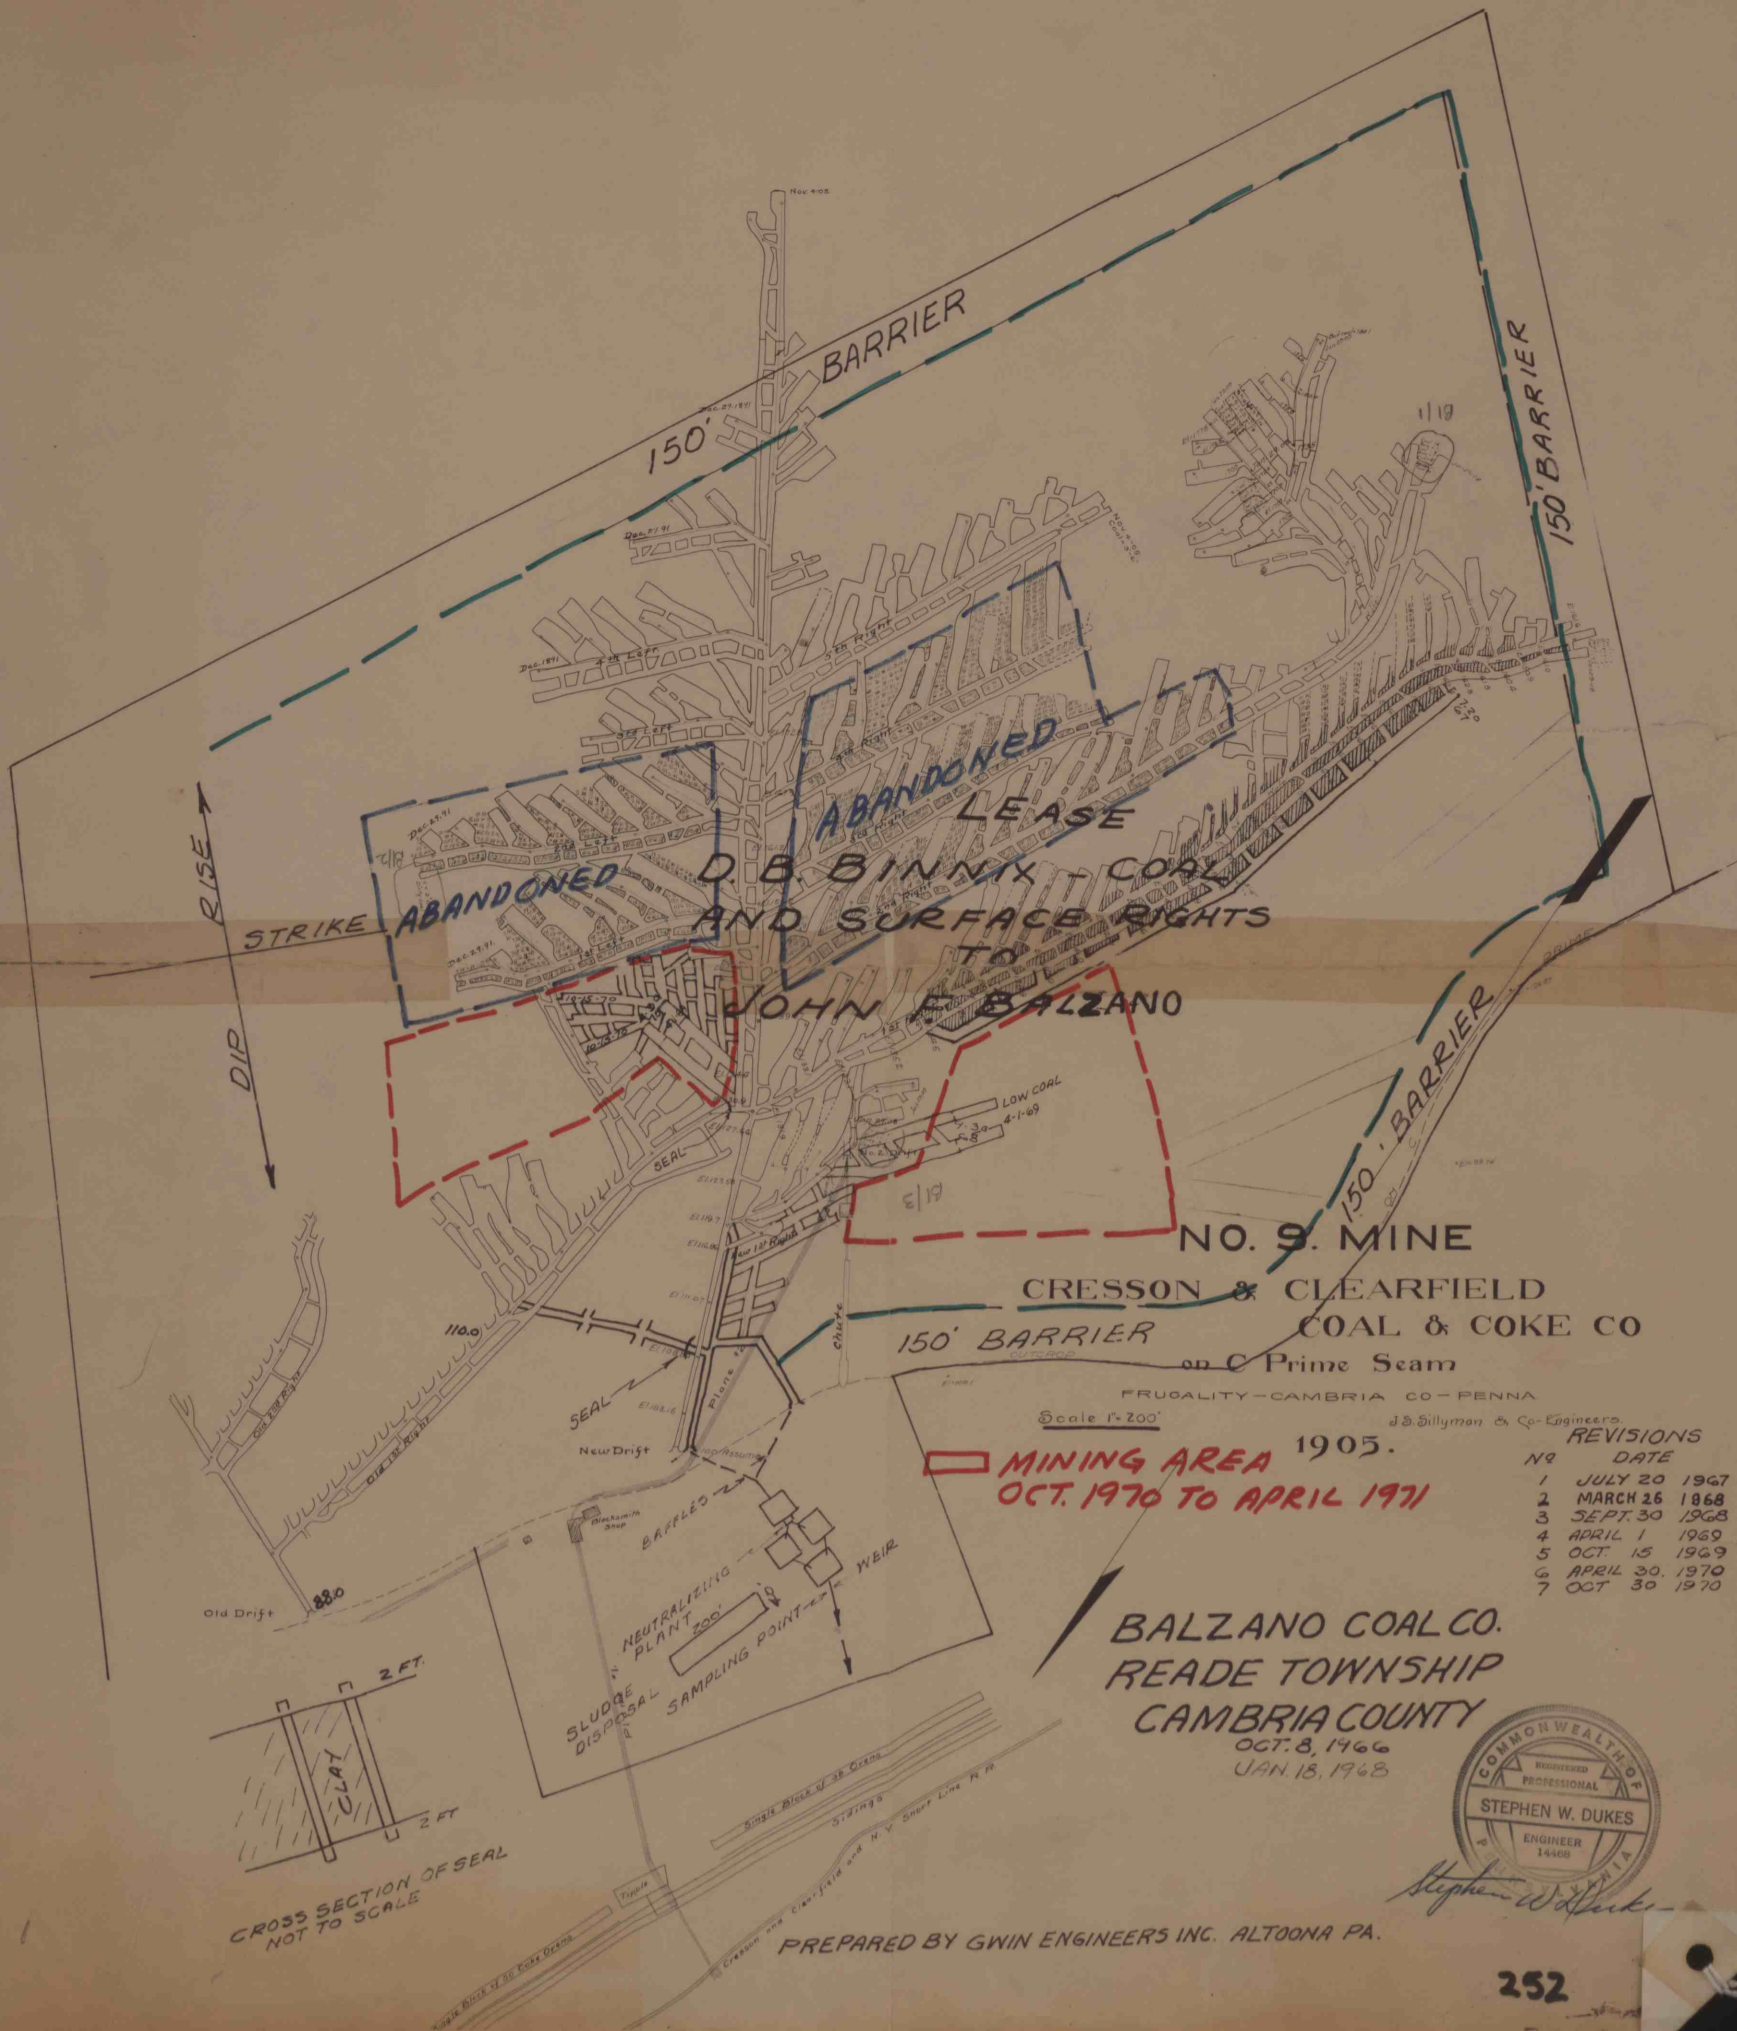

MINING AREA 1905.
OCT. 1970 TO APRIL 1971

REVISIONS	
Nº	DATE
1	JULY 20 1967
2	MARCH 26 1968
3	SEPT 30 1968
4	APRIL 1 1969
5	OCT. 15 1969
6	APRIL 30. 1970
7	OCT 30 1970

BALZANO COAL CO.
READE TOWNSHIP
CAMBRIA COUNTY
 OCT. 8, 1966
 JAN. 18, 1968

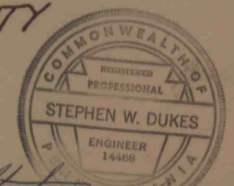

PREPARED BY GWIN ENGINEERS INC. ALTOONA PA.