


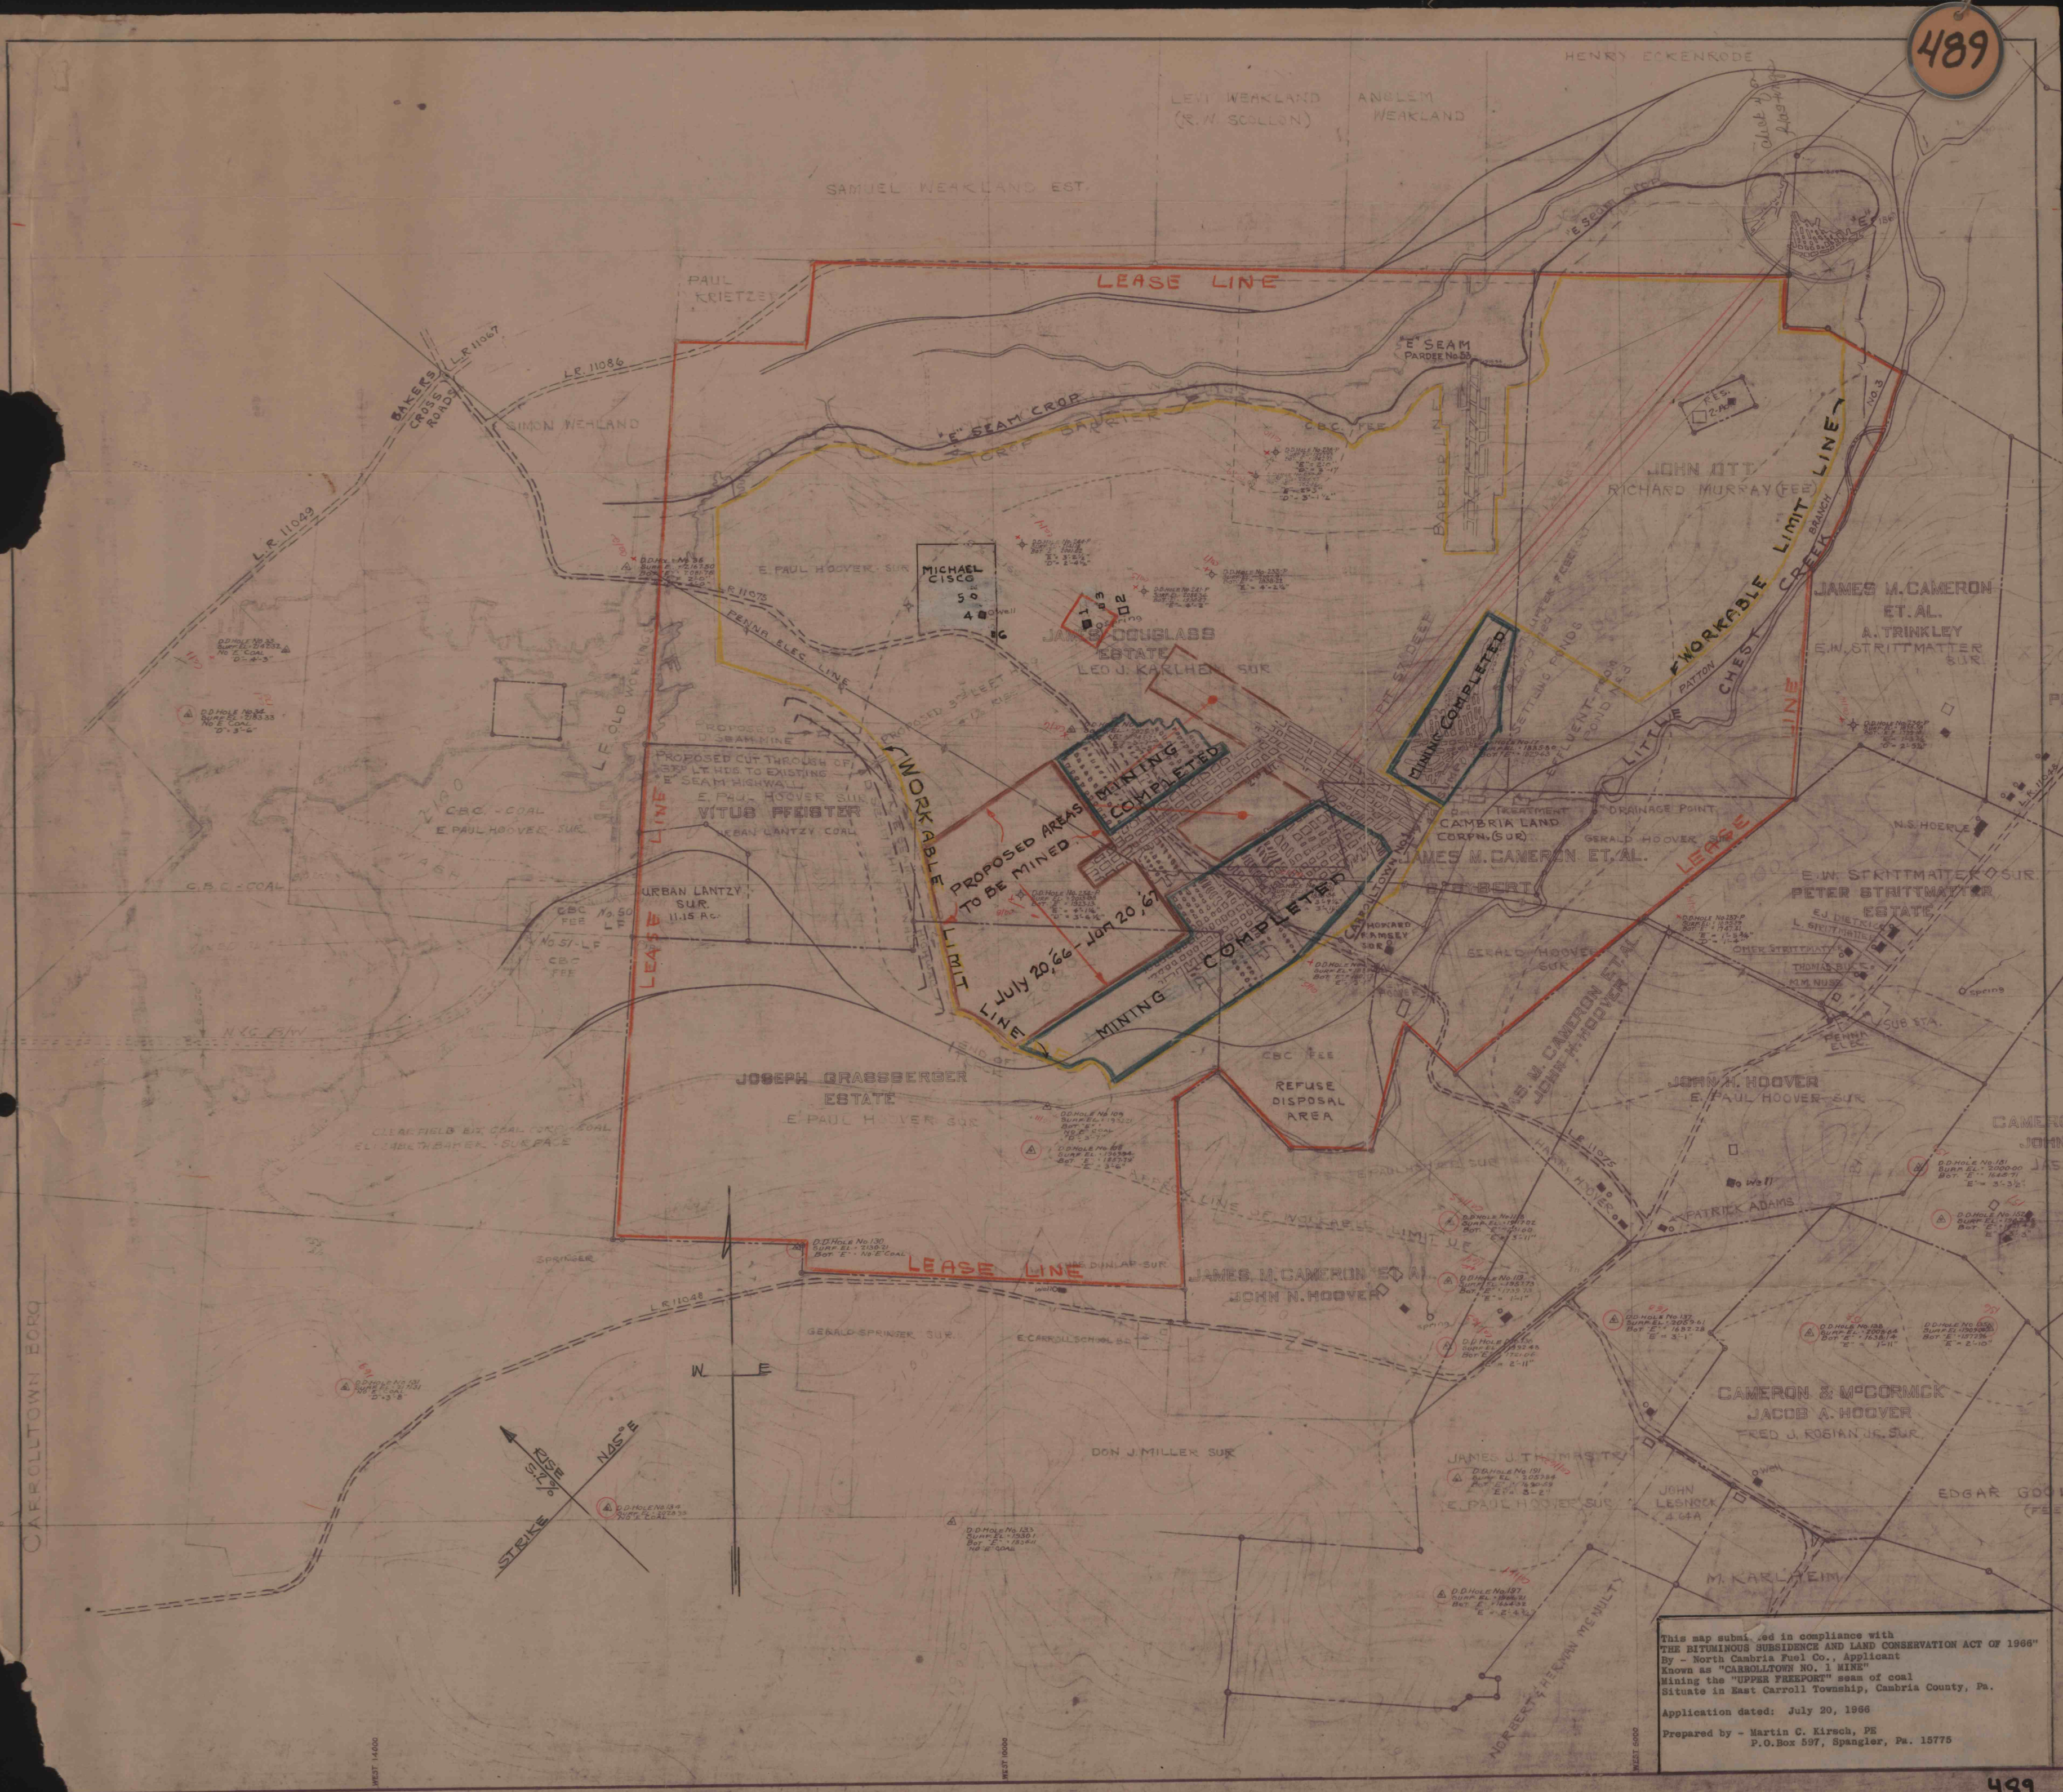

This map submitted in compliance with
By - North Cambria Fuel Co., Applicant
Known as "CARROLLTOWN NO. 1 MINE"
Mining the "UPPER FREEPORT" seam of coal
Situate in East Carroll Township, Cambria County, Pa.
Prepared by - Martin C. Kirsch, PE
P.O. Box 597, Spangler, Pa. 15775