


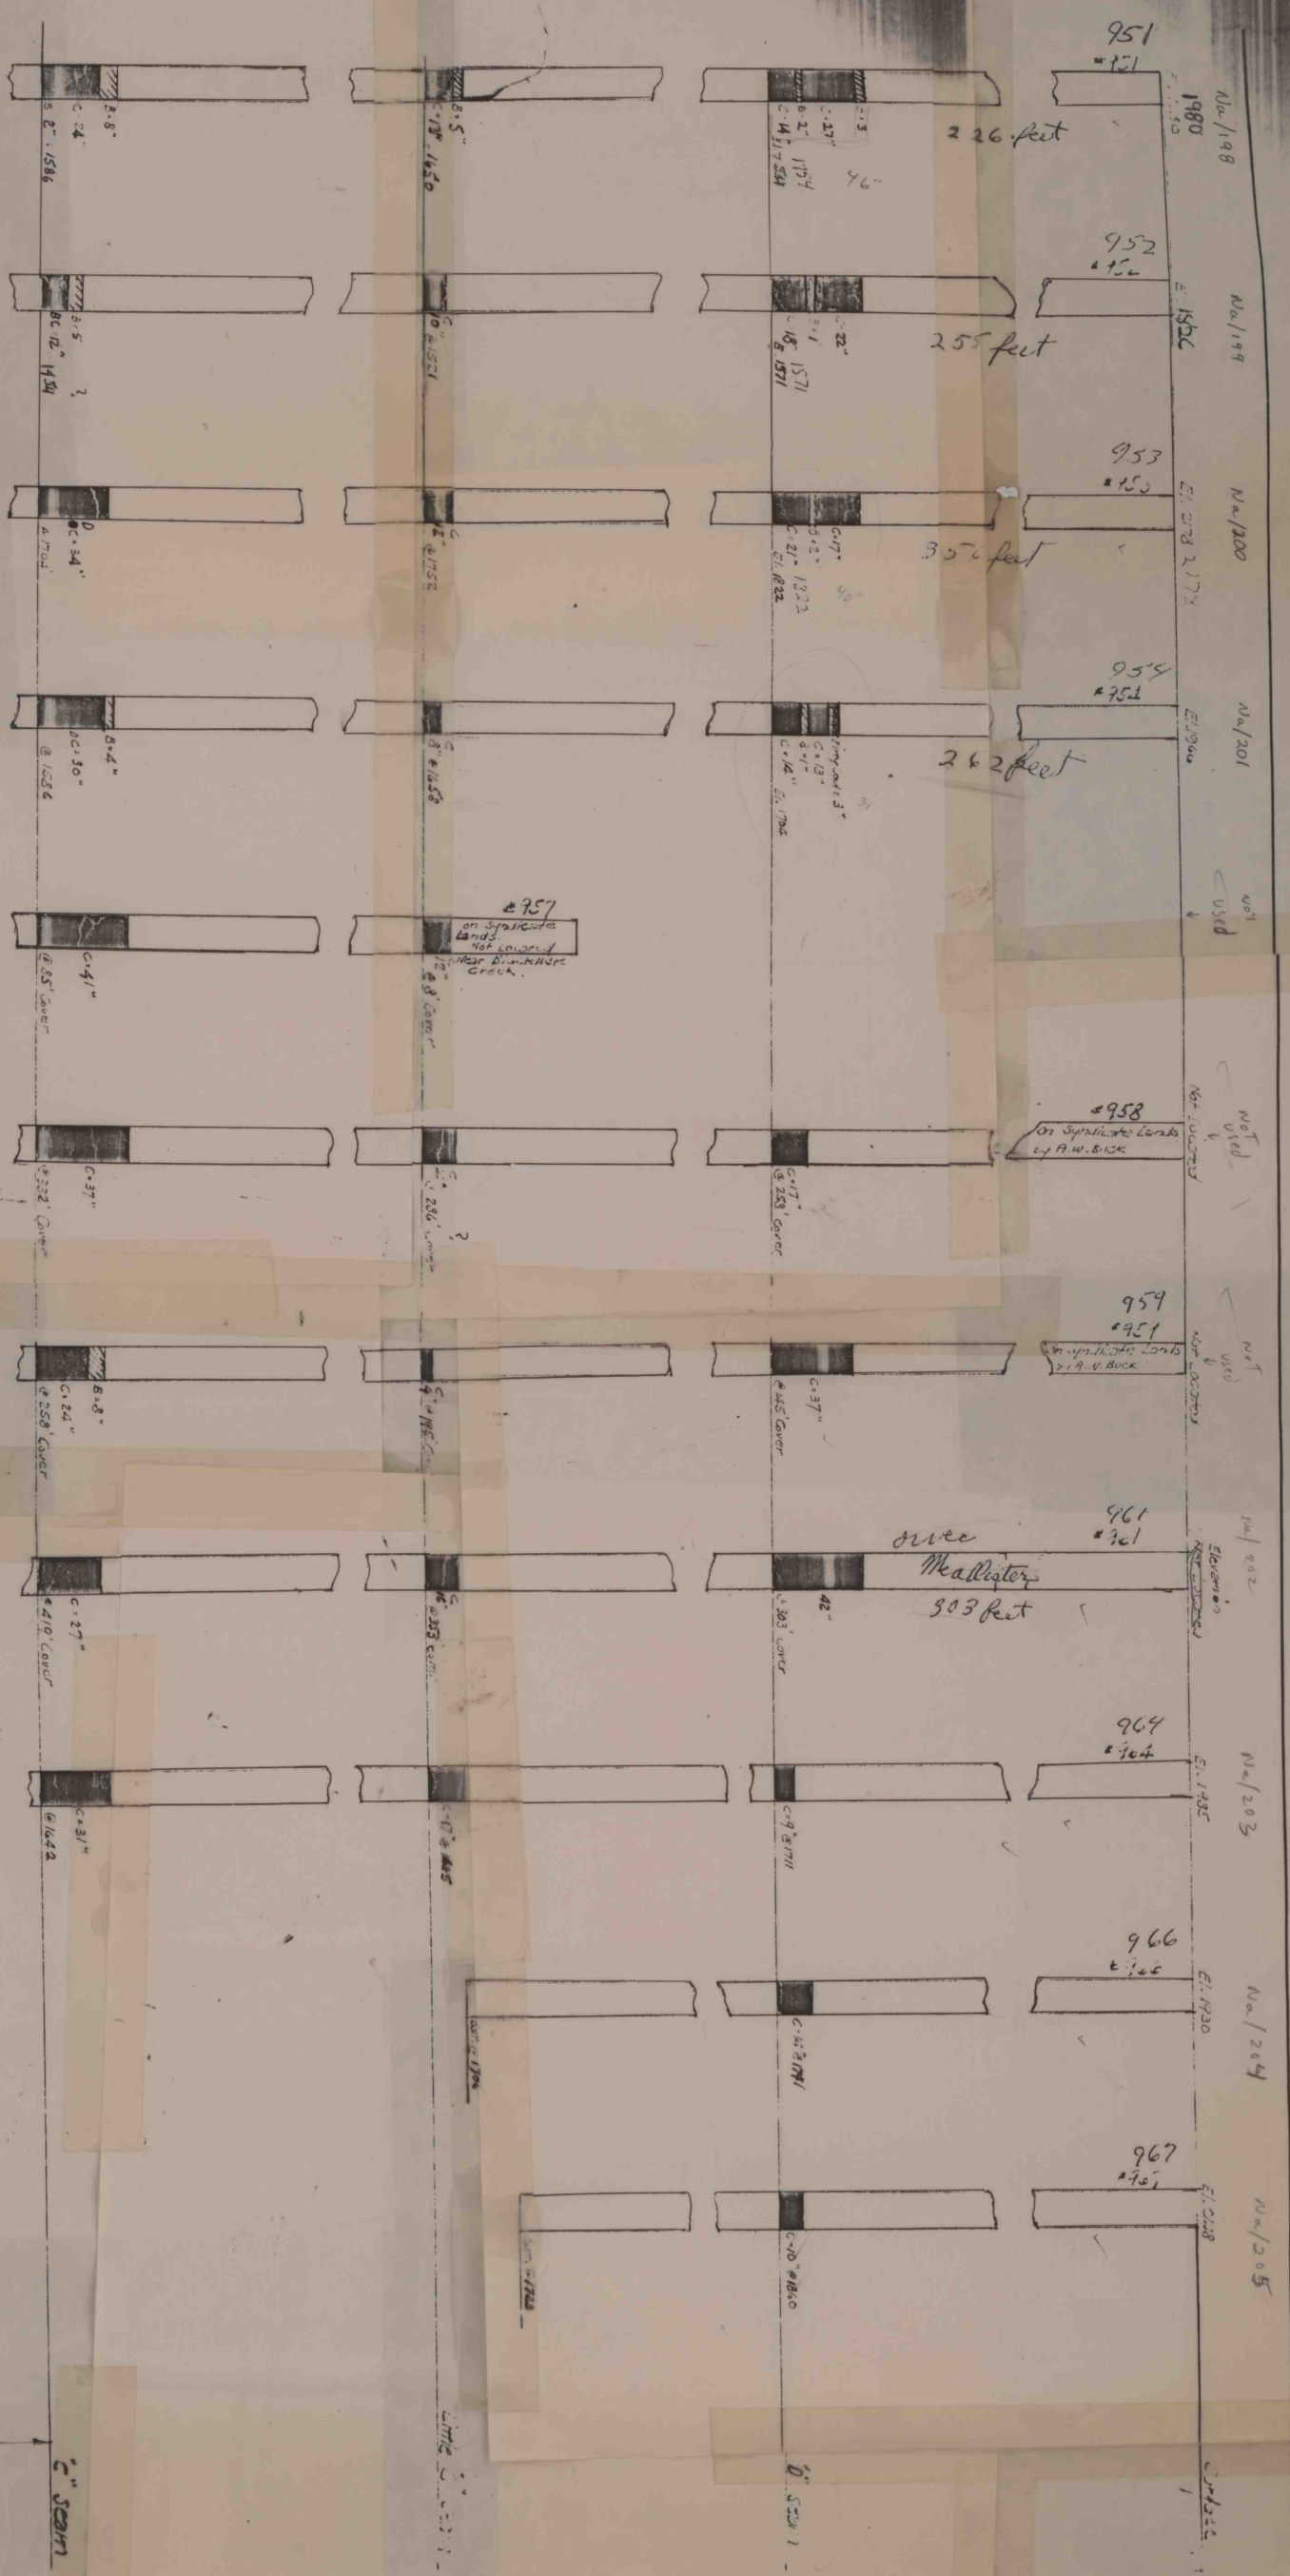

NOTE -
 B. Bony Coal
 D.C. Dirty Coal
 D.C. 30\"/>

30' 11\"/>