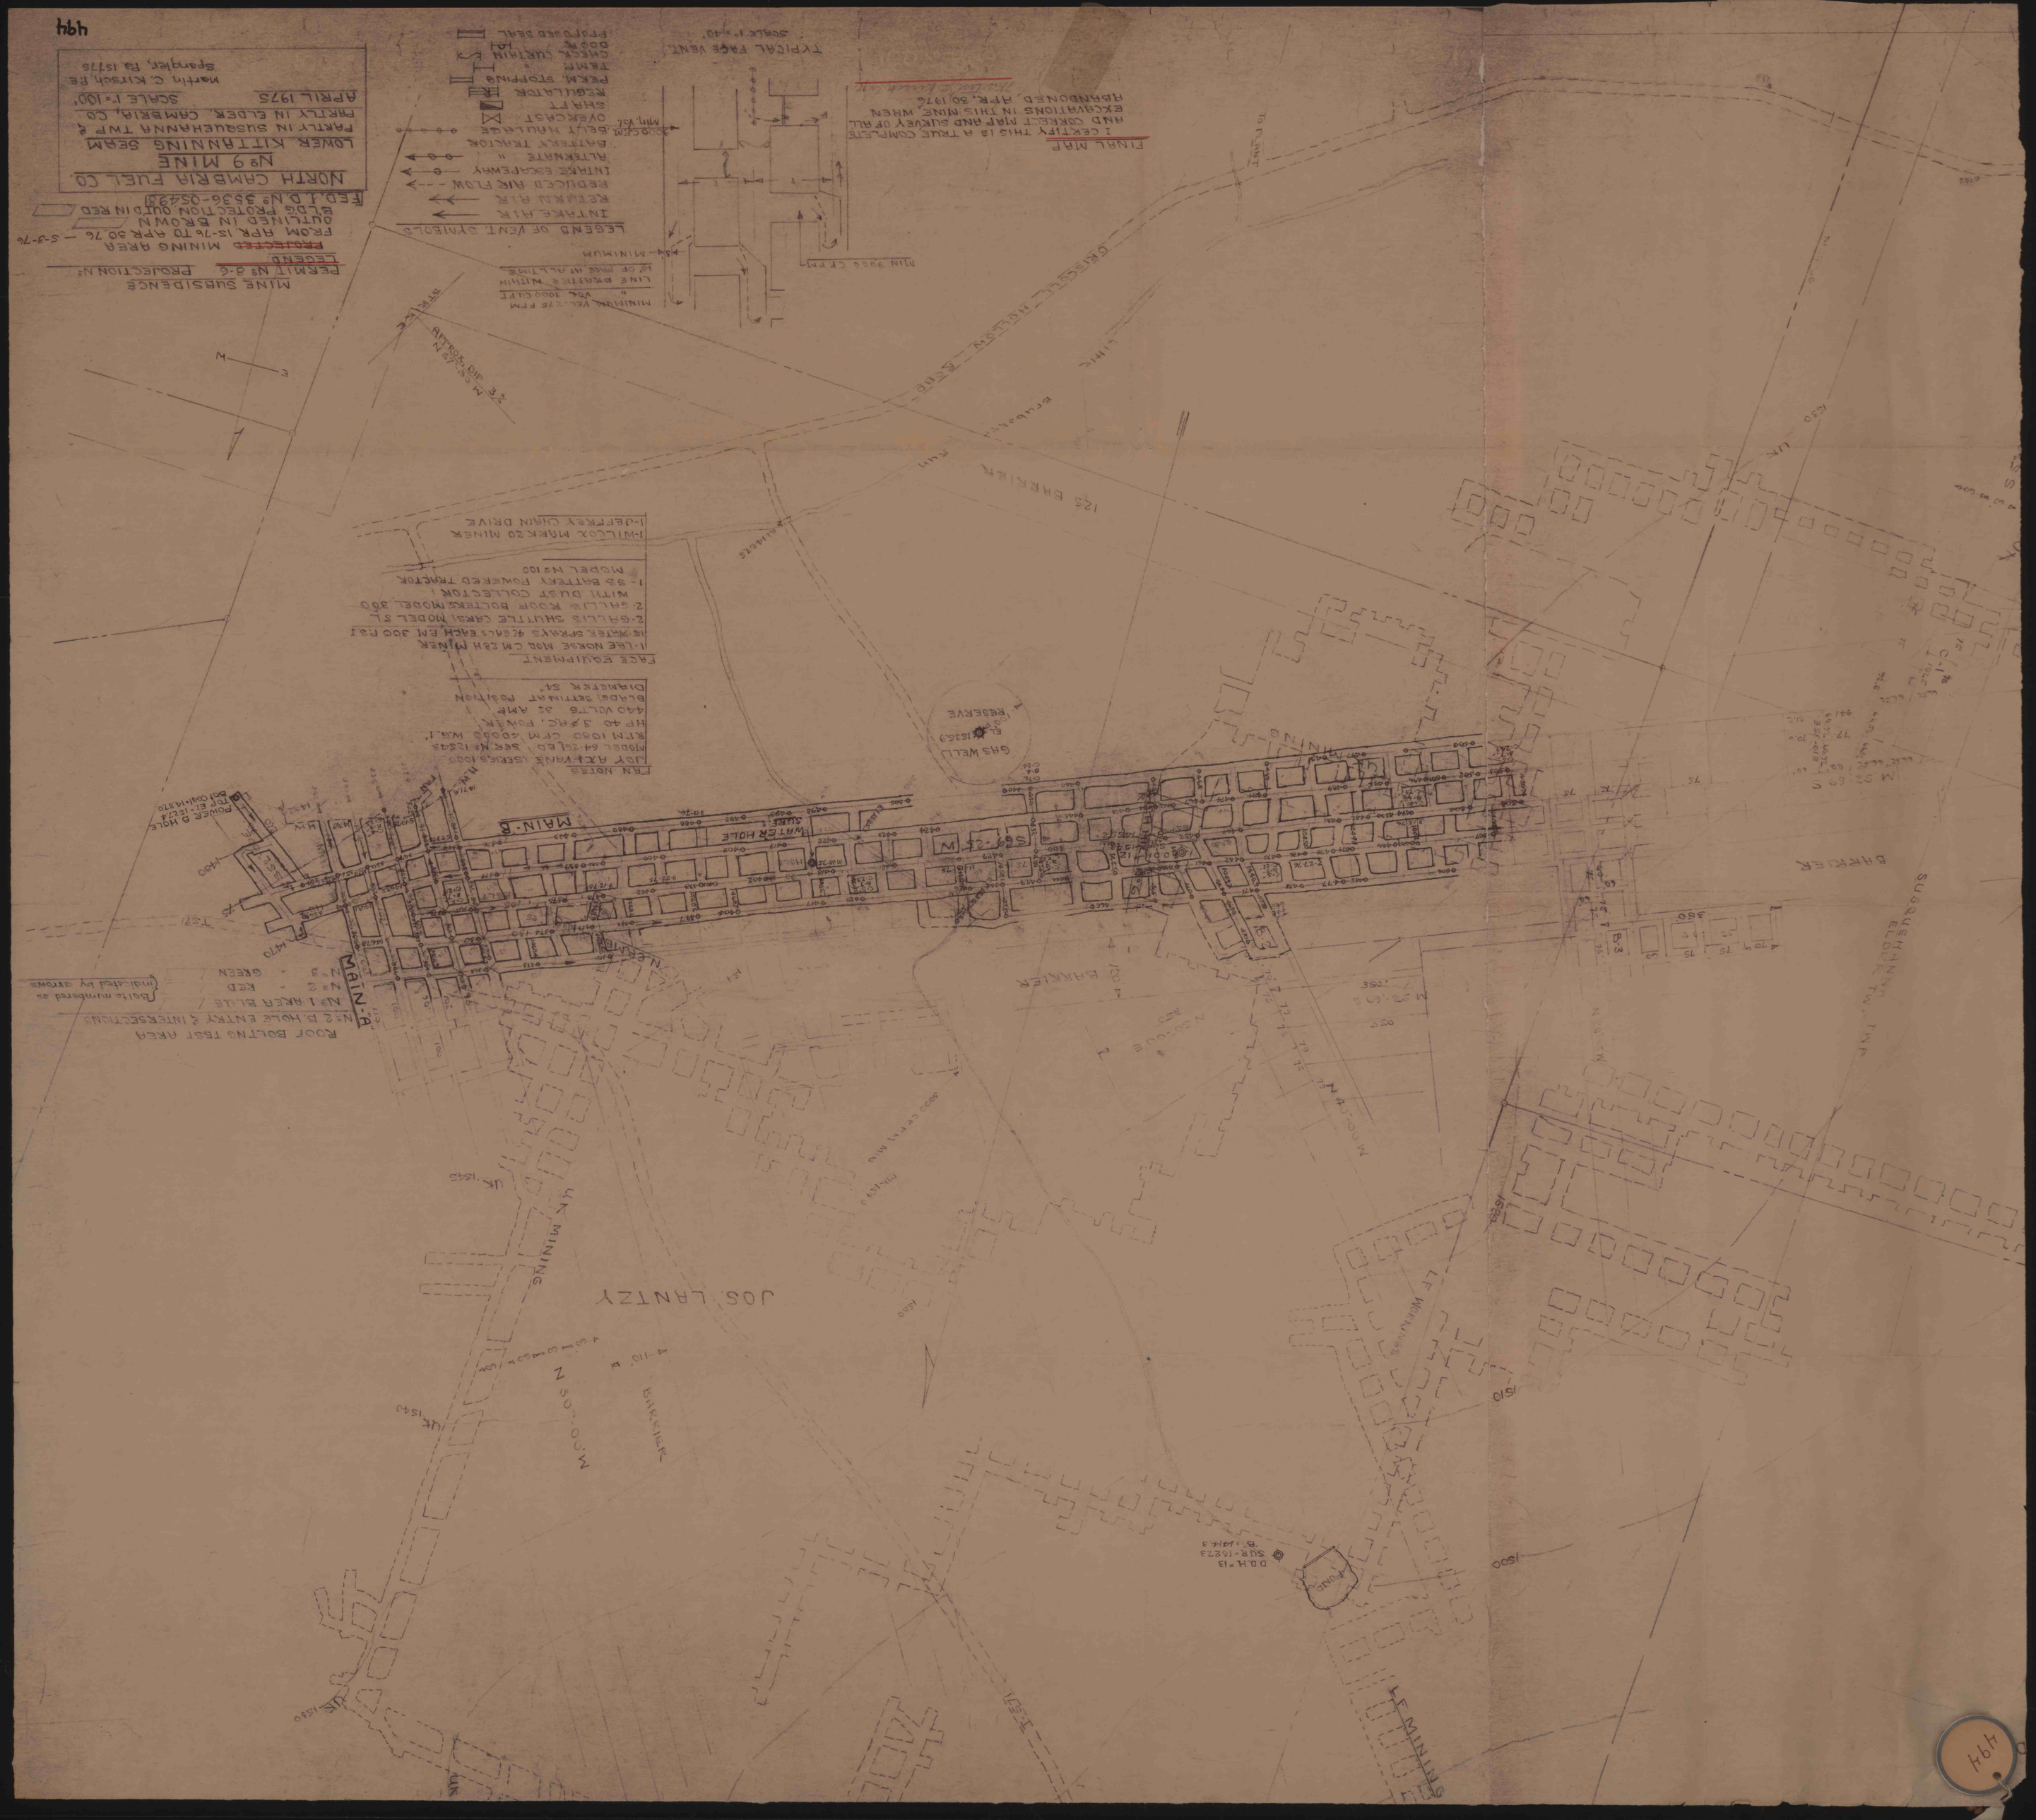
NORTH CAMBRIA FUEL CO.
Nº 9 MINE
LOWER KITTANNING SEAM
PARTLY IN SUSQUEHANNA TWP &
PARTLY IN ELDER, CAMBRIA, CO
APRIL 1975
SCALE 1" = 100'
Martin C. Kirsch, PE
Spangler, Pa 15775
MINE SUBSIDENCE
PERMIT Nº 3-6
PROJECTION Nº
LEGEND
PROJECTED MINING AREA
FROM APR. 15-76 TO APR 30 76 — 5-3-76
OUTLINED IN BROWN
BLDG PROTECTION OUTLINE IN RED
FED. I.D. Nº 3536-05493
LEGEND OF VENT SYMBOLS
INTAKE AIR
RETURN AIR
REDUCED AIR FLOW
INTAKE ESCAPEWAY
ALTERNATE "
BATTERY TRACTOR
OVERCAST
REGULATOR
SHAFT
PERM. STOPPING
TEMP. "
CHECK CURTAIN
DOOR
PROPOSED SEAL
TYPICAL FACE VENT.
SCALE 1" = 40'
FINAL MAP
I CERTIFY THIS IS A TRUE COMPLETE AND CORRECT MAP AND SURVEY OF ALL EXCAVATIONS IN THIS MINE, WHEN ABANDONED, APR. 30, 1976
FAN NOTES
JOY AXIVANE (SERIES 1000)
MODEL 64-26LBD, SER Nº 12343
RPM 1080 CFM 40000 W.G.
HP 40 3 PHASE POWER
440 VOLTS 32 AMP
BLADE SETTING AT POSITION
DIAMETER 54"
FACE EQUIPMENT
1-LEE NORSE MOD CM 28H MINER
12-WATER SPRAYS 42 GALS EACH EM 300 FSI
2-GALLIS SHUTTLE CARS MODEL 5L
2-GALLIS ROOF BOLTERS MODEL 300
WITH DUST COLLECTOR
1-55 BATTERY POWERED TRACTOR
MODEL Nº 100
1-WILCOX MARK 20 MINER
1-JEFFREY CHAIN DRIVE
ROOF BOLTING TEST AREA
Nº 2 P. HOLE ENTRY & INTERSECTIONS
Nº 1 AREA BLUE
Nº 2 " RED
Nº 3 " GREEN
(Points numbered as indicated by arrows)
MAIN
MAIN-B
WATER HOLE
SURF.
S69°-21'W
GAS WELL
ELEV. 1343.3
RESERVE
POWER & HOLE
TOP ELV. 1527.4
BOT COAL 1418.70
JOS. LANTZY
UK MINING
UK 1545
UK 1540
UK 1530
N 80°-00' W
BARRIER
N 20°-00' E
N 20°-00' W
BARRIER
LF MINING
LF 1510
LF 1500
LF 1550
TEST
DDH-13
SUR-16273
B. 1414.3
POND
125 BARRIER
RUN
Bruballa
GROSSETT HIGHWAY - RTE
TO PLANT
SUSQUEHANNA TWP
BARRIER
N 32°-00' E
S 32°-00' W
N 32°-00' E
N 20°-00' E
N 20°-00' W
MINIMUM VEL. 675 FPM
" VOL 3000 CFM
LINE BRATTICE WITHIN 10' OF FACE AT ALL TIMES
MIN 3000 CFM
MIN. 50'
APPROX. DIP N 65°-00' W 3%
STRIKE
E
W
1400
1410
